

WW-7
8-30-06



West Virginia Department of Environmental Protection
Office of Oil and Gas
WELL LOCATION FORM: GPS

API: 47-033-05201-00 WELL NO.: McKinley Unit 4H

FARM NAME: Davis, Michael & Barbara

RESPONSIBLE PARTY NAME: Antero Resources Corporation

COUNTY: Harrison DISTRICT: Union

QUADRANGLE: Big Isaac 7.5'

SURFACE OWNER: Michael & Barbara Davis

ROYALTY OWNER: E.J. Rightmire, et al

UTM GPS NORTHING: 4335666.26 *Converted UTM coordinates per Permitted Survey Plat

UTM GPS EASTING: 540073.10 GPS ELEVATION: 1281'

The Responsible Party named above has chosen to submit GPS coordinates in lieu of preparing a new well location plat for a plugging permit or assigned API number on the above well. The Office of Oil and Gas will not accept GPS coordinates that do not meet the following requirements:


- 1. Datum: NAD 1983, Zone: 17 North, Coordinate Units: meters, Altitude: height above mean sea level (MSL) – meters.
- 2. Accuracy to Datum – 3.05 meters
- 3. Data Collection Method:
Survey grade GPS x : Post Processed Differential X
Real-Time Differential _____
Mapping Grade GPS _____ : Post Processed Differential _____
Real-Time Differential _____

4. **Letter size copy of the topography map showing the well location.**
I the undersigned, hereby certify this data is correct to the best of my knowledge and belief and shows all the information required by law and the regulations issued and prescribed by the Office of Oil and Gas.

Ashlie Steele
Signature

Permitting Supervisor
Title

4/13/2015
Date

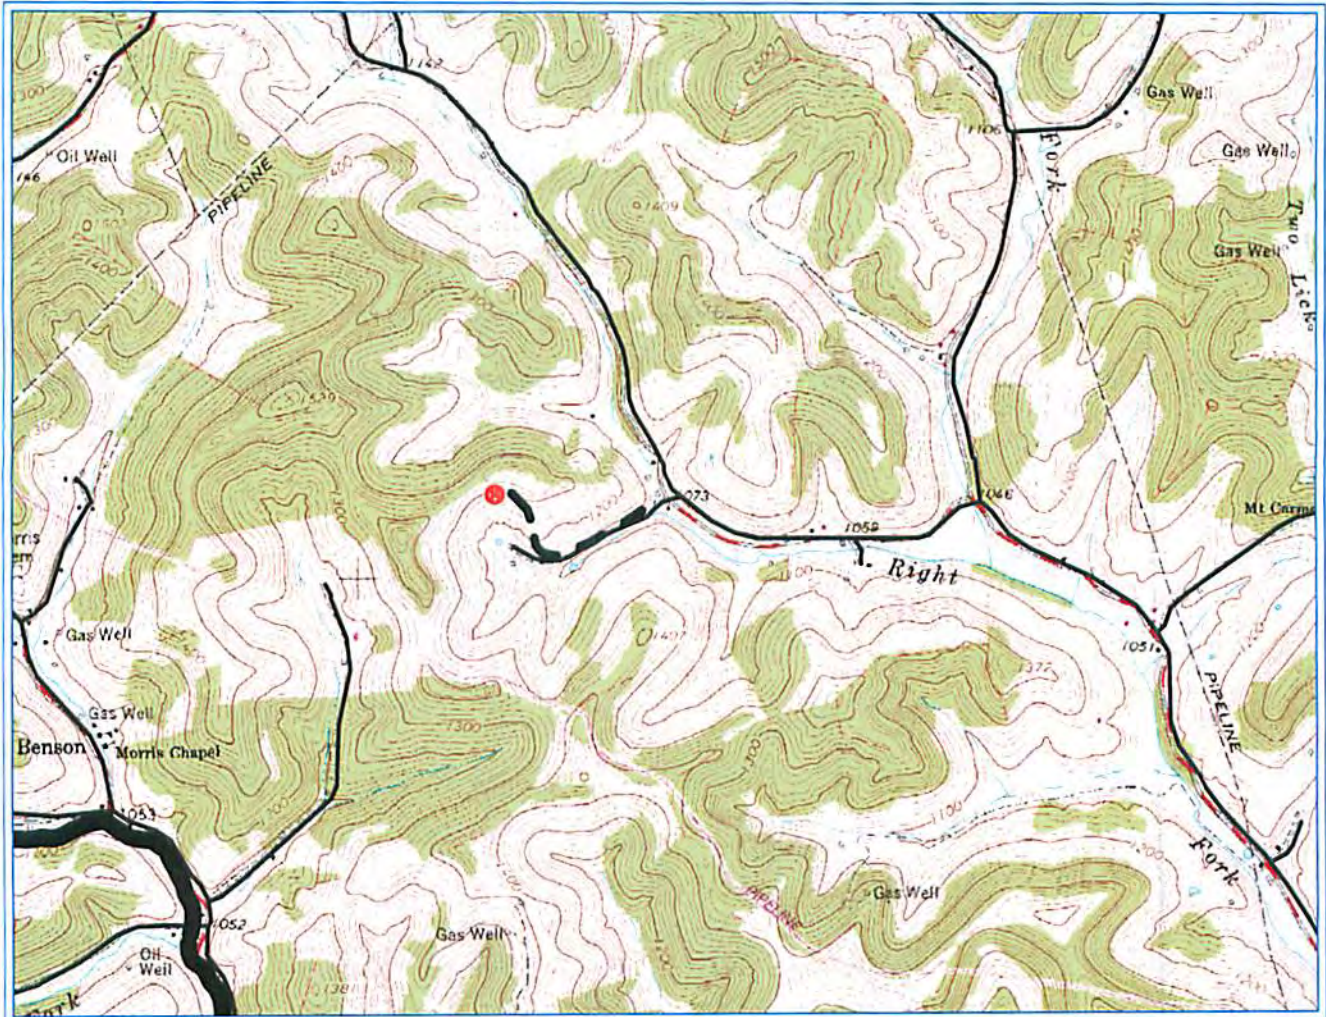

PFTRA 5/25/2010 11:15:42 AM

Received
Office of Oil & Gas
NOV 12 2014

Antero Resources Corporation
APPALACHIAN BASIN
McKinley Unit 4H
Harrison County
REMARKS QUADRANGLE: BIG ISAAC WATERSHED: KINCHELOE CREEK DISTRICT: UNION
January 9, 2009