



33-02-11

880'

LATITUDE 39°10'00"

LONGITUDE 80°25'00"

4,920'

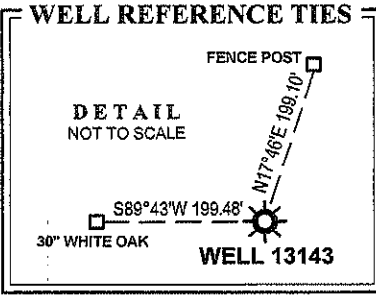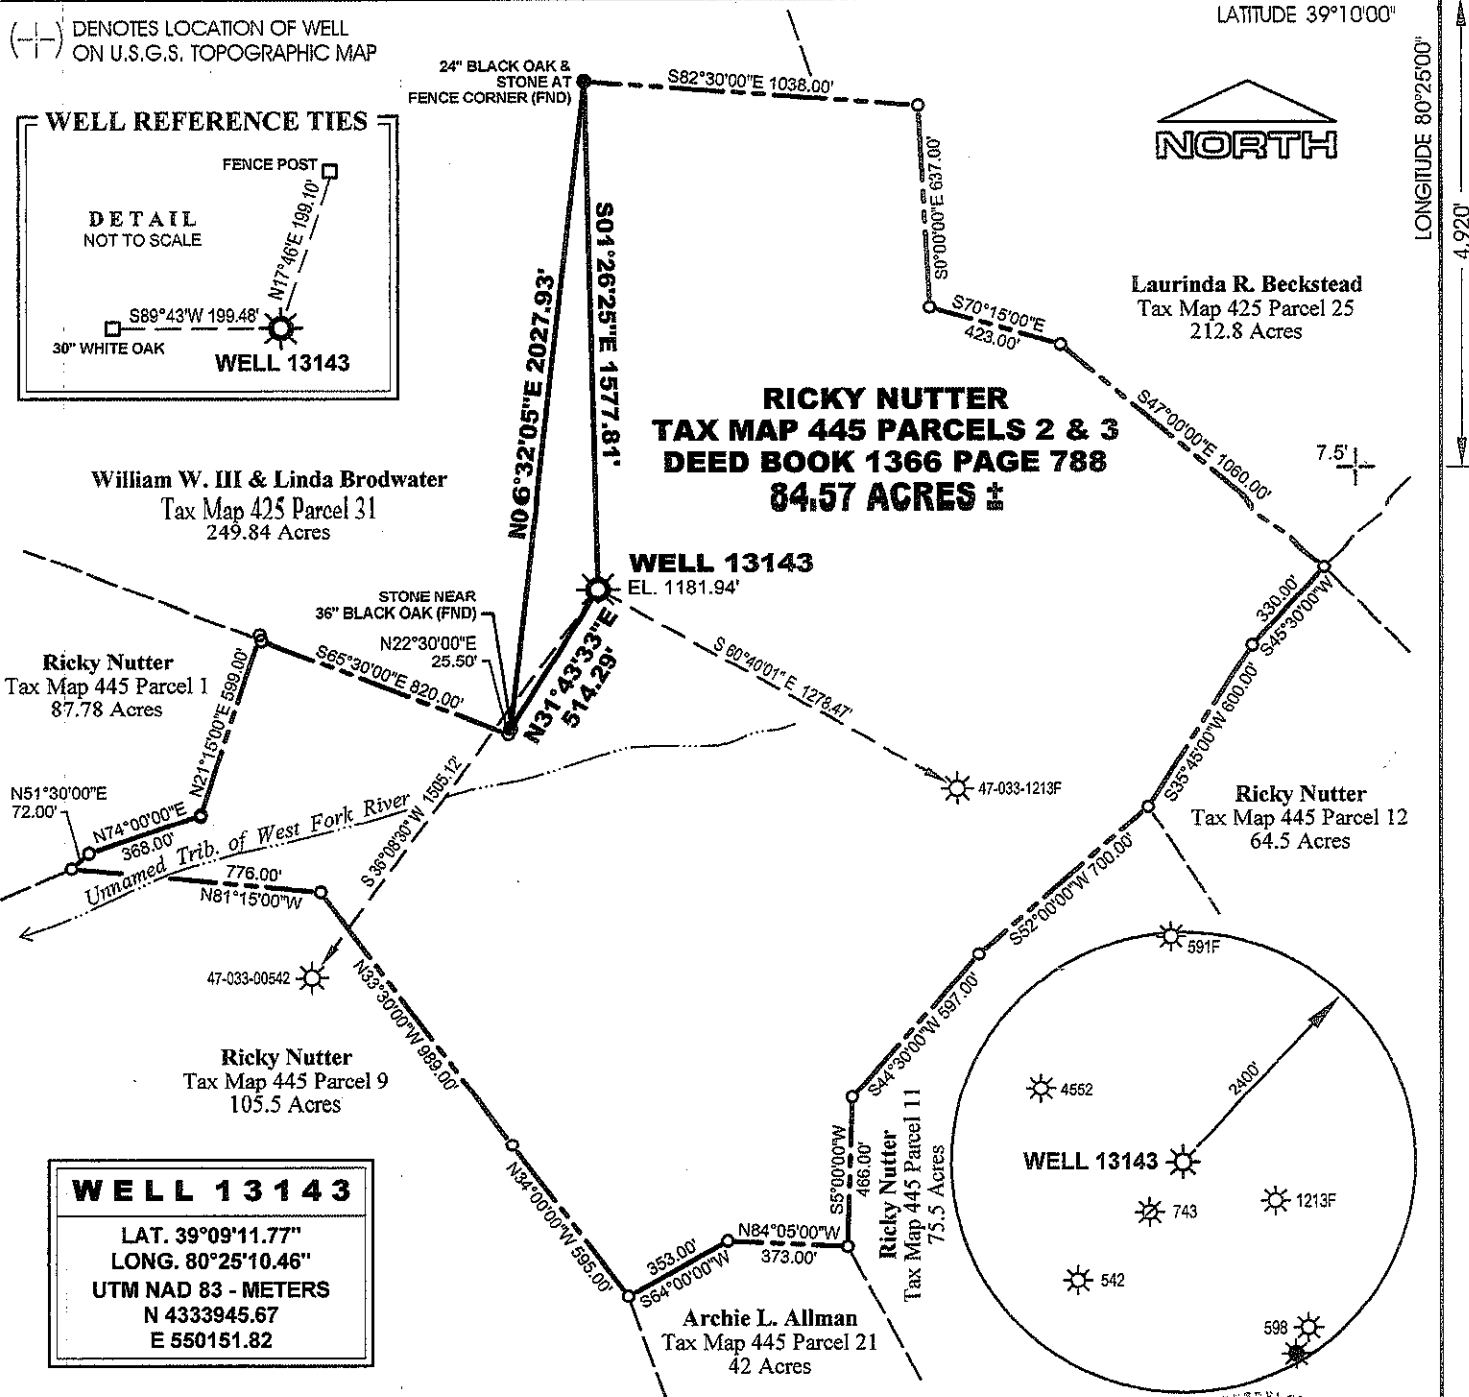

William W. III & Linda Brodwater
Tax Map 425 Parcel 31
249.84 Acres

RICKY NUTTER
TAX MAP 445 PARCELS 2 & 3
DEED BOOK 1366 PAGE 788
84.57 ACRES ±

Ricky Nutter
Tax Map 445 Parcel 1
87.78 Acres

Ricky Nutter
Tax Map 445 Parcel 9
105.5 Acres


Archie L. Allman
Tax Map 445 Parcel 11
42 Acres

Ricky Nutter
Tax Map 445 Parcel 12
64.5 Acres

WELL 13143
LAT. 39°09'11.77"
LONG. 80°25'10.46"
UTM NAD 83 - METERS
N 4333945.67
E 550151.82

MSES consultants, inc.
FILE NO. 11-596-Well13143-WellPlat
DRAWN BY HDW / MVS
SCALE 1" = 600'
MIN. DEGREE OF ACCURACY 1 IN 2500
PROVEN SOURCE OF ELEVATION:
DGPS (SUBMETER MAPPING GRADE)

I, THE UNDERSIGNED, HEREBY CERTIFY THAT THIS PLAT IS CORRECT TO THE BEST OF MY KNOWLEDGE AND BELIEF, AND THAT IT SHOWS ALL INFORMATION REQUIRED BY LAW AND REGULATIONS ISSUED AND PRESCRIBED BY THE DEPARTMENT OF MINES.
(SIGNED) Hershel D. Ward
R.P.E. _____ P.S. 995

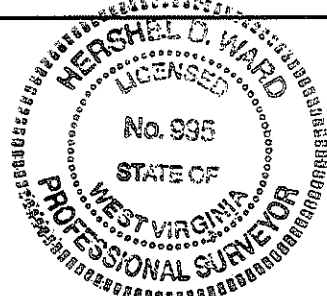

STATE OF WEST VIRGINIA
DEPARTMENT OF MINES
OIL AND GAS DIVISION



DATE FEBRUARY 9 20 12
OPERATOR'S WELL NO. 13143
API WELL NO. _____
47 **33** 05611
STATE COUNTY PERMIT NO.

WELL TYPE: OIL GAS LIQUID INJECTION WASTE DISPOSAL
IF "GAS", PRODUCTION STORAGE DEEP SHALLOW

LOCATION: ELEVATION 1181.94 WATERSHED UNNAMED TRIB. OF WEST FORK RIVER
DISTRICT GRANT COUNTY HARRISON
QUADRANGLE WEST MILFORD NEAREST TOWN GOOD HOPE
SURFACE OWNER RICKY NUTTER ACREAGE 84.57
OIL & GAS ROYALTY OWNER RICKY NUTTER, ET AL LEASE ACREAGE 800

LEASE NO. FK020606

PROPOSED WORK: DRILL CONVERT DRILL DEEPER REDRILL FRACTURE OR STIMULATE
PLUG OFF OLD FORMATION PERFORATE NEW FORMATION
OTHER PHYSICAL CHANGE IN WELL (SPECIFY) _____
PLUG AND ABANDON CLEAN OUT AND REPLUG



TARGET FORMATION BENSON ESTIMATED DEPTH 4,285'
WELL OPERATOR DOMINION TRANSMISSION, INC. DESIGNATED AGENT MR. JAMES D. BLASINGAME
ADDRESS 445 WEST MAIN STREET ADDRESS 445 WEST MAIN STREET
CLARKSBURG, WV 26301 CLARKSBURG, WV 26301

FORM IV-6

COUNTY PERMIT NO.

33

05/25/2012

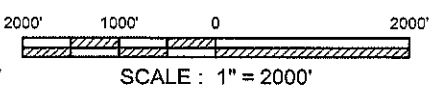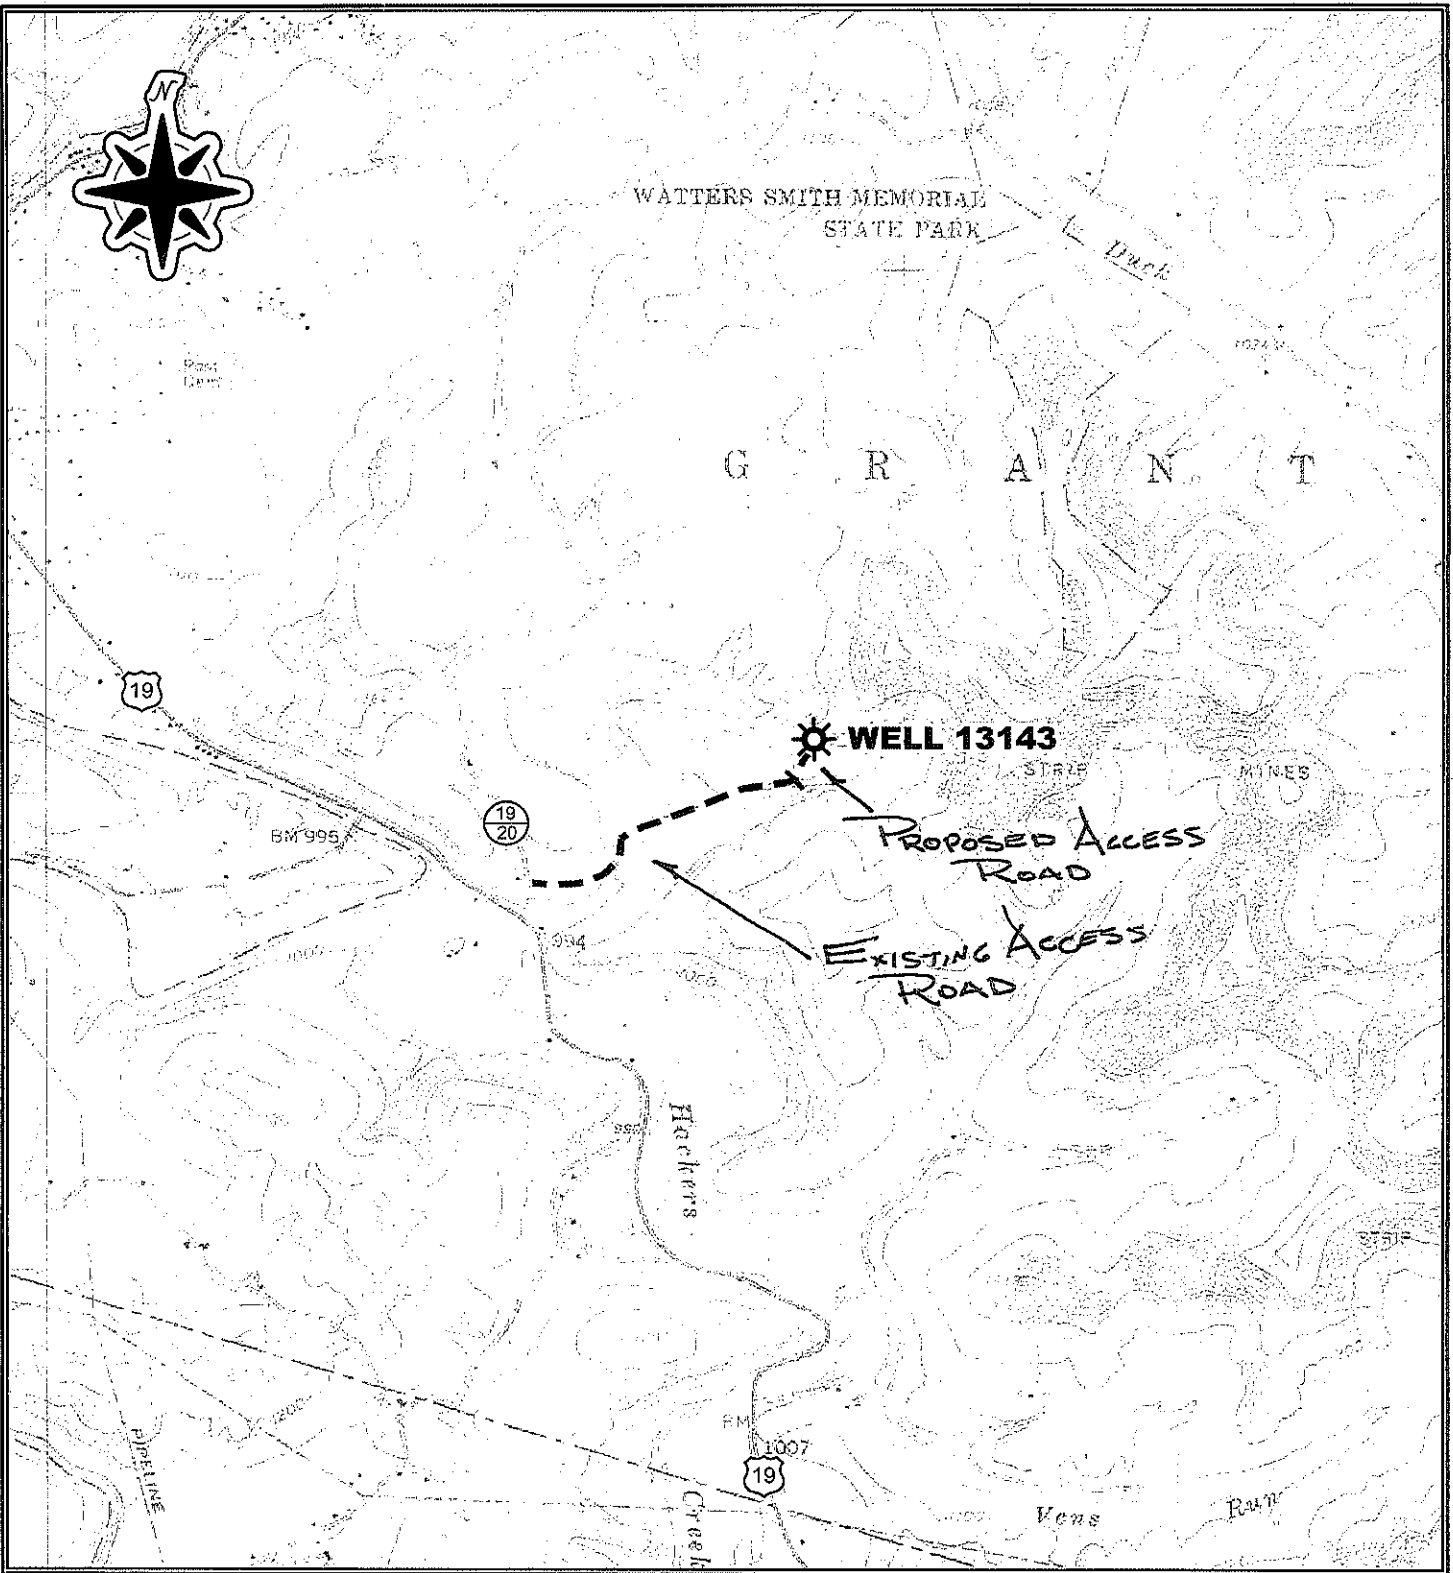

REFERENCE
 USGS 7.5' TOPOGRAPHIC MAP
 WEST MILFORD, W.V.
 1961 PHOTOREVISED 1976

CAD FILE NO. 11-596-Well13143-SiteLocation

DOMINION TRANSMISSION, INC.

**SITE LOCATION DRAWING
 FOR
 PROPOSED WELL 13143**

Drawn by	MVS	2/12
Engineer	HDW	2/12
Checked by	RVS	2/12
		Date

Scale: AS SHOWN

Prepared by *MSES consultants, inc.*

1 of 1