



---

**west virginia** department of environmental protection

---

Office of Oil and Gas  
601 57th Street SE  
Charleston, WV 25304  
(304) 926-0450  
(304) 926-0452 fax

Earl Ray Tomblin, Governor  
Randy C. Huffman, Cabinet Secretary  
[www.dep.wv.gov](http://www.dep.wv.gov)

March 22, 2016

**FINAL INSPECTION REPORT**

**New Well Permit Cancelled**

HG ENERGY, LLC,

The FINAL INSPECTION REPORT for the CANCELLED permit, API Well Number:  
47-3305785, issued to HG ENERGY, LLC, and listed below has been received in this office.  
The permit has been cancelled as of 3/17/2016.

James Martin  
Chief

Operator: HG ENERGY, LLC  
Operator's Well No: J.M. FULTZ NO. 246  
Farm Name: MYERS, EDGAR LEE JR.  
**API Well Number: 47-3305785**  
Date Issued: 08/28/2013

Date Cancelled: 03/17/2016

**Promoting a healthy environment.**

**04/01/2016**

(BOTTOM HOLE: LON:-80°30'08.6")

LON:-80°30'11.9"

935

LON: 80°30'00" 8285

LAT:39°16'08.1"

(BOTTOM HOLE: LAT:39°16'02.1")

1 - Well ties and Latitude and Longitude were measured by Topcon Hiper GA survey grade GPS. Bearings are referenced to UTM Grid North (Zone 17 North - NAD 1983).

2 - Surface owners, adjacent information, Lease names, & line mapping obtained from HGE GIS system. No survey was performed to determine lines within the Waterflood Unit-reference: HGE GIS system.


3 - No Title Opinion was provided to the Surveyor during this survey. This survey is subject to a complete title Opinion.

UTM Coordinates (Zone 17N-NAD 1983)	
Surface	N-4,346,747m. E-542,863m.
Bottom Hole	N-4,346,562m. E-542,941m.

LOCATION REFERENCES	
UTM 27	
N 39°12' W 11.4' EX: WELL	
N 70°32' E 106.3' 30" WO	
Brg. Direction is prop. well to the ref.	

LAT: 39°17'30"

**MAP OF  
H.G. ENERGY, LLC  
-WATERFLOOD UNIT-  
J.M. FULTZ 246**

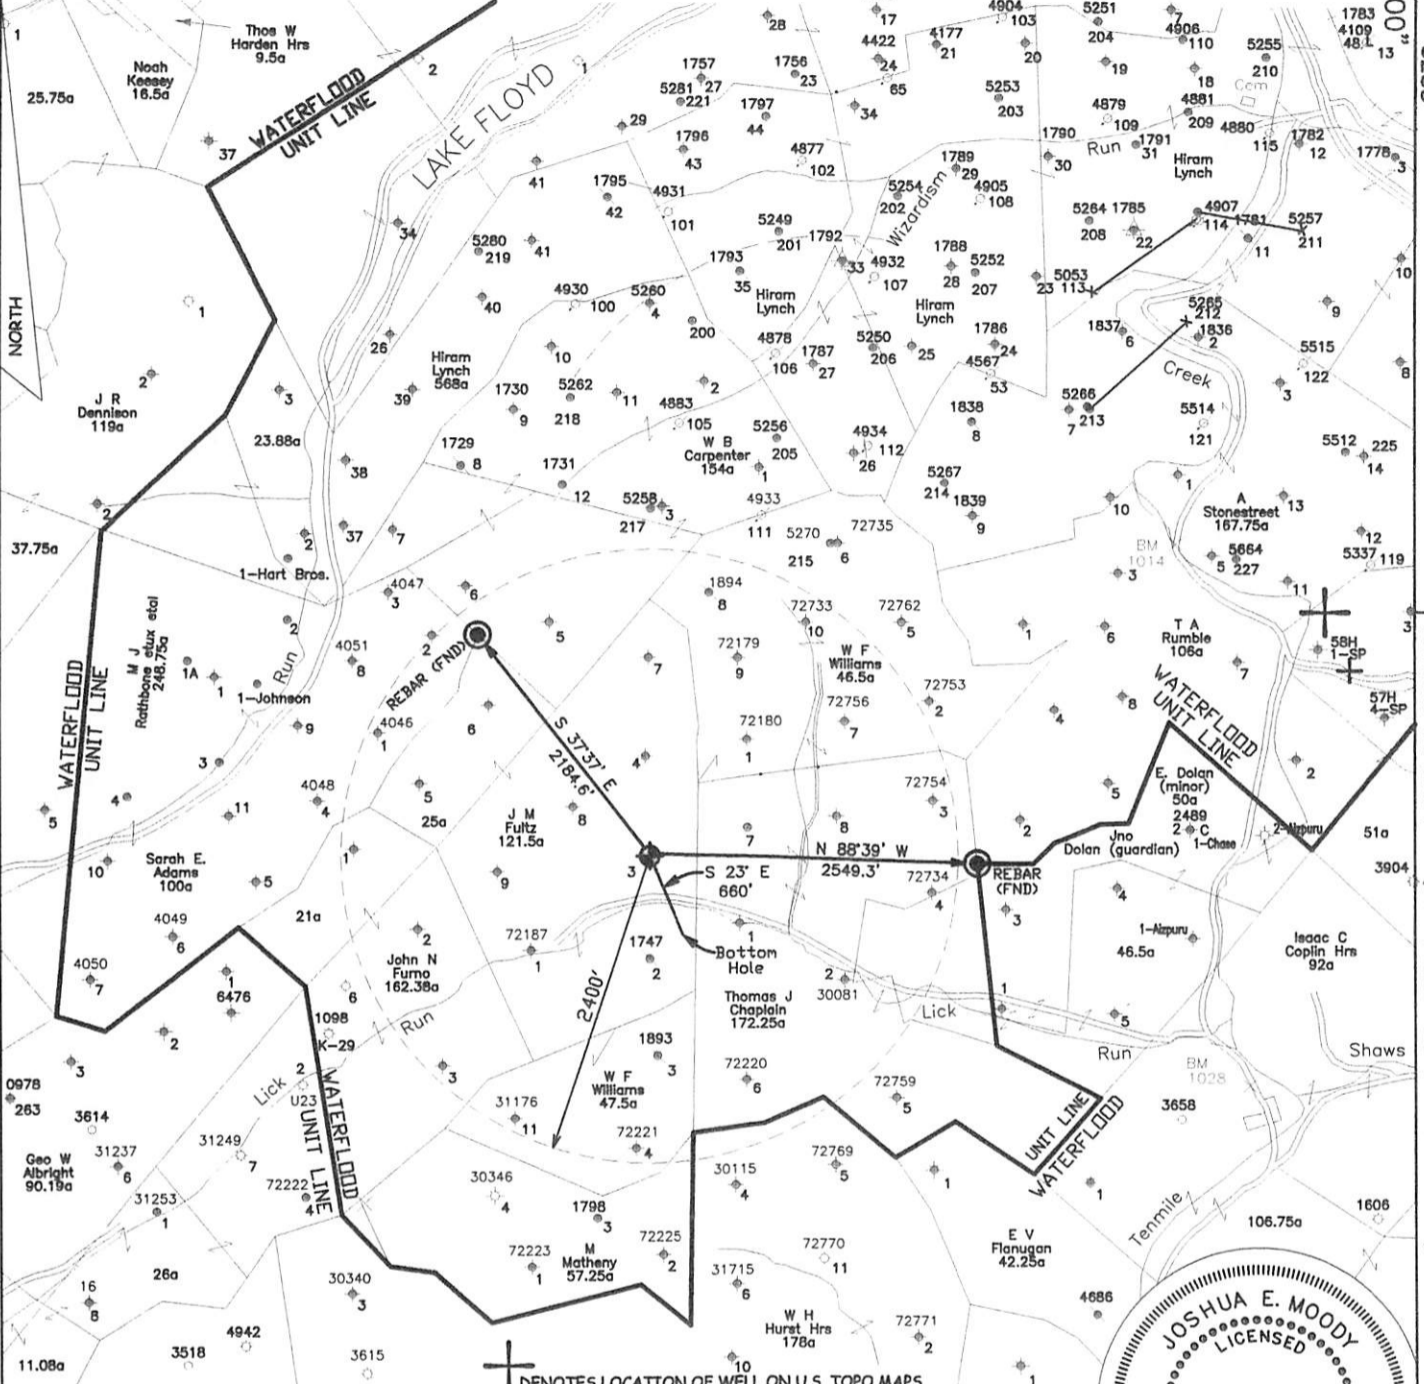

⊕ DENOTES LOCATION OF WELL ON U.S. TOPO MAPS.


JOB # 13-014  
DRAWING # 13LAKEFLOYD FOLDER  
SCALE 1" = 1500'  
MINIMUM DEGREE OF ACCURACY 1/2500  
PROVEN SOURCE OF ELEV. BENCH MARK H-80

I THE UNDERSIGNED, HEREBY CERTIFY THAT THIS PLAT IS CORRECT TO THE BEST OF MY KNOWLEDGE AND BELIEF AND SHOWS ALL THE INFORMATION REQUIRED BY LAW AND THE REGULATIONS ISSUED AND PERSCRIBED BY THE DEPARTMENT OF ENVIRONMENTAL PROTECTION.



WEST VIRGINIA DEPARTMENT OF ENVIRONMENTAL PROTECTION, OFFICE OF OIL AND GAS

**MOODY LAND SURVEYING, LLC**  
ST. MARYS, WV 26170

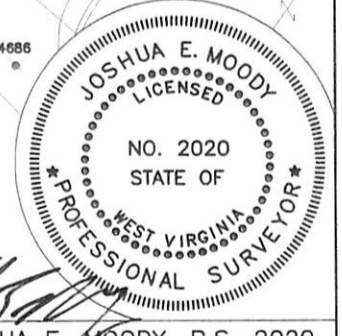

JOSHUA E. MOODY, P.S. 2020  
DATE 4/19/13  
OPERATOR'S WELL J.M. FULTZ #246

WEST VIRGINIA DEPARTMENT OF ENVIRONMENTAL PROTECTION OFFICE OF OIL AND GAS

WELL TYPE: OIL  GAS  LIQUID INJECTION  WASTE DISPOSAL  HORIZONTAL  ~~CANCELLED~~  
(IF "GAS") PRODUCTION  STORAGE  DEEP  SHALLOW  API WELL # 47-033-05785  
LOCATION: ELEVATION 1133' WATERSHED BRANCH OF LICK RUN DISTRICT TEN MILE COUNTY HARRISON STATE WV COUNTY HARRISON PERMIT 47-033-05785  
QUADRANGLE SALEM 7.5'

SURFACE OWNER EDGAR LEE MYERS, JR. ACREAGE 108.78 ACRES +/-  
OIL & GAS ROYALTY OWNER W.V.A. BAPTIST EDUC. SOC. ET AL LEASE ACREAGE 146 ACRES +/-  
PROPOSED WORK: DRILL  CONVERT  DRILL DEEPER  REDRILL  FRACTURE OR STIMULATE  PLUG OFF OLD FORMATION  PERFORATE NEW FORMATION   
OTHER PHYSICAL CHANGE IN WELL (SPECIFY) WILL BE DRILLED DIRECTIONALLY (S 23° E 660')  
PLUG & ABANDON  CLEAN OUT & REPLUG   
TARGET FORMATION 5TH SAND  
WELL OPERATOR H.G. ENERGY, LLC  
ADDRESS 5260 DuPONT ROAD  
PARKERSBURG, WV 26101  
ESTIMATED DEPTH MD= 3,150'  
DESIGNATED AGENT MIKE KIRSCH  
ADDRESS 5260 DuPONT ROAD  
PARKERSBURG, WV 26101

04/01/2016

COUNTY NAME PERMIT