

WW-7
8-30-06



West Virginia Department of Environmental Protection
Office of Oil and Gas

WELL LOCATION FORM: GPS

API: 47-033-05831 WELL NO.: Bud Dennison
FARM NAME: S. Herrod
RESPONSIBLE PARTY NAME: Tenmile Land, LLC
COUNTY: Harrison DISTRICT: Sardis
QUADRANGLE: Wolf Summit N
SURFACE OWNER: S. Herrod
ROYALTY OWNER: Bud Dennison Escrow
UTM GPS NORTHING: 4,355,302 m
UTM GPS EASTING: 545,563 m GPS ELEVATION: 1,269

The Responsible Party named above has chosen to submit GPS coordinates in lieu of preparing a new well location plat for a plugging permit or assigned API number on the above well. The Office of Oil and Gas will not accept GPS coordinates that do not meet the following requirements:


1. Datum: NAD 1983, Zone: 17 North, Coordinate Units: meters, Altitude: height above mean sea level (MSL) – meters.
2. Accuracy to Datum – 3.05 meters
3. Data Collection Method:

Survey grade GPS _____ : Post Processed Differential _____
Real-Time Differential _____

Mapping Grade GPS _____ : Post Processed Differential _____
Real-Time Differential _____

4. **Letter size copy of the topography map showing the well location.**

I the undersigned, hereby certify this data is correct to the best of my knowledge and belief and shows all the information required by law and the regulations issued and prescribed by the Office of Oil and Gas.

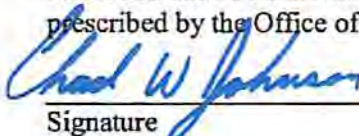
Signature

Managing Member
Title


9/10/2014
Date

Received

SEP 10 2014

Office of Oil and Gas
WV Dept. of Environmental Protection

33-05831

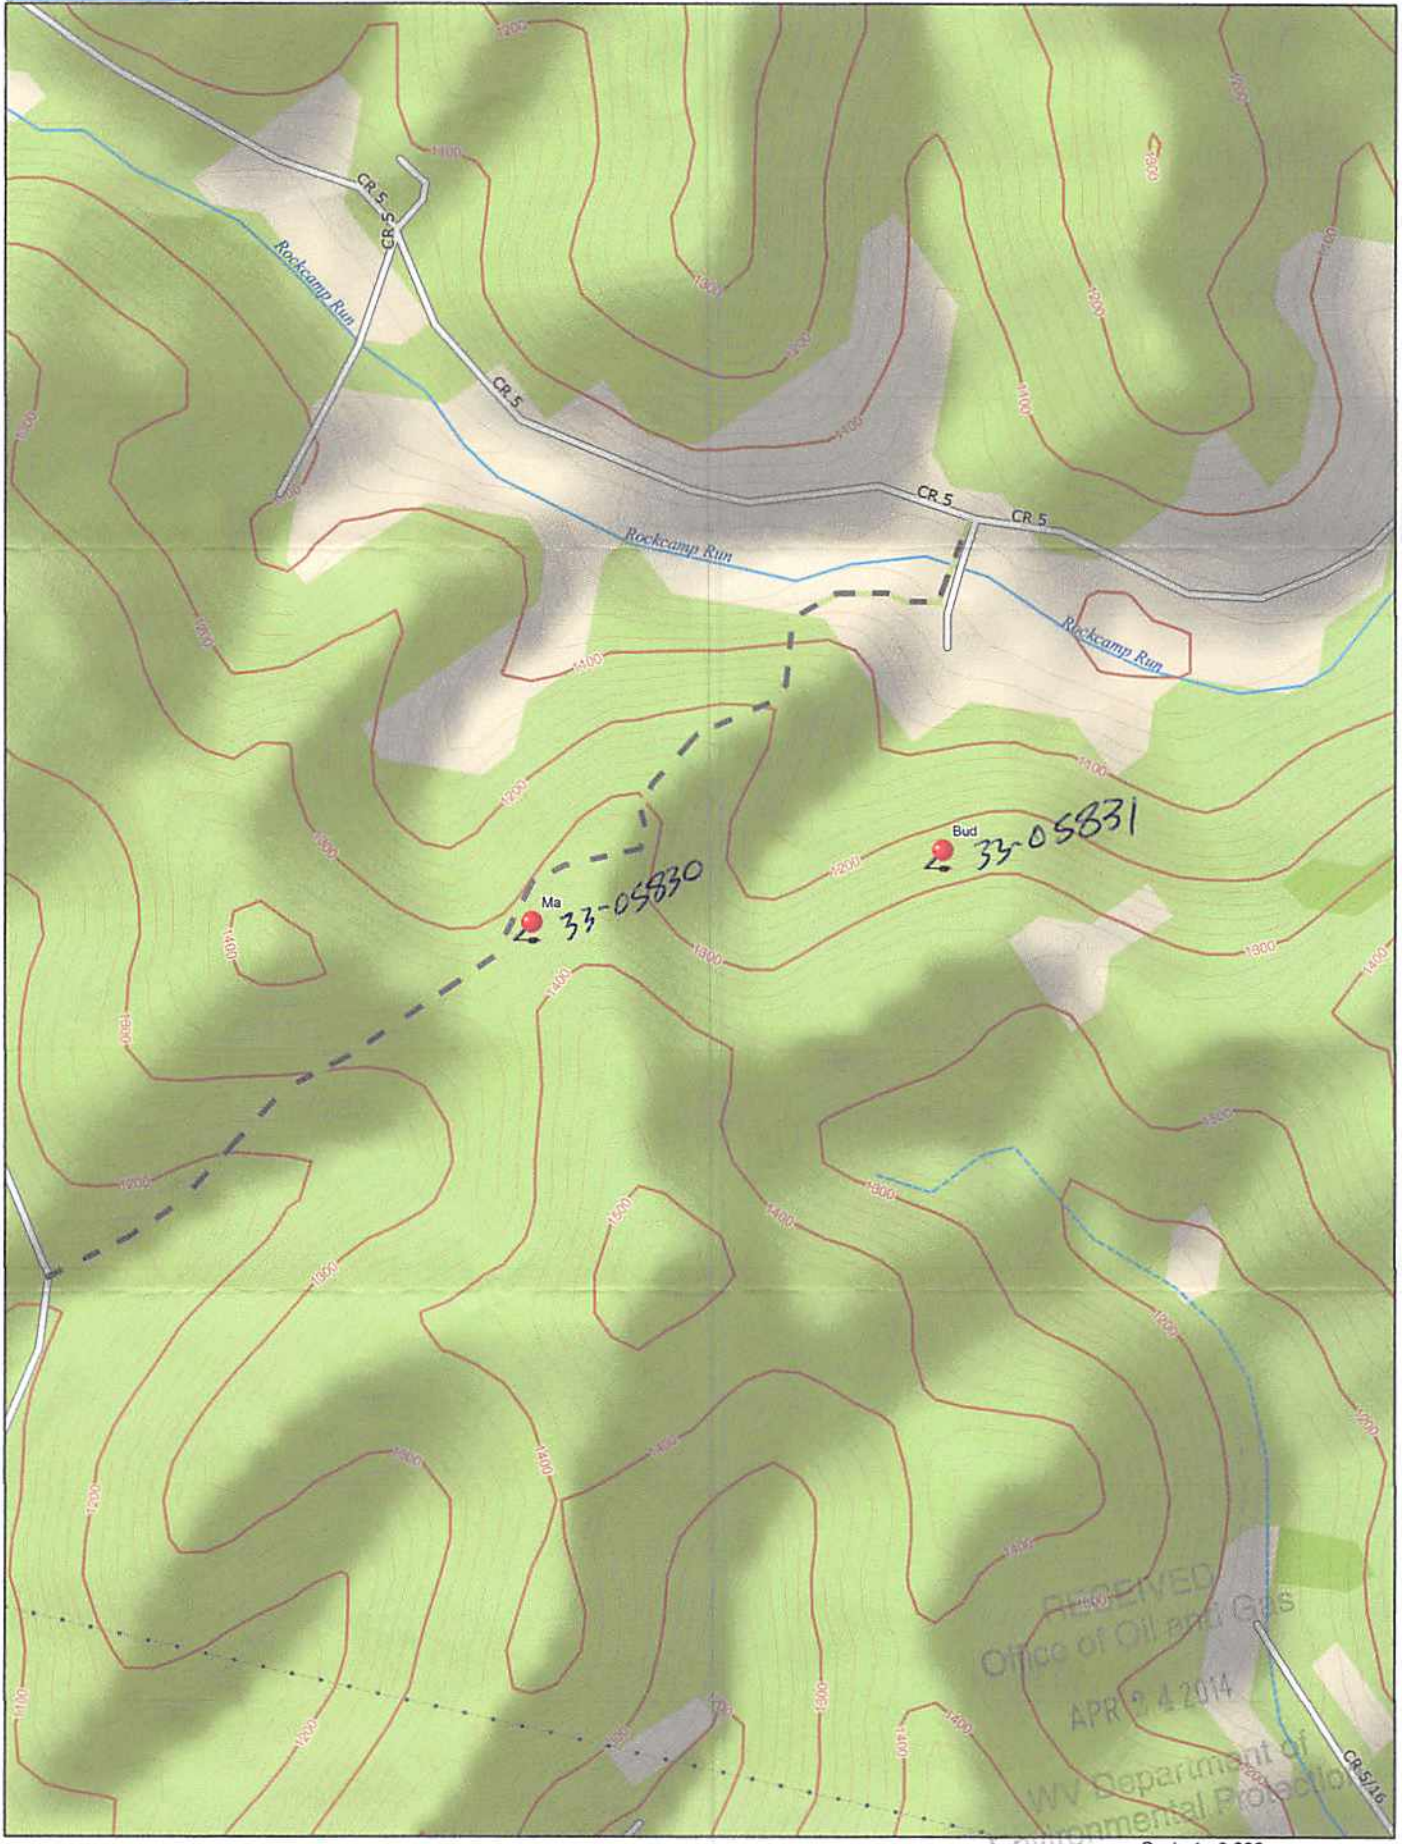

Data use subject to license.
 © DeLorme. XMap® 7.
 www.delorme.com

