




HG Energy II Appalachia, LLC Well No. Schoen 1205 S-9H As-Drilled Page 1 of 4		8,223' to Bottom Hole 5,365' to Top Hole TOP LATITUDE 39 - 10 - 00 BTM LATITUDE 39 - 07 - 30 TOP HOLE LONGITUDE 80 - 20 - 00 BTM HOLE LONGITUDE 80 - 17 - 30 5,548' to Top Hole 9,767' to Bottom Hole																
West Virginia Coordinate System of 1927, North Zone based upon Differential GPS Measurements. Notes: Well No. Schoen 1205 S-9H WVCS 1927, North Zone Top Hole Coordinates Lat: 39°09'05.15" Lon: 80°21'08.13" Landing Point Coordinates Lat: 39°09'10.21" Lon: 80°20'48.26" Bottom Hole Coordinates Lat: 39°05'53.42" Lon: 80°19'14.34"																		
UTM Zone 17, NAD 1983 Plat orientation and corner and well references are based upon the grid north meridian. Well location references are based upon the magnetic meridian. Notes: Well No. Schoen 1205 S-9H UTM NAD 1983 (USFS) Top Hole Coordinates N: 14,218,460.80' E: 1,824,096.96' Landing Point Coordinates N: 14,218,969.90' E: 1,825,657.93' Bottom Hole Coordinates N: 14,199,122.30' E: 1,833,203.00'		Notes: Well No. Schoen 1205 S-9H UTM NAD 1983 (Meters) Top Hole Coordinates N: 4,333,791.252m E: 555,985.865m Landing Point Coordinates N: 4,333,950.693m E: 556,461.650m Bottom Hole Coordinates N: 4,327,901.133m E: 558,761.392m																
Note: 1 water well was found within 2000' of proposed well. No occupied dwellings or buildings 2,500 square feet or larger used to house or shelter dairy cattle or poultry husbandry are located within 625' of the center of the well pad.		<table border="1" style="width: 100%; border-collapse: collapse;"> <thead> <tr> <th>Tag</th> <th>Bearing</th> <th>Dist.</th> </tr> </thead> <tbody> <tr> <td>L1</td> <td>S 71°32' E</td> <td>1,523.3'</td> </tr> <tr> <td>L2</td> <td>S 57°07' E</td> <td>1,293.7'</td> </tr> <tr> <td>L3</td> <td>N 87°12' W</td> <td>1,223.6'</td> </tr> <tr> <td>L4</td> <td>N 71°02' W</td> <td>995.8'</td> </tr> </tbody> </table>		Tag	Bearing	Dist.	L1	S 71°32' E	1,523.3'	L2	S 57°07' E	1,293.7'	L3	N 87°12' W	1,223.6'	L4	N 71°02' W	995.8'
Tag	Bearing	Dist.																
L1	S 71°32' E	1,523.3'																
L2	S 57°07' E	1,293.7'																
L3	N 87°12' W	1,223.6'																
L4	N 71°02' W	995.8'																
FILE NO: 32-36-G-19 DRAWING NO: Schoen 1205 S-9H Well Plat SCALE: 1" = 2000' MINIMUM DEGREE OF ACCURACY: Submeter PROVEN SOURCE OF ELEVATION: CORS, Bridgeport, WV		 STATE OF WEST VIRGINIA DEPARTMENT OF ENVIRONMENTAL PROTECTION OIL AND GAS DIVISION																
WELL TYPE: ☐ OIL ☒ GAS ☐ LIQUID INJECTION ☐ WASTE DISPOSAL (IF GAS) PRODUCTION: ☐ STORAGE ☐ DEEP ☒ SHALLOW		DATE: May 2 20 25 OPERATOR'S WELL NO. Schoen 1205 S-9H API WELL NO 47 — 033 — 06006 STATE COUNTY PERMIT																
LOCATION: ELEVATION: 1,407.3' WATERSHED: Middle West Fork Creek DISTRICT: Grant / Hackers Creek SURFACE OWNER: George & Rosanne Schoen ROYALTY OWNER: Willa Post Robey, et al LEASE NO: ACREAGE: 78.20 PROPOSED WORK: ☒ DRILL ☐ CONVERT ☐ DRILL DEEPER ☐ FRACTURE OR STIMULATE ☐ PLUG OFF OLD FORMATION ☐ PERFORATE NEW FORMATION ☒ OTHER PHYSICAL CHANGE IN WELL (SPECIFY) As-Drilled ☐ PLUG AND ABANDON ☐ CLEAN OUT AND REPLUG TARGET FORMATION: Marcellus Shale ESTIMATED DEPTH: 7,489' TVD 29,323' MD		Top: Mount Clare QUADRANGLE: Btm: Berlin COUNTY: Putnam ACREAGE: 65.00 7,489' TVD 29,323' MD																
WELL OPERATOR: HG Energy II Appalachia, LLC ADDRESS: 5260 Dupont Road Parkersburg, WV 26101		DESIGNATED AGENT: Diane C. White ADDRESS: 5260 Dupont Road Parkersburg, WV 26101																

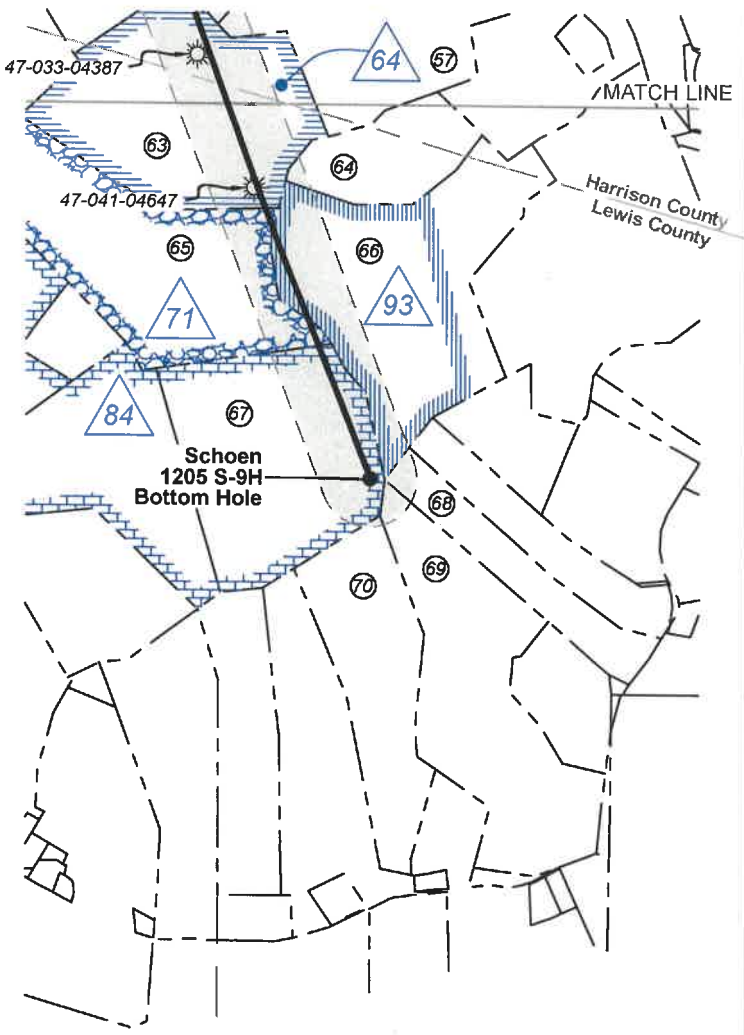

Wellhead Layout (NTS)

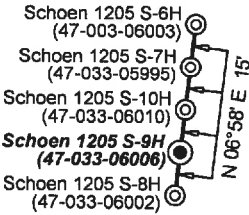

Well Location References
Not to Scale

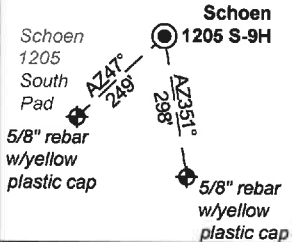

Legend

- Proposed gas well
- Well Reference, as noted
- Monument, as noted
- Existing Well, as noted
- Existing Plugged Well, as noted
- Digitized Well, as noted
- Creek or Drain
- Existing Road
- Surface boundary (approx.)

ID	Lease
1	A.B. Post, et al
4	John H. & Charlotte C. Gerlach
5	French S. & Anna J. Young
6	Susan V. Curry, et al
7	Mary Alkire, et al
8	L.B. & S.J. Davis
10	Lewis C. & Alma Swisher
12	French S. & Anna J. Young
13	Lewis C. & Alma Swisher
14	M.M.F. & S.F. Randolph
17	Mary Holbert Ellyson, et vir, et al
19	Sidney & Virginia Haymond
21	Patricia B. Smith, et al
64	Melvina E. Cookman
71	Allie B. & M.E. Jackson, et al
84	George & Ella Cummings
93	Eugenia F. Mills, et vir

FILE NO: 32-36-G-19
DRAWING NO: Schoen 1205 S-9H Well Plat
SCALE: 1" = 2000'
MINIMUM DEGREE OF ACCURACY:
Submeter
PROVEN SOURCE OF ELEVATION:
CORS, Bridgeport, WV

STATE OF WEST VIRGINIA
DEPARTMENT OF ENVIRONMENTAL PROTECTION
OIL AND GAS DIVISION


DATE: May 2 20 25
OPERATOR'S WELL NO. Schoen 1205 S-9H
API WELL NO
47 — 033 — 06006
STATE COUNTY PERMIT

WELL TYPE: ☐ OIL ☒ GAS ☐ LIQUID INJECTION ☐ WASTE DISPOSAL
(IF GAS) PRODUCTION: ☐ STORAGE ☐ DEEP ☒ SHALLOW

LOCATION: ELEVATION: 1,407.3' WATERSHED: Middle West Fork Creek
DISTRICT: Grant / Hackers Creek
SURFACE OWNER: George & Rosanne Schoen
ROYALTY OWNER: Willa Post Robey, et al LEASE NO: ACREAGE: 78.20
PROPOSED WORK: ☒ DRILL ☐ CONVERT ☐ DRILL DEEPER ☐ FRACTURE OR STIMULATE ☐ PLUG OFF OLD FORMATION
☐ PERFORATE NEW FORMATION ☒ OTHER PHYSICAL CHANGE IN WELL (SPECIFY) As-Drilled
☐ PLUG AND ABANDON ☐ CLEAN OUT AND REPLUG TARGET FORMATION: Marcellus Shale ESTIMATED DEPTH: 7,489' TVD 29,323' MD

Top: Mount Clare
Btm: Berlin
QUADRANGLE: 094192025
COUNT: 094192025
ACREAGE: 65.00

WELL OPERATOR: HG Energy II Appalachia, LLC DESIGNATED AGENT: Diane C. White
ADDRESS: 5260 Dupont Road ADDRESS: 5260 Dupont Road
Parkersburg, WV 26101 Parkersburg, WV 26101

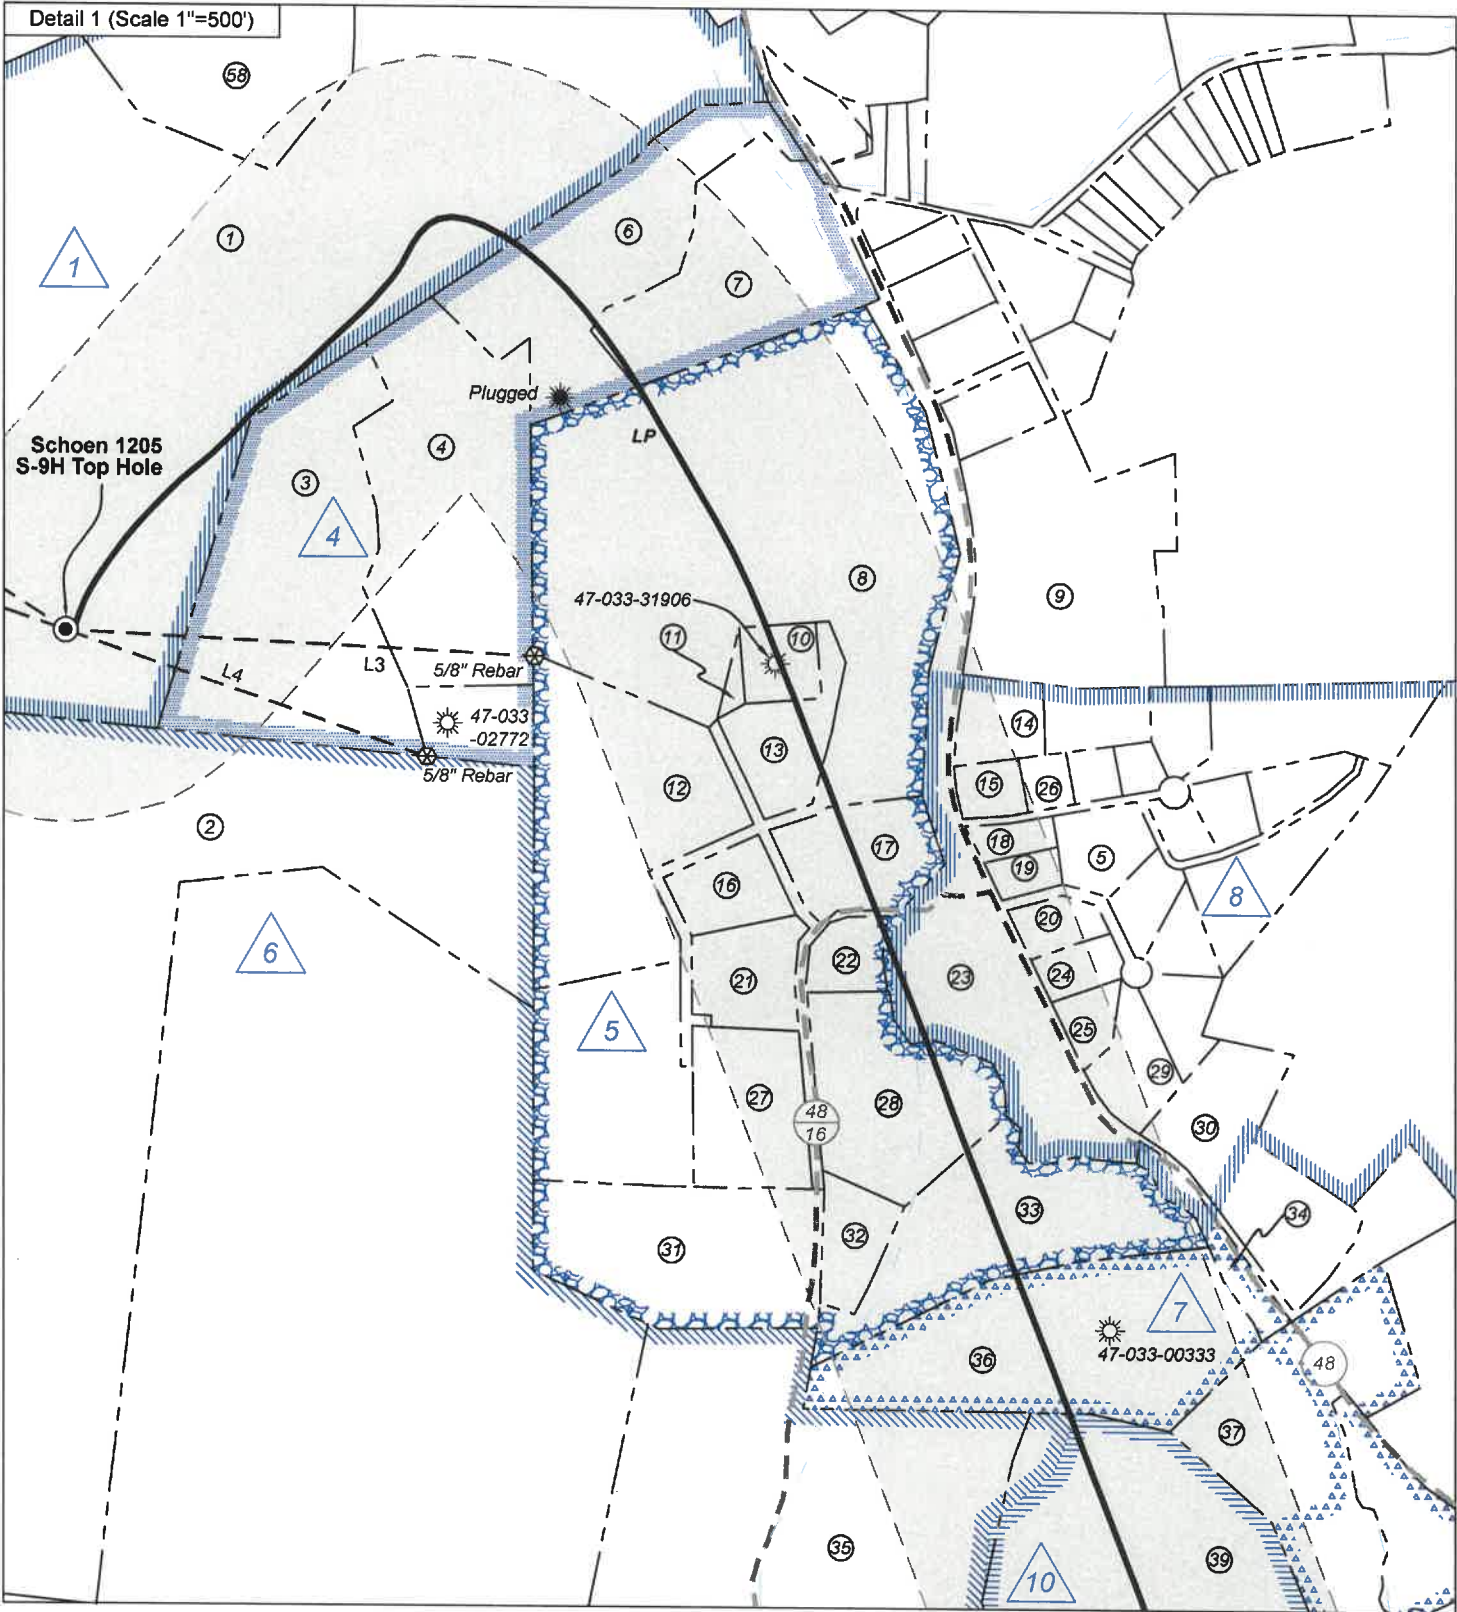

FILE NO: 32-36-G-19
 DRAWING NO: Schoen 1205 S-9H Well Plat
 SCALE: 1" = 2000'
 MINIMUM DEGREE OF ACCURACY:
 Submeter
 PROVEN SOURCE OF ELEVATION:
 CORS, Bridgeport, WV

STATE OF WEST VIRGINIA
 DEPARTMENT OF ENVIRONMENTAL PROTECTION
 OIL AND GAS DIVISION


DATE: May 2 20 25
 OPERATOR'S WELL NO. Schoen 1205 S-9H
 API WELL NO
 47 - 033 - 06006
 STATE COUNTY PERMIT

WELL TYPE: ☐ OIL ☒ GAS ☐ LIQUID INJECTION ☐ WASTE DISPOSAL
 (IF GAS) PRODUCTION : ☐ STORAGE ☐ DEEP ☒ SHALLOW
 LOCATION: ELEVATION: 1,407.3' WATERSHED: Middle West Fork Creek
 DISTRICT: Grant / Hackers Creek
 SURFACE OWNER: George & Rosanne Schoen
 ROYALTY OWNER: Willa Post Robey, et al LEASE NO: ACREAGE: 78.20
 PROPOSED WORK: ☒ DRILL ☐ CONVERT ☐ DRILL DEEPER ☐ FRACTURE OR STIMULATE ☐ PLUG OFF OLD FORMATION
☐ PERFORATE NEW FORMATION ☒ OTHER PHYSICAL CHANGE IN WELL (SPECIFY) As-Drilled
☐ PLUG AND ABANDON ☐ CLEAN OUT AND REPLUG TARGET FORMATION: Marcellus Shale ESTIMATED DEPTH: 7,489' TVD
 29,323' MD

WELL OPERATOR: HG Energy II Appalachia, LLC DESIGNATED AGENT: Diane C. White
 ADDRESS: 5260 Dupont Road ADDRESS: 5260 Dupont Road
 Parkersburg, WV 26101 Parkersburg, WV 26101



Harrison County				
No.	TM / Par	Owner	Bk / Pg	Ac.
1	447 / 2	George & Rosanne Schoen	1148 / 1059	65.00
2	446 / 29	Thomas K. Young , et al	1121 / 25	75.00
3	447 / 3	George and Rosanne Schoen	1253 / 302	10.06
4	447 / 3.4	Stephen M & Kimberly Goff	1257/189	7.67
5	447 / 5.10	Raymond D. & Karen D. Irvin	1393/477	1.09
6	447 / 3.3	Charlotte C. Gerlach	1070/1041	6.10
7	447 / 3.2	Michael Tillman & Mary Hencke	1257/193	5.86
8	447 / 4.11	Joseph & Karen Bowers	1295/887	21.87
9	447 / 6.1	Michael & Charlotte Moses	1364/7	7.20
10	447 / 4.10	John Breen LACO	1512/1161	0.92
11	447 / 4.12	John Breen LACO	1512/1161	0.17
12	447 / 4.1	H. Keith & Diana L. Bramel	1438/63	7.46
13	447 / 4.7	John Breen	1512/1161	2.20
14	447 / 5.25	Kenneth & Twyla Snoops	1440/70	1.09
15	447 / 5.12	Jeffrey & Diana Rogers	1553/872	0.57
16	447 / 4.8	Joseph C. Queen	1231/172	1.18
17	447 / 4.4	Danny Lee Hess	1264/1228	3.00
18	447 / 5.18	James D. & Joanie L. Oliverio	1542/1102	0.40
19	447 / 5.1	Sheri L. Smith	1537/668	0.42
20	447 / 5.14	Joshua S. Runyon	1498/815	0.64
21	447 / 4.3	Grzechowski T. & Jerusha A. Adler	1473/697	1.69
22	447 / 4.6	Melinda J. & Michael R. Bush	1294/171	0.85
23	447 / 5.3	Town of Lost Creek	G 63/401	2.50
24	447 / 5.19	Delani & Linda Coffman	1325/840	0.63
25	447 / 5.13	Delano & Linda Coffman	1359/713	0.56
26	447 / 5.9	Ronald J. Reed	1308/925	0.41
27	447 / 4.5	Eric A. Davis, et al	1598/531	2.85
28	447 / 4.9	Melinda Bush	1569/158	4.20
29	447 / 5.7	Jennifer Donnellan	1438/453	1.19
30	447 / 26.1	Russell A. Snyder	1425/1332	2.01
31	447 / 21	Richard & Rebecca Sprout	1600/849	6.09
32	447 / 4.2	Gail & Howard Marsh	1410/1058	1.04
33	447 / 4	Gene & Carol Kennedy	1101/303	5.83
34	447 / 23.3	Russell A. Snyder	1585/356	0.72
35	447 / 22	Daniel & Stacie Cooley	1310/1072	16.59
36	447 / 23.2	Donna Greaver	1585/708	8.35
37	447 / 24	Franklin Jr. & Elizabeth Wheeler	1585/108	5.26
38	447 / 34	Sharon K. & Patsy J. Salate	1360/84	43.00
39	447 / 36	Debra J. Bedell	1291/931	82.38
40	467 / 36	Gary W. & Kathy Hanby	1107/1041	15.35
41	467 / 2	Jackson L. Smith	1378 / 976	95.16
42	447 / 44.1	Debra J. Bedell	1291/931	30.37
43	447 / 44	Roddy & Tracy L. Ash	1332/493	15.21
44	447 / 44.4	Michael W. & Tracy L. Ash	1359/139	4.79
45	467 / 2.2	Ronald J. Singer	1395 / 600	2.65
46	467 / 31	Eugene Hanby	1237 / 23	2.50
47	467 / 20	Steven G. & Juila A. Randolph	1321 / 1151	54.64
48	467 / 32	Clara Ellen Wentz	--- / ---	0.58
49	467 / 32.1	Joseph M. Richards	1439 / 1234	0.04
50	467 / 32.3	Joseph M. Richards	1485 / 706	4.15
51	467 / 36	Joseph M. Richards	1439 / 1234	73.93
52	467 / 36.1	Gary W. & Kathy Hanby	1153 / 965	45.00
53	467 / 52	David L. & Lisle C. Hinkle	1282 / 389	175.50
54	467 / 53	George W Dawson, et ux	1418 / 331	158.55
55	487 / 5	Kimberly & Terri Glaze Wriston	W 83 / 97	129.62
56	487 / 6	Clayton W. Rice	1563 / 252	70.33
57	487 / 8	Wayne R. Lewis	1616 / 1241	134.68
58	447 / 1	Dale H. Jordan	1437 / 672	6.70
59	447 / 35	Kenneth Maxwell, et al	1311 / 423	11.67
60	447 / 43	Isaac & Betty Maxwell	1543 / 141	123.95
61	467 / 30	William L. Randolph, et ux	1518 / 19	73.73
62	467 / 33.1	Eugene W. Hanby	1428 / 1	4.76
Lewis County				
63	10C / 16	Thomas C. Kennedy Testamentary Trust	W34 / 428	105.00
64	10C / 17	Morman Jackson	584 / 191	34.00
65	10C / 15	Thomas C. Kennedy Testamentary Trust	W34 / 428	107.00
66	10C / 18	Shannon M. & Matthew C. Arnett	660 / 422	114.40
67	10D / 23	George W. & Amy J. Dawson	505 / 549	96.00
68	10D / 25	David S. & Kimberly S. Ledoux	724 / 496	32.34
69	10D / 28	George W. & Amy J. Dawson	505 / 549	91.89
70	10D / 32.6	Linda K. Linger, et al	W51 / 755	62.33

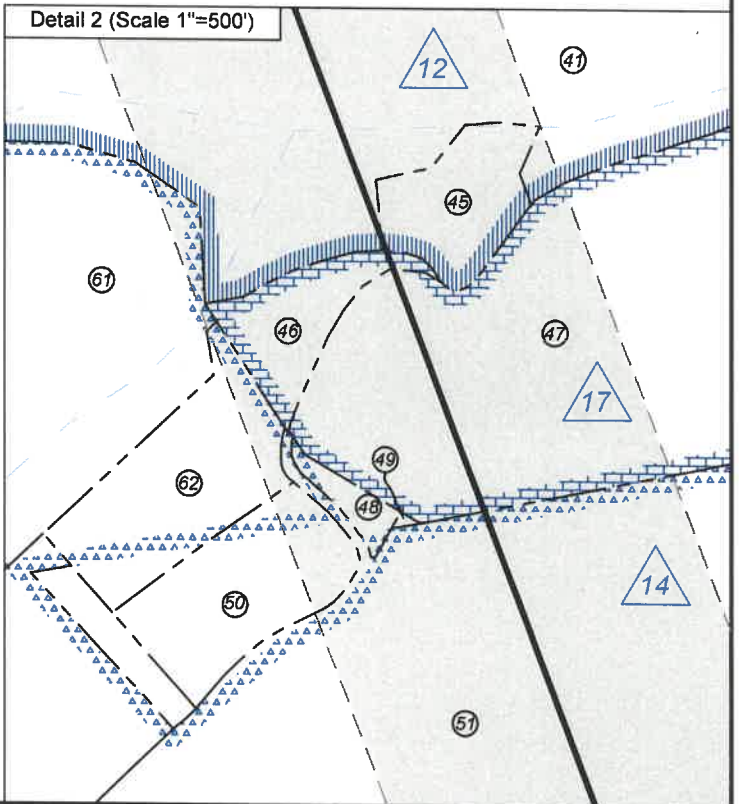

FILE NO: 32-36-G-19

DRAWING NO: Schoen 1205 S-9H Well Plat

SCALE: 1" = 2000'

MINIMUM DEGREE OF ACCURACY:
Submeter

PROVEN SOURCE OF ELEVATION:
CORS, Bridgeport, WV

STATE OF WEST VIRGINIA
DEPARTMENT OF ENVIRONMENTAL PROTECTION
OIL AND GAS DIVISION

DATE: May 2 20 25

OPERATOR'S WELL NO. Schoen 1205 S-9H

API WELL NO

47 — 033 — 06006
STATE COUNTY PERMIT

WELL TYPE: ☐ OIL ☒ GAS ☐ LIQUID INJECTION ☐ WASTE DISPOSAL
(IF GAS) PRODUCTION: ☐ STORAGE ☐ DEEP ☒ SHALLOW

LOCATION: ELEVATION: 1,407.3' WATERSHED: Middle West Fork Creek

DISTRICT: Grant / Hackers Creek

SURFACE OWNER: George & Rosanne Schoen

ROYALTY OWNER: Willa Post Robey, et al

PROPOSED WORK: ☒ DRILL ☐ CONVERT ☐ DRILL DEEPER ☐ FRACTURE OR STIMULATE ☐ PLUG OFF OLD FORMATION
☐ PERFORATE NEW FORMATION ☒ OTHER PHYSICAL CHANGE IN WELL (SPECIFY) As-Drilled

☐ PLUG AND ABANDON ☐ CLEAN OUT AND REPLUG TARGET FORMATION: Marcellus Shale ESTIMATED DEPTH: 7,489' TVD
29,323' MD

WELL OPERATOR: HG Energy II Appalachia, LLC

ADDRESS: 5260 Dupont Road

Parkersburg, WV 26101

DESIGNATED AGENT: Diane C. White

ADDRESS: 5260 Dupont Road

Parkersburg, WV 26101

Top: Mount Clare
QUADRANGLE: Btm: Berlin

COUNTY: Harrison

ACREAGE: 65.00

ACREAGE: 78.20