

HG Energy II  
Appalachia, LLC  
Well No. Schoen  
1205 N-3H As-Drilled




I, the undersigned, hereby certify  
that this plat is correct to the best  
of my knowledge and belief and  
shows all the information required  
by law and the rules issued and  
prescribed by the Department of  
Environmental Protection.

Dwayne D. Matheny, P.S. 2070



Legend

- Proposed gas well
- Well Reference, as noted
- Monument, as noted
- Existing Well, as noted
- Existing Plugged Well, as noted
- Digitized Well, as noted
- Surface boundary (approx.)
- Interior surface tracts (approx.)
- Creek or Drain
- Existing Road
- Railroad Tracks

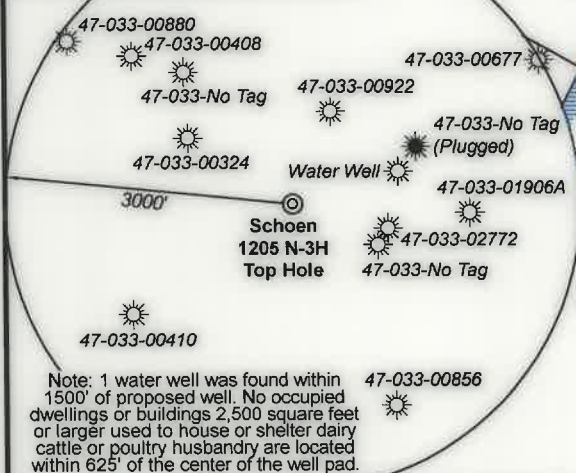

FILE NO: 32-36-G-19  
DRAWING NO: Schoen 1205 N3H Well Plat  
SCALE: 1" = 2000'  
MINIMUM DEGREE OF ACCURACY:  
Submeter  
PROVEN SOURCE OF ELEVATION:  
CORS, Bridgeport, WV

STATE OF WEST VIRGINIA  
DEPARTMENT OF ENVIRONMENTAL PROTECTION  
OIL AND GAS DIVISION

DATE: May 14 20 25  
OPERATOR'S WELL NO. Schoen 1205 N-3H  
API WELL NO  
47 - 033 - 06007  
STATE COUNTY PERMIT

WELL TYPE: ☐ OIL ☒ GAS ☐ LIQUID INJECTION ☐ WASTE DISPOSAL  
(IF GAS) PRODUCTION: ☐ STORAGE ☐ DEEP ☒ SHALLOW

LOCATION: ELEVATION: 1,407.3' WATERSHED: Middle West Fork Creek

DISTRICT: Grant / Union

SURFACE OWNER: George & Rosanne Schoen

ROYALTY OWNER: Willa Post Robey, et al

LEASE NO: ACREAGE: 78.20

PROPOSED WORK: ☒ DRILL ☐ CONVERT ☐ DRILL DEEPER ☐ FRACTURE OR STIMULATE ☐ PLUG OFF OLD FORMATION  
☐ PERFORATE NEW FORMATION ☒ OTHER PHYSICAL CHANGE IN WELL (SPECIFY) As-Drilled

☐ PLUG AND ABANDON ☐ CLEAN OUT AND REPLUG TARGET FORMATION: Marcellus Shale ESTIMATED DEPTH: 24,570' MD

WELL OPERATOR: HG Energy II Appalachia, LLC

DESIGNATED AGENT: Diane C. White

ADDRESS: 5260 Dupont Road  
Parkersburg, WV 26101

ADDRESS: 5260 Dupont Road  
Parkersburg, WV 26101

10,899' to Bottom Hole

5,320' to Top Hole  
BTM LATITUDE 39 - 12 - 30  
TOP LATITUDE 39 - 10 - 00

Notes: Well No.  
Schoen 1205 N-3H  
UTM NAD 1983 (USSF)  
Top Hole Coordinates  
N: 14,218,790.94'  
E: 1,824,139.21'  
Landing Point Coordinates  
N: 14,218,720.34'  
E: 1,824,095.32'  
Bottom Hole Coordinates  
N: 14,234,860.94'  
E: 1,818,441.80'

Notes: Well No.  
Schoen 1205 N-3H  
UTM NAD 1983 (Meters)  
Top Hole Coordinates  
N: 4,333,896.151m  
E: 555,998.744m  
Landing Point Coordinates  
N: 4,333,874.627m  
E: 555,985.366m  
Bottom Hole Coordinates  
N: 4,338,794.292m  
E: 554,262.169m

UTM Zone 17, NAD 1983  
Plat orientation and corner  
and well references are  
based upon the grid north  
meridian. Well location  
references are based upon  
the magnetic meridian.

West Virginia Coordinate  
System of 1927, North Zone  
based upon Differential GPS  
Measurements.

Notes: Well No.  
Schoen 1205 N-3H  
WVCS 1927, North Zone  
Top Hole Coordinates  
Lat: 39°09'08.55"  
Lon: 80°21'07.56"  
Landing Point Coordinates  
Lat: 39°09'07.85"  
Lon: 80°21'08.12"  
Bottom Hole Coordinates  
Lat: 39°11'47.83"  
Lon: 80°22'18.49"

| Tag | Bearing    | Dist.    |
|-----|------------|----------|
| L1  | N 53°25' W | 1,120.3' |
| L2  | S 80°23' W | 1,185.0' |
| L3  | S 72°23' E | 1,184.1' |
| L4  | S 84°41' E | 1,493.5' |


GRID NORTH

HG Energy II  
Appalachia, LLC  
Well No. Schoen  
1205 N-3H As-Drilled


Page 2 of 5



Detail 1  
NTS

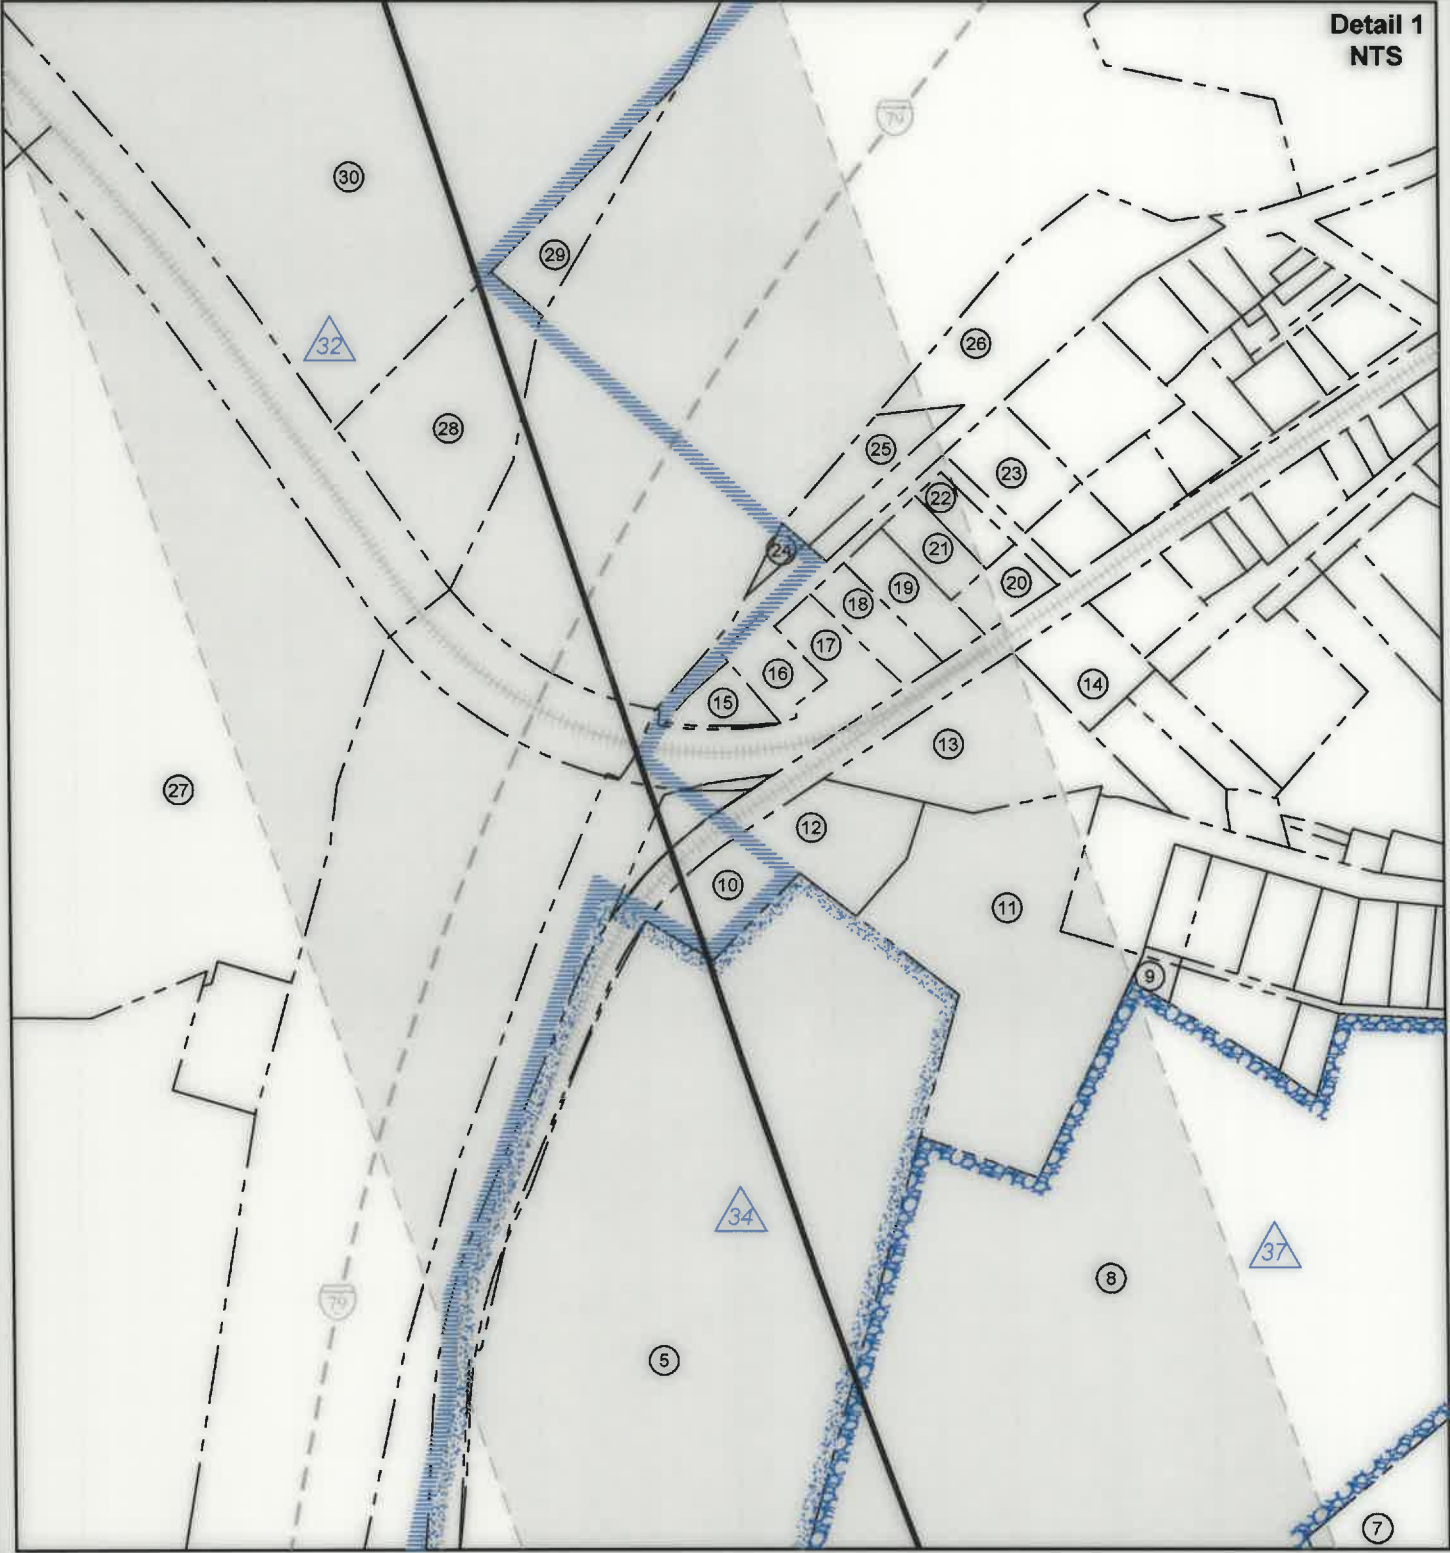

FILE NO: 32-36-G-19  
DRAWING NO: Schoen 1205 N3H Well Plat  
SCALE: 1" = 2000'  
MINIMUM DEGREE OF ACCURACY:  
Submeter  
PROVEN SOURCE OF ELEVATION:  
CORS, Bridgeport, WV

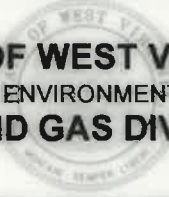

STATE OF WEST VIRGINIA  
DEPARTMENT OF ENVIRONMENTAL PROTECTION  
OIL AND GAS DIVISION

DATE: May 14 20 25  
OPERATOR'S WELL NO. Schoen 1205 N-3H  
API WELL NO  
47 — 033 — 06007  
STATE COUNTY PERMIT

WELL TYPE: ☐ OIL ☒ GAS ☐ LIQUID INJECTION ☐ WASTE DISPOSAL  
(IF GAS) PRODUCTION : ☐ STORAGE ☐ DEEP ☒ SHALLOW

LOCATION: ELEVATION: 1,407.3' WATERSHED: Middle West Fork Creek  
DISTRICT: Grant / Union  
SURFACE OWNER: George & Rosanne Schoen  
ROYALTY OWNER: Willa Post Robey, et al LEASE NO: ACREAGE: 78.20  
PROPOSED WORK: ☒ DRILL ☐ CONVERT ☐ DRILL DEEPER ☐ FRACTURE OR STIMULATE ☐ PLUG OFF OLD FORMATION  
☐ PERFORATE NEW FORMATION ☒ OTHER PHYSICAL CHANGE IN WELL (SPECIFY) As-Drilled 7,455' TVD  
☐ PLUG AND ABANDON ☐ CLEAN OUT AND REPLUG TARGET FORMATION: Marcellus Shale ESTIMATED DEPTH: 24,570' MD


Top: Mount Clare  
QUADRANGLE: Btm: West Milford  
COUNTY: Harrison  
ACREAGE: 65.00  
09/19/2025

WELL OPERATOR: HG Energy II Appalachia, LLC  
ADDRESS: 5260 Dupont Road  
Parkersburg, WV 26101

DESIGNATED AGENT: Diane C. White  
ADDRESS: 5260 Dupont Road  
Parkersburg, WV 26101



Detail 2  
 NTS

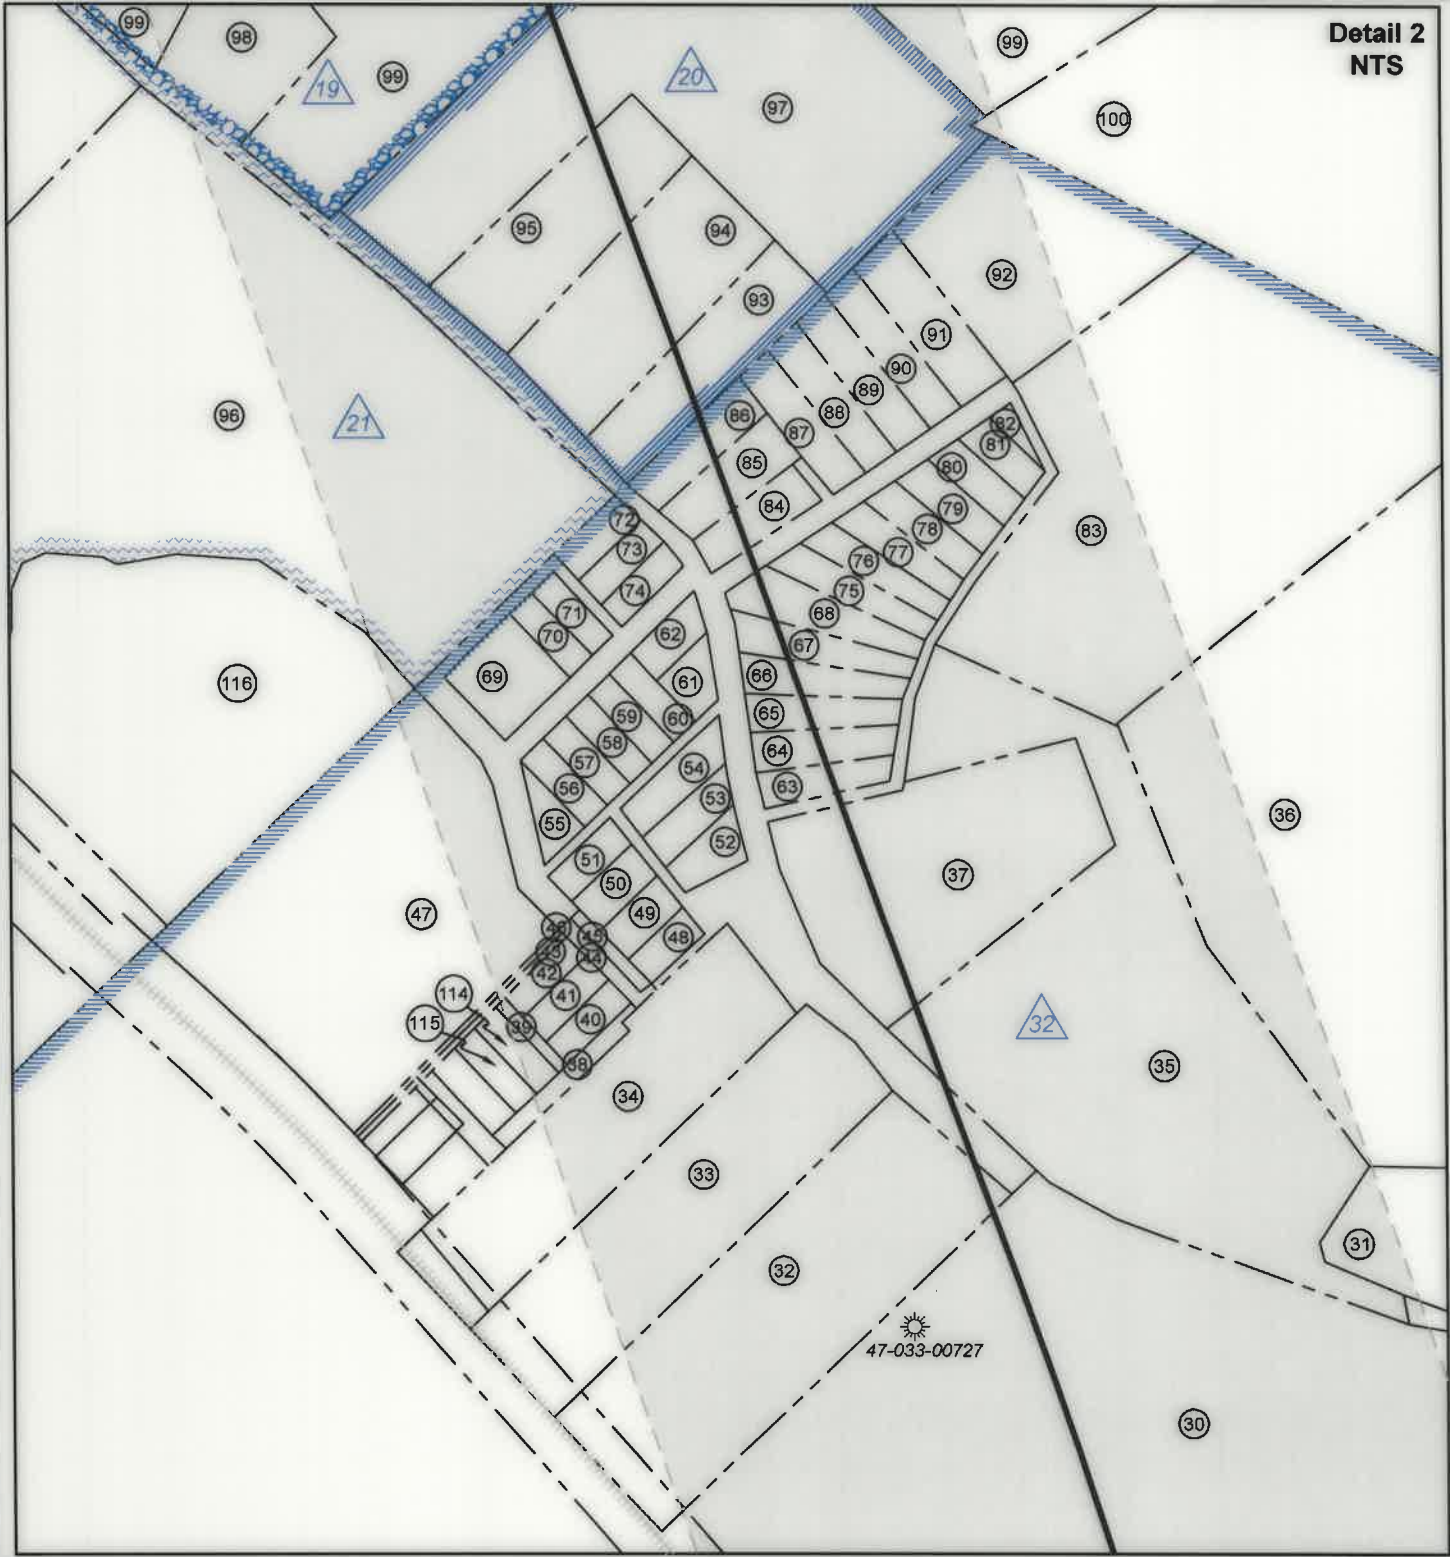

FILE NO: 32-36-G-19  
 DRAWING NO: Schoen 1205 N3H Well Plat  
 SCALE: 1" = 2000'  
 MINIMUM DEGREE OF ACCURACY:  
 Submeter  
 PROVEN SOURCE OF ELEVATION:  
 CORS, Bridgeport, WV

STATE OF WEST VIRGINIA  
 DEPARTMENT OF ENVIRONMENTAL PROTECTION  
 OIL AND GAS DIVISION

DATE: May 14 20 25  
 OPERATOR'S WELL NO. Schoen 1205 N-3H  
 API WELL NO  
 47 — 033 — 06007  
 STATE COUNTY PERMIT

WELL TYPE: ☐ OIL ☒ GAS ☐ LIQUID INJECTION ☐ WASTE DISPOSAL  
 (IF GAS) PRODUCTION: ☐ STORAGE ☐ DEEP ☒ SHALLOW

LOCATION: ELEVATION: 1,407.3' WATERSHED: Middle West Fork Creek

DISTRICT: Grant / Union

SURFACE OWNER: George & Rosanne Schoen

ROYALTY OWNER: Willa Post Robey, et al

PROPOSED WORK: ☒ DRILL ☐ CONVERT ☐ DRILL DEEPER ☐ FRACTURE OR STIMULATE ☐ PLUG OFF OLD FORMATION  
☐ PERFORATE NEW FORMATION ☒ OTHER PHYSICAL CHANGE IN WELL (SPECIFY) As-Drilled

☐ PLUG AND ABANDON ☐ CLEAN OUT AND REPLUG TARGET FORMATION: Marcellus Shale ESTIMATED DEPTH: 24,570' MD

WELL OPERATOR: HG Energy II Appalachia, LLC

DESIGNATED AGENT: Diane C. White

ADDRESS: 5260 Dupont Road

ADDRESS: 5260 Dupont Road

Parkersburg, WV 26101

Parkersburg, WV 26101

QUADRANGLE: Top: Mount Clare  
 Btm: West Milford

COUNTY: Harrison  
 ACREAGE: 65.00

09/19/2025

WELL OPERATOR: HG Energy II Appalachia, LLC

DESIGNATED AGENT: Diane C. White

ADDRESS: 5260 Dupont Road

ADDRESS: 5260 Dupont Road

Parkersburg, WV 26101

Parkersburg, WV 26101

Page 4 of 5

HG Energy II  
Appalachia, LLC  
Well No. Schoen  
1205 N-3H As-Drilled

ALLEGHENY  
SURVEYS, INC.

ID

Lease

2

Locie C. Stout, et al

3

Emory L. Stout, et ux

8

Porter Maxwell, et al

11

C.H. Woodford, et al

12

E.S. Swisher, et al

18

Ray T. Swisher, et al

19

Emma A. & Howard Post, et al

20

Kristopher J. Barron

32

Marcella Bond, et al

34

Gertrude Hardway, et al

37

Elizabeth L. Kennedy

39

Willa Post Robey, et al

52

Susan V. Curry, et al

Wellhead Layout (NTS)

Schoen 1205 N-3H  
(API# 47-033-06007)

Schoen 1205 N-2H  
(API# 47-033-06000)

Schoen 1205 N-4H  
(API# 47-033-06011)

Schoen 1205 N-1H  
(API# 47-033-06001)

Schoen 1205 N-5H  
(API# 47-033-06009)

N 07°01' E 15'

Well Location References  
Not to Scale

Schoen  
1205  
North  
Pad

Schoen  
1205 N-3H

5/8" rebar  
w/yellow  
plastic cap

5/8" rebar  
w/yellow  
plastic cap

AZ29° 57' 1"

AZ5° 62' 3"

FILE NO: 32-36-G-19  
DRAWING NO: Schoen 1205 N3H Well Plat  
SCALE: 1" = 2000'  
MINIMUM DEGREE OF ACCURACY:  
Submeter  
PROVEN SOURCE OF ELEVATION:  
CORS, Bridgeport, WV

STATE OF WEST VIRGINIA  
DEPARTMENT OF ENVIRONMENTAL PROTECTION  
OIL AND GAS DIVISION

DATE: May 14 20 25  
OPERATOR'S WELL NO. Schoen 1205 N-3H  
API WELL NO  
47 — 033 — 06007  
STATE COUNTY PERMIT

WELL TYPE: ☐ OIL ☒ GAS ☐ LIQUID INJECTION ☐ WASTE DISPOSAL  
(IF GAS) PRODUCTION: ☐ STORAGE ☐ DEEP ☒ SHALLOW

LOCATION: ELEVATION: 1,407.3' WATERSHED: Middle West Fork Creek  
DISTRICT: Grant / Union  
SURFACE OWNER: George & Rosanne Schoen  
ROYALTY OWNER: Willa Post Robey, et al LEASE NO: ACREAGE: 78.20  
PROPOSED WORK: ☒ DRILL ☐ CONVERT ☐ DRILL DEEPER ☐ FRACTURE OR STIMULATE ☐ PLUG OFF OLD FORMATION  
☐ PERFORATE NEW FORMATION ☒ OTHER PHYSICAL CHANGE IN WELL (SPECIFY) As-Drilled  
☐ PLUG AND ABANDON ☐ CLEAN OUT AND REPLUG TARGET FORMATION: Marcellus Shale ESTIMATED DEPTH: 24,570' MD

Top: Mount Clare  
Btm: West Milford  
COUNTY Harrison  
ACREAGE: 65.00

WELL OPERATOR: HG Energy II Appalachia, LLC  
ADDRESS: 5260 Dupont Road  
Parkersburg, WV 26101

DESIGNATED AGENT: Diane C. White  
ADDRESS: 5260 Dupont Road  
Parkersburg, WV 26101

No. TM / Par Owner Bk / Pg Ac.

1 447 / 2 George & Roseanne Schoen 1148 / 1059 65.00

2 447 / 3 George & Roseanne Schoen 1253 / 302 10.06

3 447 / 20 Richard & Janet Stout 1175 / 320 51.00

4 446 / 29 Thomas K. Young, et al 1121 / 25 75.00

5 446 / 8 Ruth Ann & Ralph Bradbury 1403 / 610 22.10

6 447 / 1 Dale H. Jordan 1437 / 672 6.70

7 427 / 32 Dale H. Jordan 1437 / 672 4.85

8 427 / 31 Willis Gene Kennedy 1412 / 590 18.60

9 2104 / 86 Jacob & Amanda Davis 1676 / 75 ---

10 2104 / 82 Ronald Deem 1465 / 242 0.76

11 2104 / 84 Jason C. Messenger 1369 / 571 3.00

12 2104 / 83 Ronald Deem 1465 / 242 0.52

13 2104 / 53 David C. Nestor 1004 / 820 ---

14 2104 / 43 Lost Creek Farmers 835 / 454 ---

15 2104 / 52 George W. Dawson 1603 / 200 0.30

16 2104 / 51 Harrison County Commission 1475 / 585 ---

17 2104 / 50 Town of Lost Creek 1110 / 487 ---

18 2104 / 49 Amber Rose Shisler 1638 / 448 ---

19 2104 / 48 April Dawn Maxwell 1632 / 1102 ---

20 2104 / 42 Mary Ann Bowyer 1360 / 294 ---

21 2104 / 41 Mary Ann Bowyer 1412/1290 ---

22 2104 / 40 Mary Ann Bowyer 1398 / 309 ---

23 2104 / 33.1 Timothy Riffle 1418 / 1310 ---

24 426 / 68 Kelvin G. & Diana Williston 1514 / 633 0.06

25 426 / 69 Natalie J. Hirsch 1557 / 100 0.15

26 426 / 70 Sharon L. McMillion Glasscock 1369 / 1001 1.54

27 426 / 79 William Lynn Snyder 1022 / 1098 22.00

28 426 / 68.1 Thomas McCormick 1509 / 289 1.25

29 426 / 70.1 Dorothy Dawson 1621/810 ---

30 426 / 67 Dorothy Dawson W148 / 1062 14.97

31 426 / 61 Cemetery 198 / 341 0.59

32 426 / 59.1 Charles R. Sutton & Frank L. Sutton 1401 / 913 2.28

33 426 / 59 Charles R. Sutton & Frank L. Sutton 1401 / 913 1.60

34 426 / 58 George W. & Amy J. Dawson 1207 / 170 2.58

35 426 / 60 Jeffrey D. & Nancy C. McClure 1434 / 142 7.00

36 426 / 62 Dorothy Dawson W148 / 1062 16.13

37 2101 / 42 Jeffery D. & Nancy C. McClure 1.94 1.95

38 2101 / 65 George W. & Amy J. Dawson 1207 / 170 ---

39 2101 / 64 George W. & Amy J. Dawson 1207 / 17 ---

40 2101 / 27 George W. & Amy J. Dawson 1207 / 170 ---

41 2101 / 26 George W. & Amy J. Dawson 1207 / 170 ---

42 2101 / 25 George W. & Amy J. Dawson 1207 / 170 ---

43 2101 / 66 George W. & Amy J. Dawson 1207 / 170 ---

44 2101 / 67 George W. & Amy J. Dawson 1207 / 170 ---

45 2101 / 61 Donald H. & Joyce Bennett 1594 / 145 ---

46 2101 / 58 MBW, LLC 1539 / 573 ---

47 2101 / 1 MBW LLC 1539 / 573 3.62

48 2101 / 28 David L. Coffindaffer, et al F116 / 276 ---

49 2101 / 29 David L. Coffindaffer, et al F116 / 276 ---

50 2101 / 30 Donald H. & Joyce Bennett 1594 / 145 ---



| No. | TM / Par  | Owner                         | Bk / Pg     | Ac.  |
|-----|-----------|-------------------------------|-------------|------|
| 51  | 2101 / 31 | Donald H. & Joyce Bennett     | 1594 / 145  | ---  |
| 52  | 2101 / 68 | Donald H. & Bennett, et ux    | 1460 / 618  | ---  |
| 53  | 2101 / 41 | Donald H. & Bennett, et ux    | 1460 / 618  | ---  |
| 54  | 2101 / 40 | Donald H. & Bennett, et ux    | 1460 / 618  | ---  |
| 55  | 2101 / 32 | Donald H. & Joyce Bennett     | 1597 / 1299 | ---  |
| 56  | 2101 / 33 | Donald H. & Joyce Bennett     | 1597 / 1299 | ---  |
| 57  | 2101 / 34 | Donald H. & Joyce Bennett     | 1597 / 129  | ---  |
| 58  | 2101 / 35 | Donald H. & Joyce Bennett     | 1597 / 1299 | ---  |
| 59  | 2101 / 36 | Donald H. & Joyce Bennett     | 1597 / 1299 | ---  |
| 60  | 2101 / 37 | Donald H. & Joyce Bennett     | 1597 / 1299 | ---  |
| 61  | 2101 / 39 | Donald H. & Joyce Bennett     | 1597 / 1299 | ---  |
| 62  | 2101 / 38 | Donald H. & Joyce Bennett     | 1597 / 1299 | ---  |
| 63  | 2101 / 43 | Jeffery D. & Nancy C. McClure | 1434 / 142  | 1.94 |
| 64  | 2101 / 44 | Jeffery D. & Nancy C. McClure | 1434 / 142  | 1.94 |
| 65  | 2101 / 45 | James C. & Dawn M. Daneil     | 1334 / 796  | ---  |
| 66  | 2101 / 46 | James C. & Dawn M. Daneil     | 1334 / 796  | ---  |
| 67  | 2101 / 47 | James C. & Dawn M. Daneil     | 1334 / 796  | ---  |
| 68  | 2101 / 48 | James C. & Dawn M. Daneil     | 1334 / 796  | ---  |
| 69  | 2101 / 2  | David L. Coffindaffer, et al  | F116 / 276  | ---  |
| 70  | 2101 / 5  | Christa Rose Burrows          | 1304 / 111  | ---  |
| 71  | 2101 / 6  | Christa Rose Burrows          | 1304 / 111  | ---  |
| 72  | 2101 / 9  | Christa Rose Burrows          | 1304 / 111  | ---  |
| 73  | 2101 / 8  | Christa Rose Burrows          | 1304 / 111  | ---  |
| 74  | 2101 / 7  | Christa Rose Burrows          | 1304 / 111  | ---  |
| 75  | 2101 / 49 | James C. & Dawn M. Daneil     | 1334 / 796  | ---  |
| 76  | 2101 / 50 | James C. & Dawn M. Daneil     | 1334 / 796  | ---  |
| 77  | 2101 / 51 | James C. & Dawn M. Daneil     | 1334 / 796  | ---  |
| 78  | 2101 / 52 | James C. & Dawn M. Daneil     | 1334 / 796  | ---  |
| 79  | 2101 / 53 | James C. & Dawn M. Daneil     | 1334 / 796  | ---  |
| 80  | 2101 / 54 | James C. & Dawn M. Daneil     | 1334 / 796  | ---  |
| 81  | 2101 / 55 | James C. & Dawn M. Daneil     | 1334 / 796  | ---  |
| 82  | 2101 / 56 | James C. & Dawn M. Daneil     | 1334 / 796  | ---  |
| 83  | 2101 / 57 | James C. & Dawn M. Daneil     | 1334 / 796  | ---  |

| No. | TM / Par   | Owner                                  | Bk / Pg     | Ac.    |
|-----|------------|----------------------------------------|-------------|--------|
| 84  | 2101 / 12  | James C. & Dawn M. Daneil              | 1334 / 79   | ---    |
| 85  | 2101 / 11  | Hubert N. Riffle                       | 1368 / 784  | ---    |
| 86  | 2101 / 10  | Hubert N. Riffle                       | 1368 / 784  | ---    |
| 87  | 2101 / 13  | Hubert N. Riffle                       | 1368 / 784  | ---    |
| 88  | 2101 / 14  | Hubert N. Riffle                       | 1368 / 784  | ---    |
| 89  | 2101 / 15  | Hubert N. Riffle                       | 1368 / 784  | ---    |
| 90  | 2101 / 16  | Hubert N. Riffle                       | 1368 / 784  | ---    |
| 91  | 2101 / 17  | Hubert N. Riffle                       | 1368 / 784  | ---    |
| 92  | 2101 / 18  | James C. & Dawn M. Daniel              | 1334 / 796  | ---    |
| 93  | 426 / 56   | Hubert N. Riffle                       | 1368 / 784  | 0.72   |
| 94  | 426 / 55   | Hubert N. Riffle                       | 1368 / 784  | 1.24   |
| 95  | 426 / 54   | Charles R. Lindsay                     | 1577 / 503  | 0.58   |
| 96  | 426 / 35.9 | MBW, LLC                               | 1539 / 573  | 12.77  |
| 97  | 426 / 53   | Charles A. Compton, II                 | 1046 / 337  | 5.43   |
| 98  | 426 / 52   | Amy Dawson, et al                      | 1262 / 1286 | 0.83   |
| 99  | 426 / 36   | George W. & Amy J. Dawson              | 1310 / 247  | 61.96  |
| 100 | 427 / 1    | Walter E. Nutter & David H. Nutter     | W154 / 301  | 228.23 |
| 101 | 426 / 35.7 | Bernard Bennet, II                     | 1236 / 76   | 0.83   |
| 102 | 426 / 35.5 | Lost Creek Salvage, LLC                | 1503 / 933  | 11.53  |
| 103 | 426 / 35.8 | Lost Creek Salvage, LLC                | 539 / 1088  | 85.23  |
| 104 | 426 / 12   | Annette J. Cobun                       | 1496 / 38   | 84.79  |
| 105 | 406 / 47   | Annette J. Cobun                       | 1496 / 39   | 72.13  |
| 106 | 406 / 24   | Clarence Howe Woodford II, et al       | 414 / 352   | 160.49 |
| 107 | 406 / 25   | Jennifer A. Wright & David E. Bush Jr. | 1496 / 1040 | 0.29   |
| 108 | 406 / 23   | Roger L. & Teri A. Wilmoth             | 1332 / 1017 | 68.86  |
| 109 | 406 / 27   | James Stout                            | W161 / 306  | 43.50  |
| 110 | 406 / 9.2  | Mary Elizabeth Stenger                 | 1262 / 1076 | 0.72   |
| 111 | 406 / 9.1  | Joseph A. Jr. & Kellie M. Shuttleworth | 1318 / 298  | 8.51   |
| 112 | 406 / 9    | John Louis & Mary Elizabeth Stenger    | 1580 / 205  | 309.00 |
| 113 | 406 / 21   | Robert K. Lowther                      | 1427 / 565  | 17.44  |
| 114 | 2101 / 24  | George W. & Amy J. Dawson              | 1207 / 170  | ---    |
| 115 | 2101 / 23  | George W. & Amy J. Dawson              | 1207 / 170  | ---    |
| 116 | 426 / 51   | MBW, LLC                               | 1539 / 573  | 3.60   |

FILE NO: 32-36-G-19  
 DRAWING NO: Schoen 1205 N3H Well Plat  
 SCALE: 1" = 2000'  
 MINIMUM DEGREE OF ACCURACY:  
 Submeter  
 PROVEN SOURCE OF ELEVATION:  
 CORS, Bridgeport, WV

STATE OF WEST VIRGINIA  
 DEPARTMENT OF ENVIRONMENTAL PROTECTION  
 OIL AND GAS DIVISION

DATE: May 14 20 25  
 OPERATOR'S WELL NO. Schoen 1205 N-3H  
 API WELL NO  
 47 — 033 — 06007  
 STATE COUNTY PERMIT

WELL TYPE: ☐ OIL ☒ GAS ☐ LIQUID INJECTION ☐ WASTE DISPOSAL  
 (IF GAS) PRODUCTION: ☐ STORAGE ☐ DEEP ☒ SHALLOW

LOCATION: ELEVATION: 1,407.3' WATERSHED: Middle West Fork Creek  
 DISTRICT: Grant / Union  
 SURFACE OWNER: George & Rosanne Schoen  
 ROYALTY OWNER: Willa Post Robey, et al LEASE NO: ACREAGE: 78.20

PROPOSED WORK: ☒ DRILL ☐ CONVERT ☐ DRILL DEEPER ☐ FRACTURE OR STIMULATE ☐ PLUG OFF OLD FORMATION  
☐ PERFORATE NEW FORMATION ☒ OTHER PHYSICAL CHANGE IN WELL (SPECIFY) As-Drilled  
☐ PLUG AND ABANDON ☐ CLEAN OUT AND REPLUG TARGET FORMATION: Marcellus Shale ESTIMATED DEPTH: 24,570' MD

WELL OPERATOR: HG Energy II Appalachia, LLC  
 ADDRESS: 5260 Dupont Road  
 Parkersburg, WV 26101

DESIGNATED AGENT: Diane C. White  
 ADDRESS: 5260 Dupont Road  
 Parkersburg, WV 26101

Top: Mount Clare  
 Btm: West Milford  
 QUADRANGLE: Harrison  
 COUNTY: Harrison  
 ACREAGE: 65.00  
 09/19/2025