



West Virginia Department of Environmental Protection
Office of Oil and Gas
WELL LOCATION FORM: GPS

API: 47-033-70946 WELL NO.: WV 597713 (G. M. Dye #4074)

FARM NAME: G. M. Dye

RESPONSIBLE PARTY NAME: EQT Production Company

COUNTY: Harrison DISTRICT: Sardis

QUADRANGLE: Wallace 7.5'

SURFACE OWNER: Kelly Dean Clayton & Margalo Clayton

ROYALTY OWNER: Charleston National Bank, for the benefit of
Tetrick Mineral Properties

UTM GPS NORTHING: 4360947

UTM GPS EASTING: 546130 GPS ELEVATION: 319 m (1049 ft)

The Responsible Party named above has chosen to submit GPS coordinates in lieu of preparing a new well location plat for a plugging permit or assigned API number on the above well. The Office of Oil and Gas will not accept GPS coordinates that do not meet the following requirements:

- Datum: NAD 1983, Zone: 17 North, Coordinate Units: meters, Altitude: height above mean sea level (MSL) – meters.
- Accuracy to Datum – 3.05 meters
- Data Collection Method:

Survey grade GPS _____ : Post Processed Differential _____
 Real-Time Differential _____
 Mapping Grade GPS X : Post Processed Differential X
 Real-Time Differential _____

RECEIVED
Office of Oil and Gas
MAR 25 2021
WV Department of
Environmental Protection

4. Letter size copy of the topography map showing the well location.

I the undersigned, hereby certify this data is correct to the best of my knowledge and belief and shows all the information required by law and the regulations issued and prescribed by the Office of Oil and Gas.


Signature

PS # 2100
Title

1/28/2021
Date

Topo Quad: Wallace 7.5'

Scale: 1" = 2000'

4703306008

County: Harrison


Date: January 29, 2021

District: Sardis

Project No: 70-36-00-08

47-033-70946 WV 597713 (G. M. Dye #4074)

Topo

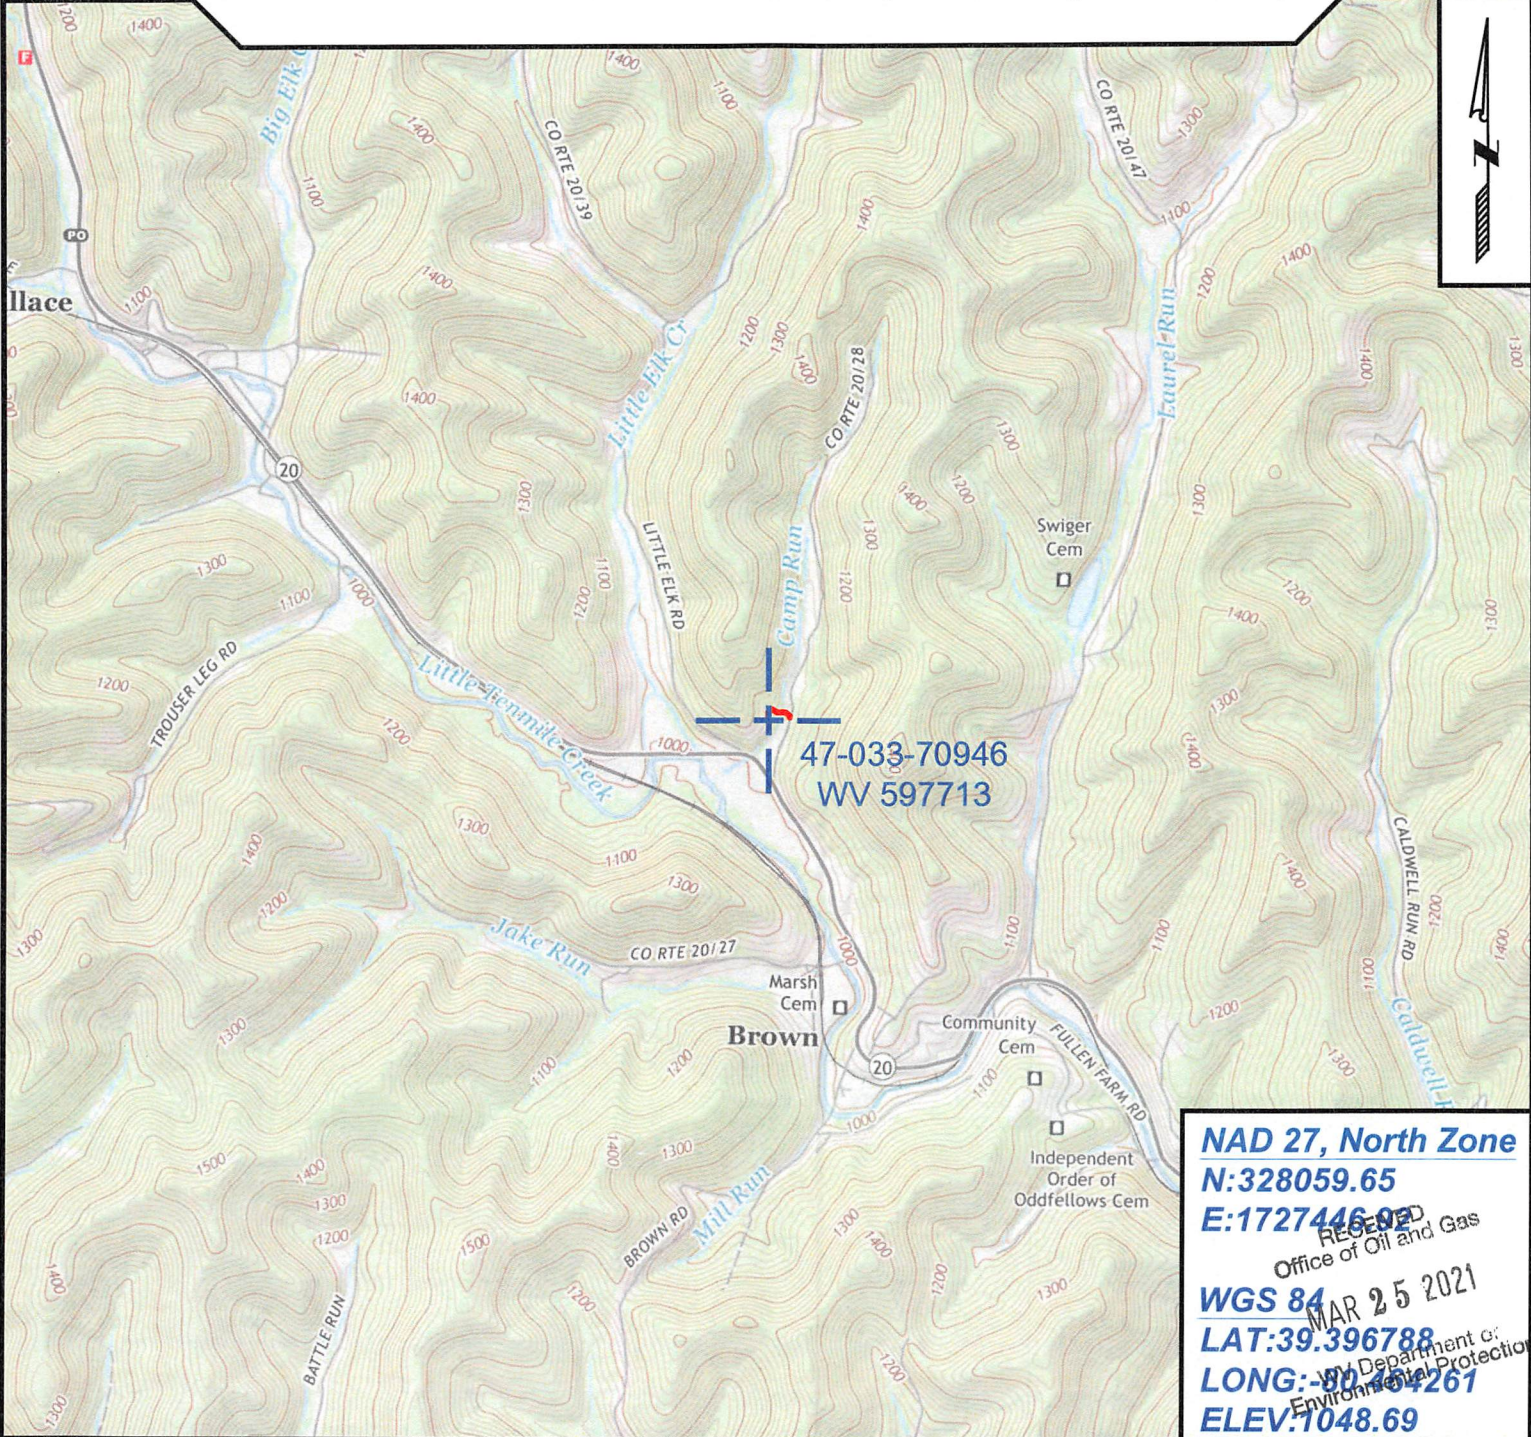

47-033-70946
WV 597713

NAD 27, North Zone
N:328059.65
E:1727446.02
 RECEIVED
 Office of Oil and Gas
WGS 84
LAT:39.396788
LONG:-80.464261
ELEV:1048.69
 MAR 25 2021
 U.S. Department of
 Environmental Protection



SURVEYING AND MAPPING SERVICES PERFORMED BY:

ALLEGHENY SURVEYS, INC.

1-800-482-8606
 237 Birch River Road
 Birch River, WV 26610
 PH: (304) 649-8606
 FAX: (304) 649-8608

PREPARED FOR:

EQT Production Company

400 Woodcliff Drive
 Canonsburg, PA 15317

06/18/2021