

LGD WELL PAD WELL NO. 204 ARSENAL RESOURCES

T.H. LATITUDE 39°17'30"
B.H. LATITUDE 39°15'00"

CURVE	RADIUS	ARC LENGTH	CHORD LENGTH	CHORD BEARING
C1	72.84'	17.18'	17.14'	N 83°57' E
C2	622.53'	135.15'	134.88'	N 70°01' E
C3	315.58'	242.27'	236.37'	N 88°16' E
C4	585.87'	292.08'	289.16'	S 55°41' E
C5	1053.45'	472.01'	468.07'	S 29°15' E

NOTES ON SURVEY

1. NO WATER WELLS WERE FOUND WITHIN 250' OF PROPOSED GAS WELL. NO AGRICULTURAL BUILDINGS > 2500 SQ. FT. OR DWELLINGS WERE FOUND WITHIN 625' OF THE CENTER OF PROPOSED WELL PAD.
2. WELL SPOT CIRCLE & TOPO MARK SCALE ARE 1"=2000'.
3. AS-DRILLED DATA PROVIDED BY ARSENAL RESOURCES
4. PLAT UPDATED TO SHOW AS-DRILLED PATH.

(S.P.C. NORTH ZONE) (UTM(M) ZONE 17)
NAD'83 S.P.C.(FT) N. 279,242.52 E. 1,723,456.00
NAD'83 GEO. LAT-(N) 39.263430 LONG-(W) 80.365469
NAD'83 UTM (M) N. 4,348,202.2 E. 554,741.1
LANDING POINT
NAD'83 S.P.C.(FT) N. 280,356.7 E. 1,726,983.2
NAD'83 GEO. LAT-(N) 39.266582 LONG-(W) 80.353049
NAD'83 UTM (M) N. 4,348,559.5 E. 555,810.0
BOTTOM HOLE
NAD'83 S.P.C.(FT) N. 263,603.8 E. 1,732,852.5
NAD'83 GEO. LAT-(N) 39.220739 LONG-(W) 80.331772
NAD'83 UTM (M) N. 4,341,485.3 E. 557,683.1

LINE	BEARING	DISTANCE
L1	N 89°59' E	238.89'
L2	N 65°24' E	2935.87'
L3	S 19°02' E	17290.48'
L4	N 64°46' W	414.55'
L5	S 72°01' E	429.89'

AS DRILLED COORDINATES FOR WELL NO. 204

(S.P.C. NORTH ZONE) (UTM(M) ZONE 17)
NAD'83 S.P.C.(FT) N. 279,242.52 E. 1,723,456.00
NAD'83 GEO. LAT-(N) 39.263430 LONG-(W) 80.365469
NAD'83 UTM (M) N. 4,348,202.2 E. 554,741.1
LANDING POINT
NAD'83 S.P.C.(FT) N. 279,782.3 E. 1,727,248.1
NAD'83 GEO. LAT-(N) 39.265011 LONG-(W) 80.352085
NAD'83 UTM (M) N. 4,348,385.9 E. 555,893.6
BOTTOM HOLE
NAD'83 S.P.C.(FT) N. 263,690.7 E. 1,732,827.1
NAD'83 GEO. LAT-(N) 39.220977 LONG-(W) 80.331864
NAD'83 UTM (M) N. 4,341,511.7 E. 557,674.9

B.H.A.D.

T.H.A.D.

RECEIVED
Office of Oil and Gas


JUL 23 2025

WV Department of
Environmental Protection



12 Vanhorn Drive | P.O. Box 150 | Glenville, WV 26031 | 304.462.5534
1412 Kanawha Boulevard, East | Charleston, WV 25301 | 304.346.3952
254 East Beckley Bypass | Beckley, WV 25801 | 304.255.5286
slsvr.com


REFERENCES

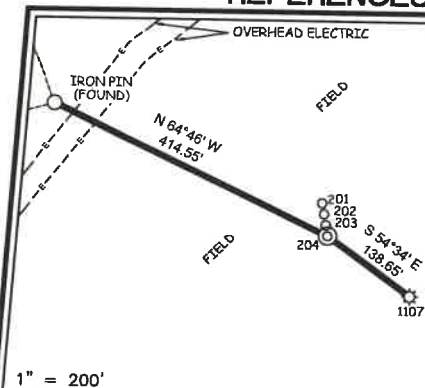

I THE UNDERSIGNED, HEREBY CERTIFY THAT THIS PLAT IS CORRECT TO THE BEST OF MY KNOWLEDGE AND BELIEF AND SHOWS ALL THE INFORMATION REQUIRED BY LAW AND THE REGULATIONS ISSUED AND PRESCRIBED BY THE DIVISION OF ENVIRONMENTAL PROTECTION.

P.S.
677

Gregory A. Smith

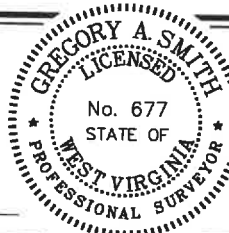

(*) DENOTES LOCATION OF WELL ON UNITED STATES TOPOGRAPHIC MAPS
DATE SEPTEMBER 11, 20 24
REVISED JUNE 1, 20 25
OPERATORS WELL NO. 204

API WELL NO. 47-033-06040
STATE COUNTY PERMIT

MINIMUM DEGREE OF ACCURACY 1/2500 FILE NO. 9423P204AD.dwg

HORIZONTAL & VERTICAL SCALE 1" = 2000'
CONTROL DETERMINED BY: DGPS (SURVEY GRADE TIE TO CORS NETWORK)

STATE OF WEST VIRGINIA
DIVISION OF ENVIRONMENTAL PROTECTION
OFFICE OF OIL AND GAS



WELL TYPE: OIL ___ GAS ☒ LIQUID WASTE IF
INJECTION ___ DISPOSAL ___ "GAS" PRODUCTION ☒ STORAGE ___ DEEP ___ SHALLOW ☒

LOCATION: ELEVATION 1,007.60' WATERSHED WEST FORK RIVER

DISTRICT CLARK COUNTY HARRISON QUADRANGLE CLARKSBURG

SURFACE OWNER LAURA GOFF DAVIS ACREAGE 161.22±

ROYALTY OWNER LAURA GOFF DAVIS, ET AL ACREAGE 400±

PROPOSED WORK: LEASE NO. SEE WW-6A1

DRILL ☒ CONVERT ___ DRILL DEEPER ___ REDRILL ___ FRACTURE OR STIMULATE ☒ PLUG OFF OLD

FORMATION ___ PERFORATE NEW FORMATION ___ PLUG AND ABANDON ___ CLEAN OUT AND REPLUG ___ OTHER ___

PHYSICAL CHANGE IN WELL (SPECIFY) TARGET FORMATION MARCELLUS

ESTIMATED DEPTH TMD 25,900.00' / TVD 7,156.01'

WELL OPERATOR ARSENAL RESOURCES DESIGNATED AGENT ERIC MORRIS
ADDRESS 6031 WALLACE RD. EXT. SUITE 200 ADDRESS 633 WEST MAIN STREET
WEXFORD, PA 15090 BRIDGEPORT, WV 26330

09/19/2025

RECEIVED
Office of Oil and Gas

JUL 23 2025

WV Department of
Environmental Protection

NAD 83 GRID NORTH

FORM WW 6 - SHEET 2 OF 4

11,388' B.H.A.D.

9,099' T.H.A.D.

T.H. LATITUDE 39°17'30"
B.H. LATITUDE 39°15'00"



**LGD WELL PAD
WELL NO. 204
ARSENAL RESOURCES**

LEGEND
AS DRILLED ———
PROPOSED - - - - -

T.H. LONGITUDE 80°20'00"
B.H. LONGITUDE 80°17'30"


10,285' T.H.A.D.

10,571' B.H.A.D.

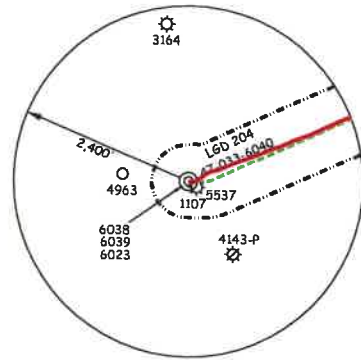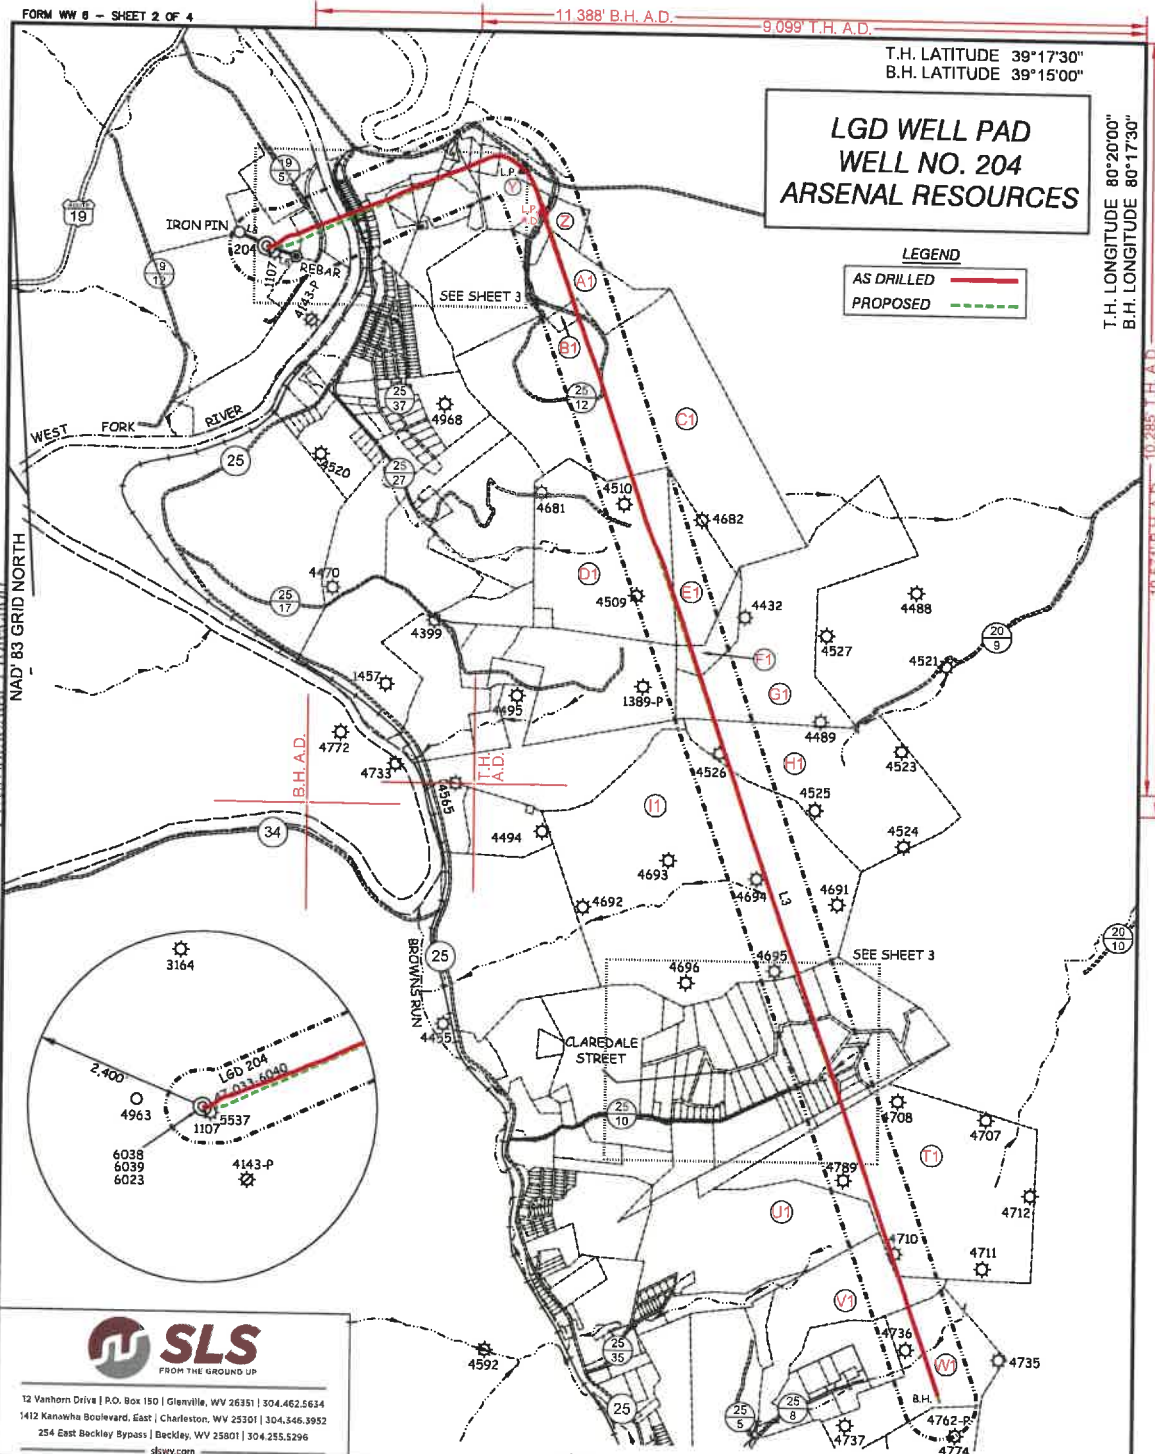

12 Vanhorn Drive | P.O. Box 150 | Glenville, WV 26031 | 304.462.5634
1412 Kanawha Boulevard, East | Charleston, WV 25301 | 304.546.3952
254 East Beckley Bypass | Beckley, WV 25801 | 304.255.5296
slsuv.com

(S.P.C. NORTH ZONE) (UTM(M) ZONE 17)			
NAD'83 S.P.C.(FT)	N. 279,242.52	E. 1,723,456.00	
NAD'83 GEO.	LAT-(N) 39.263430	LONG-(W) 80.365469	
NAD'83 UTM (M)	N. 4,346,202.2	E. 554,741.1	
LANDING POINT			
NAD'83 S.P.C.(FT)	N. 280,356.7	E. 1,726,989.2	
NAD'83 GEO.	LAT-(N) 39.266582	LONG-(W) 80.353049	
NAD'83 UTM (M)	N. 4,346,559.5	E. 555,810.0	
BOTTOM HOLE			
NAD'83 S.P.C.(FT)	N. 283,003.8	E. 1,732,852.5	
NAD'83 GEO.	LAT-(N) 39.220739	LONG-(W) 80.331772	
NAD'83 UTM (M)	N. 4,341,485.3	E. 557,983.1	
SCALE 1" = 2000' FILE NO. 9423P204AD.dwg			
DATE SEPTEMBER 11, 2024			
REVISED JUNE 1, 2025			
OPERATORS WELL NO. 204			
API WELL NO. 47-033-06040			
STATE COUNTY PERMIT			

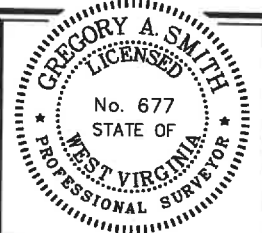

STATE OF WEST VIRGINIA
DIVISION OF
ENVIRONMENTAL PROTECTION
OFFICE OF OIL AND GAS

(+) DENOTES LOCATION OF WELL ON UNITED STATES TOPOGRAPHIC MAPS
P.S. 677 Gregory A. Smith

LEGEND
LEASE LINE
SURFACE LINE
WELL LATERAL
500' OFFSET LINE
TIE LINE
CREEK
ROAD
COUNTY ROUTE
PROPOSED WELL
EXISTING WELL
PERMITTED WELL
TAX MAP-PARCEL
SURFACE OWNER (SEE TABLE)
LEASE # (SEE WW-6A1)

COUNTY NAME
PERMIT


WELL OPERATOR ARSENAL RESOURCES
ADDRESS 6031 WALLACE RD. EXT. SUITE 200
WEXFORD, PA 15090
DESIGNATED AGENT ERIC MORRIS
ADDRESS 633 WEST MAIN STREET
BRIDGEPORT, WV 26330

09/19/2025


**LGD WELL PAD
WELL NO. 204
ARSENAL RESOURCES**



12 Vanhorn Drive | P.O. Box 150 | Glenville, WV 26351 | 304.462.5634
1412 Kanawha Boulevard, East | Charleston, WV 25301 | 304.346.3952
254 East Beckley Bypass | Beckley, WV 25801 | 304.255.5296
slsr.com

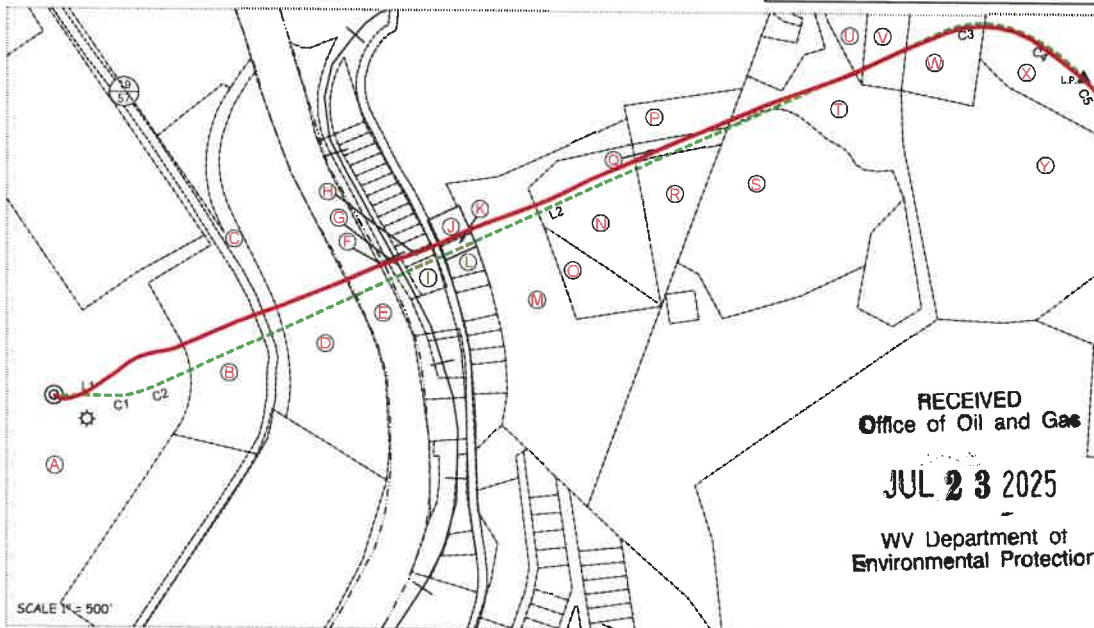

RECEIVED
Office of Oil and Gas
JUL 23 2025
WV Department of
Environmental Protection

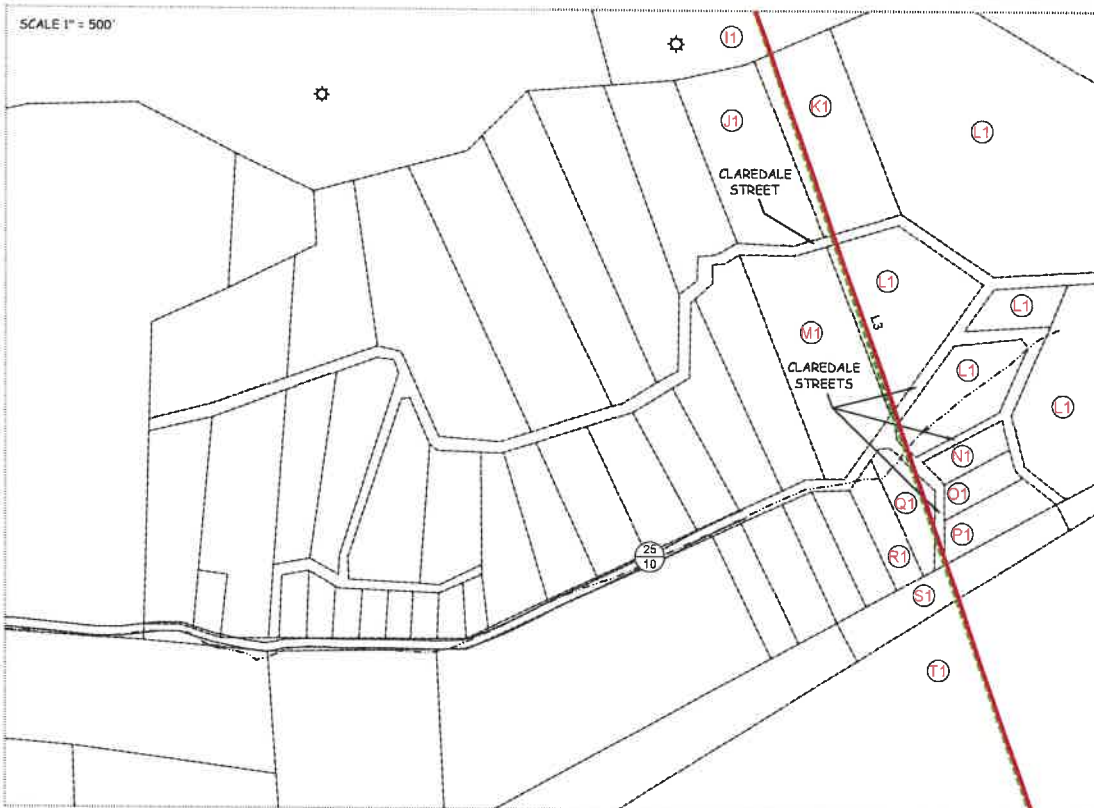


FILE NO. 9423P204AD.dwg

DATE SEPTEMBER 11, 20 24

REVISED JUNE 1, 20 25

OPERATORS WELL NO. 204

API WELL NO. 47 — 033 — 06040
STATE COUNTY PERMIT

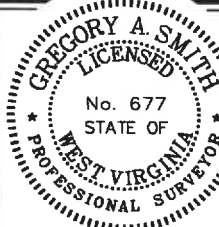

STATE OF WEST VIRGINIA
DIVISION OF
ENVIRONMENTAL PROTECTION
OFFICE OF OIL AND GAS



P.S.
677

Gregory A. Smith

COUNTY NAME

PERMIT

WELL OPERATOR ARSENAL RESOURCES
ADDRESS 6031 WALLACE RD. EXT. SUITE 200
WEXFORD, PA 15090

DESIGNATED AGENT ERIC MORRIS
ADDRESS 633 WEST MAIN STREET
BRIDGEPORT, WV 26330

09/19/2025

**LGD WELL PAD
WELL NO. 204
ARSENAL RESOURCES**



12 Vanhorn Drive | P.O. Box 150 | Glenville, WV 28351 | 304.462.5634
1412 Kanawha Boulevard, East | Charleston, WV 25301 | 304.346.5952
254 East Beckley Bypass | Beckley, WV 25801 | 304.255.5298
sbsvva.com

TAG	PARCEL	SURFACE OWNER/ROAD/RIVER	ACREAGE
A	1-326-37	LAURA GOFF DAVIS	161.22
B	1-326-37.3	SHAFFER ENTERPRISES INC	3.82
ROAD	N/A	COUNTY ROUTE 19/57-ARMORY ROAD	N/A
C	1-326-85	GENERAL CORPORATION	1.45
D	1-326-38	GENERAL CORPORATION	8.21
E	N/A	WEST FORK RIVER	N/A
F	1-115-14	MINNIE REED WHALEY	LOT 1
G	1-326-102	W.V. STATE RAIL AUTHORITY	108.47
H	1-115-24	PAMELA J HARRIS	LOT 13
I	1-115-26	RICHARD A & EDITH M BENNETT	LOTS 14,15,16
ROAD	N/A	COUNTY ROUTE 25-WESTON FAIRMONT TURNPIKE	N/A
J	1-115-21	MICHAEL W & PAMELA J HARRIS	LOT 100 X 120
K	1-115-23	MICHAEL W & PAMELA J HARRIS	LOT 50 X 120
L	1-115-27	ALLEN W & ELIZABETH COMPTON	0.35
M	1-326-84.2	CHARLES & DEBRA MCCLUNG	9.3
N	1-326-43.3	MICHAEL J & MARTA L HODGE	3.07
O	1-326-43.4	MICHAEL J & MARTA L HODGE	1.1
P	1-326-43.6	LISA D & JASON B MENENDEZ	1.11
Q	1-326-43.5	LISA D MENENDEZ ET AL	0.43
R	1-326-43.2	LISA D MENENDEZ ET AL	1.69
S	1-326-44.5	AMY MACCOLEMAN	7.88
T	1-326-44	WVTD LLC	11.58
U	1-326-44.4	GENA HILL DAVIS	1.25
V	1-326-44.3	FERRELL FAMILY PARTNERSHIP	1.33
W	1-327-6.1	MARK A & ANN D WANSTREET	1.66
X (ROAD)	N/A	W.V. ROUTE 98	N/A
Y	1-327-6	MARK A & ANN D WANSTREET	12.29
ROAD	N/A	COUNTY ROUTE 25/12- EAGLE WAY	N/A
Z	1-327-7	ERNST P HALL JR	8.56
A1	1-327-15	JOYCE PROPERTIES INC	26.29
B1	1-327-14	JOYCE PROPERTIES INC	2.385
C1	3-326-26	HARRISON COUNTY BOARD OF EDUCATION	185.84
D1	1-347-5	MICHAEL E & MELISSA L WHITE	94.4
E1	1-347-6	MICHAEL E & MELISSA L WHITE	29.8
F1	1-347-7	MICHAEL E & MELISSA L WHITE	10
G1	1-347-8	ROGER & BETTY PHILLIPS	93.96
H1	1-347-33	KURT G SKASIK & MARK ADAM SKASIK	93.35
I1	12-347-32	WV DNR	245.15
J1	12-347-48	MICHAEL W & MARY M BALL	LOT 42
K1	12-347-49	MICHAEL W & MARY M BALL	LOT 41
ROAD	N/A	STREETS IN CLAREDALE SUBDIVISION	N/A
L1	12-347-50	MICHAEL W & MARY M BALL	39.88
M1	12-347-87	MICHAEL W & MARY M BALL	5
N1	12-367-18	MICHAEL W & MARY M BALL	LOT 24
O1	12-367-19	MICHAEL W & MARY M BALL	LOT 23
P1	12-367-20	MICHAEL W & MARY M BALL	LOT 22
ROAD	N/A	COUNTY ROUTE 25/10-MT CLARE & NORWOOD RD.	N/A
Q1	12-367-17	MICHAEL W & MARY M BALL	LOT 21
R1	12-367-16	MICHAEL W & MARY M BALL	LOT 20
S1	12-367-15	MICHAEL W & MARY M BALL	2.36
T1	1-367-37	WV DNR	160
U1	12-367-36.1	PERRY H ALLEN ETAL	79
V1	12-367-43	KENNETH W MONEYPENNY	51.415
W1	12-367-55.1	MARK S & MARCIE G BRAGG	56.81

RECEIVED
Office of Oil and Gas

JUL 23 2025

WV Department of
Environmental Protection


FILE NO. 9423P204AD.dwg

DATE SEPTEMBER 11, 20 24

REVISED JUNE 1, 20 25

OPERATORS WELL NO. 204

API WELL NO. 47 — 033 — 06040
STATE COUNTY PERMIT

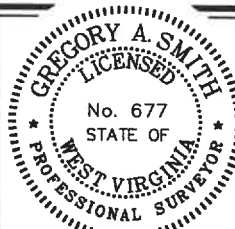

STATE OF WEST VIRGINIA
DIVISION OF
ENVIRONMENTAL PROTECTION
OFFICE OF OIL AND GAS



P.S. 677 Gregory A. Smith

WELL OPERATOR ARSENAL RESOURCES
ADDRESS 6031 WALLACE RD. EXT. SUITE 200
WEXFORD, PA 15090

DESIGNATED AGENT ERIC MORRIS
ADDRESS 633 WEST MAIN STREET
BRIDGEPORT, WV 26330

COUNTY NAME

PERMIT

09/19/2025

**LGD WELL PAD
WELL NO. 204
ARSENAL RESOURCES**T.H. LATITUDE 39°17'30"
B.H. LATITUDE 39°15'00"**NOTES ON SURVEY**

1. NO WATER WELLS WERE FOUND WITHIN 250' OF PROPOSED GAS WELL. NO AGRICULTURAL BUILDINGS > 2500 SQ. FT. OR DWELLINGS WERE FOUND WITHIN 625' OF THE CENTER OF PROPOSED WELL PAD.
2. WELL SPOT CIRCLE & TOPO MARK SCALE ARE 1"=2000'.
3. AS-DRILLED DATA PROVIDED BY ARSENAL RESOURCES
4. PLAT UPDATED TO SHOW AS-DRILLED PATH.

CURVE	RADIUS	ARC LENGTH	CHORD LENGTH	CHORD BEARING
C1	72.84'	17.18'	17.14'	N 83°57' E
C2	622.53'	135.15'	134.88'	N 70°01' E
C3	315.59'	242.27'	236.37'	N 88°16' E
C4	595.87'	292.08'	289.16'	S 55°41' E
C5	1053.45'	472.01'	468.07'	S 29°15' E

LINE	BEARING	DISTANCE
L1	N 89°59' E	238.89'
L2	N 65°24' E	2935.87'
L3	S 19°02' E	17290.48'
L4	N 64°46' W	414.55'
L5	S 72°01' E	429.89'

(S.P.C. NORTH ZONE) (UTM(M) ZONE 17)

NAD'83 S.P.C.(FT) N. 279,242.52 E. 1,723,456.00
NAD'83 GEO. LAT-(N) 39.263430 LONG-(W) 80.365469
NAD'83 UTM (M) N. 4,346,202.2 E. 554,741.1

LANDING POINT

NAD'83 S.P.C.(FT) N. 280,356.7 E. 1,726,983.2
NAD'83 GEO. LAT-(N) 39.266582 LONG-(W) 80.353049
NAD'83 UTM (M) N. 4,346,559.5 E. 555,810.0

BOTTOM HOLE

NAD'83 S.P.C.(FT) N. 263,603.8 E. 1,732,852.5
NAD'83 GEO. LAT-(N) 39.220739 LONG-(W) 80.331772
NAD'83 UTM (M) N. 4,341,485.3 E. 557,683.1

**AS DRILLED COORDINATES
FOR WELL NO. 204****(S.P.C. NORTH ZONE) (UTM(M) ZONE 17)**


NAD'83 S.P.C.(FT) N. 279,242.52 E. 1,723,456.00
NAD'83 GEO. LAT-(N) 39.263430 LONG-(W) 80.365469
NAD'83 UTM (M) N. 4,346,202.2 E. 554,741.1

LANDING POINT


NAD'83 S.P.C.(FT) N. 279,782.3 E. 1,727,248.1
NAD'83 GEO. LAT-(N) 39.265011 LONG-(W) 80.352095
NAD'83 UTM (M) N. 4,346,385.9 E. 555,893.6

BOTTOM HOLE


NAD'83 S.P.C.(FT) N. 263,690.7 E. 1,732,827.1
NAD'83 GEO. LAT-(N) 39.220977 LONG-(W) 80.331864
NAD'83 UTM (M) N. 4,341,511.7 E. 557,674.9

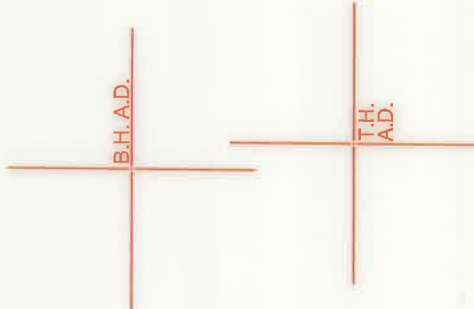

12 Vanhorn Drive | P.O. Box 150 | Glenville, WV 26351 | 304.462.5534
1412 Kanawha Boulevard, East | Charleston, WV 25301 | 304.346.3952
254 East Beckley Bypass | Beckley, WV 25801 | 304.255.5296
slswv.com

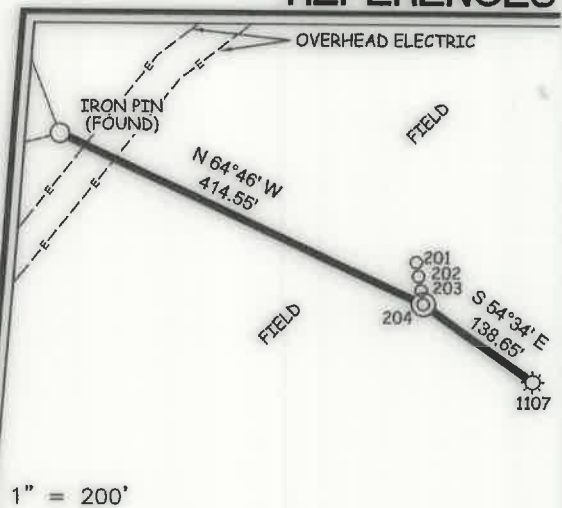REFERENCES

I THE UNDERSIGNED, HEREBY CERTIFY THAT THIS PLAT IS CORRECT TO THE BEST OF MY KNOWLEDGE AND BELIEF AND SHOWS ALL THE INFORMATION REQUIRED BY LAW AND THE REGULATIONS ISSUED AND PRESCRIBED BY THE DIVISION OF ENVIRONMENTAL PROTECTION.

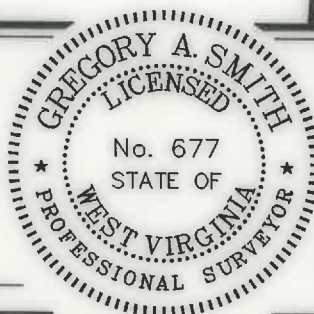P.S.
677

(+) DENOTES LOCATION OF WELL ON UNITED STATES TOPOGRAPHIC MAPS

DATE SEPTEMBER 11, 20 24

REVISED JUNE 1, 20 25

OPERATORS WELL NO. 204

API WELL NO. 47 - 033 - 06040
STATE COUNTY PERMIT

MINIMUM DEGREE OF ACCURACY 1 / 2500 FILE NO. 9423P204AD.dwg

HORIZONTAL & VERTICAL SCALE 1" = 2000'
CONTROL DETERMINED BY: DGPS (SURVEY GRADE TIE TO CORS NETWORK)STATE OF WEST VIRGINIA
DIVISION OF ENVIRONMENTAL PROTECTION
OFFICE OF OIL AND GASWELL TYPE: OIL GAS ☒ LIQUID INJECTION ☐ WASTE DISPOSAL ☐ IF "GAS" PRODUCTION ☒ STORAGE ☐ DEEP ☐ SHALLOW ☒**LOCATION :**

ELEVATION 1,007.60' WATERSHED WEST FORK RIVER

DISTRICT CLARK COUNTY HARRISON QUADRANGLE CLARKSBURG

SURFACE OWNER LAURA GOFF DAVIS

ACREAGE 161.22±

ROYALTY OWNER LAURA GOFF DAVIS, ET AL

ACREAGE 400±

PROPOSED WORK :

LEASE NO. SEE WW-6A1

DRILL ☒ CONVERT ☐ DRILL DEEPER ☐ REDRILL ☐ FRACTURE OR STIMULATE ☒ PLUG OFF OLDFORMATION ☐ PERFORATE NEW FORMATION ☐ PLUG AND ABANDON ☐ CLEAN OUT AND REPLUG ☐ OTHER ☐

PHYSICAL CHANGE IN WELL (SPECIFY) TARGET FORMATION MARCELLUS

ESTIMATED DEPTH TMD 25,900.00' / TVD 7,156.01'

WELL OPERATOR ARSENAL RESOURCES

DESIGNATED AGENT ERIC MORRIS

ADDRESS 6031 WALLACE RD. EXT. SUITE 200
WEXFORD, PA 15090ADDRESS 633 WEST MAIN STREET
BRIDGEPORT, WV 26330

COUNTY NAME

PERMIT

T.H. LATITUDE 39°17'30"
B.H. LATITUDE 39°15'00"LGD WELL PAD
WELL NO. 204
ARSENAL RESOURCES

LEGEND


AS DRILLED

PROPOSED

T.H. LONGITUDE 80°20'00"
B.H. LONGITUDE 80°17'30"

10,571' B.H. A.D. 10,285' T.H. A.D.

NAD'83 GRID NORTH

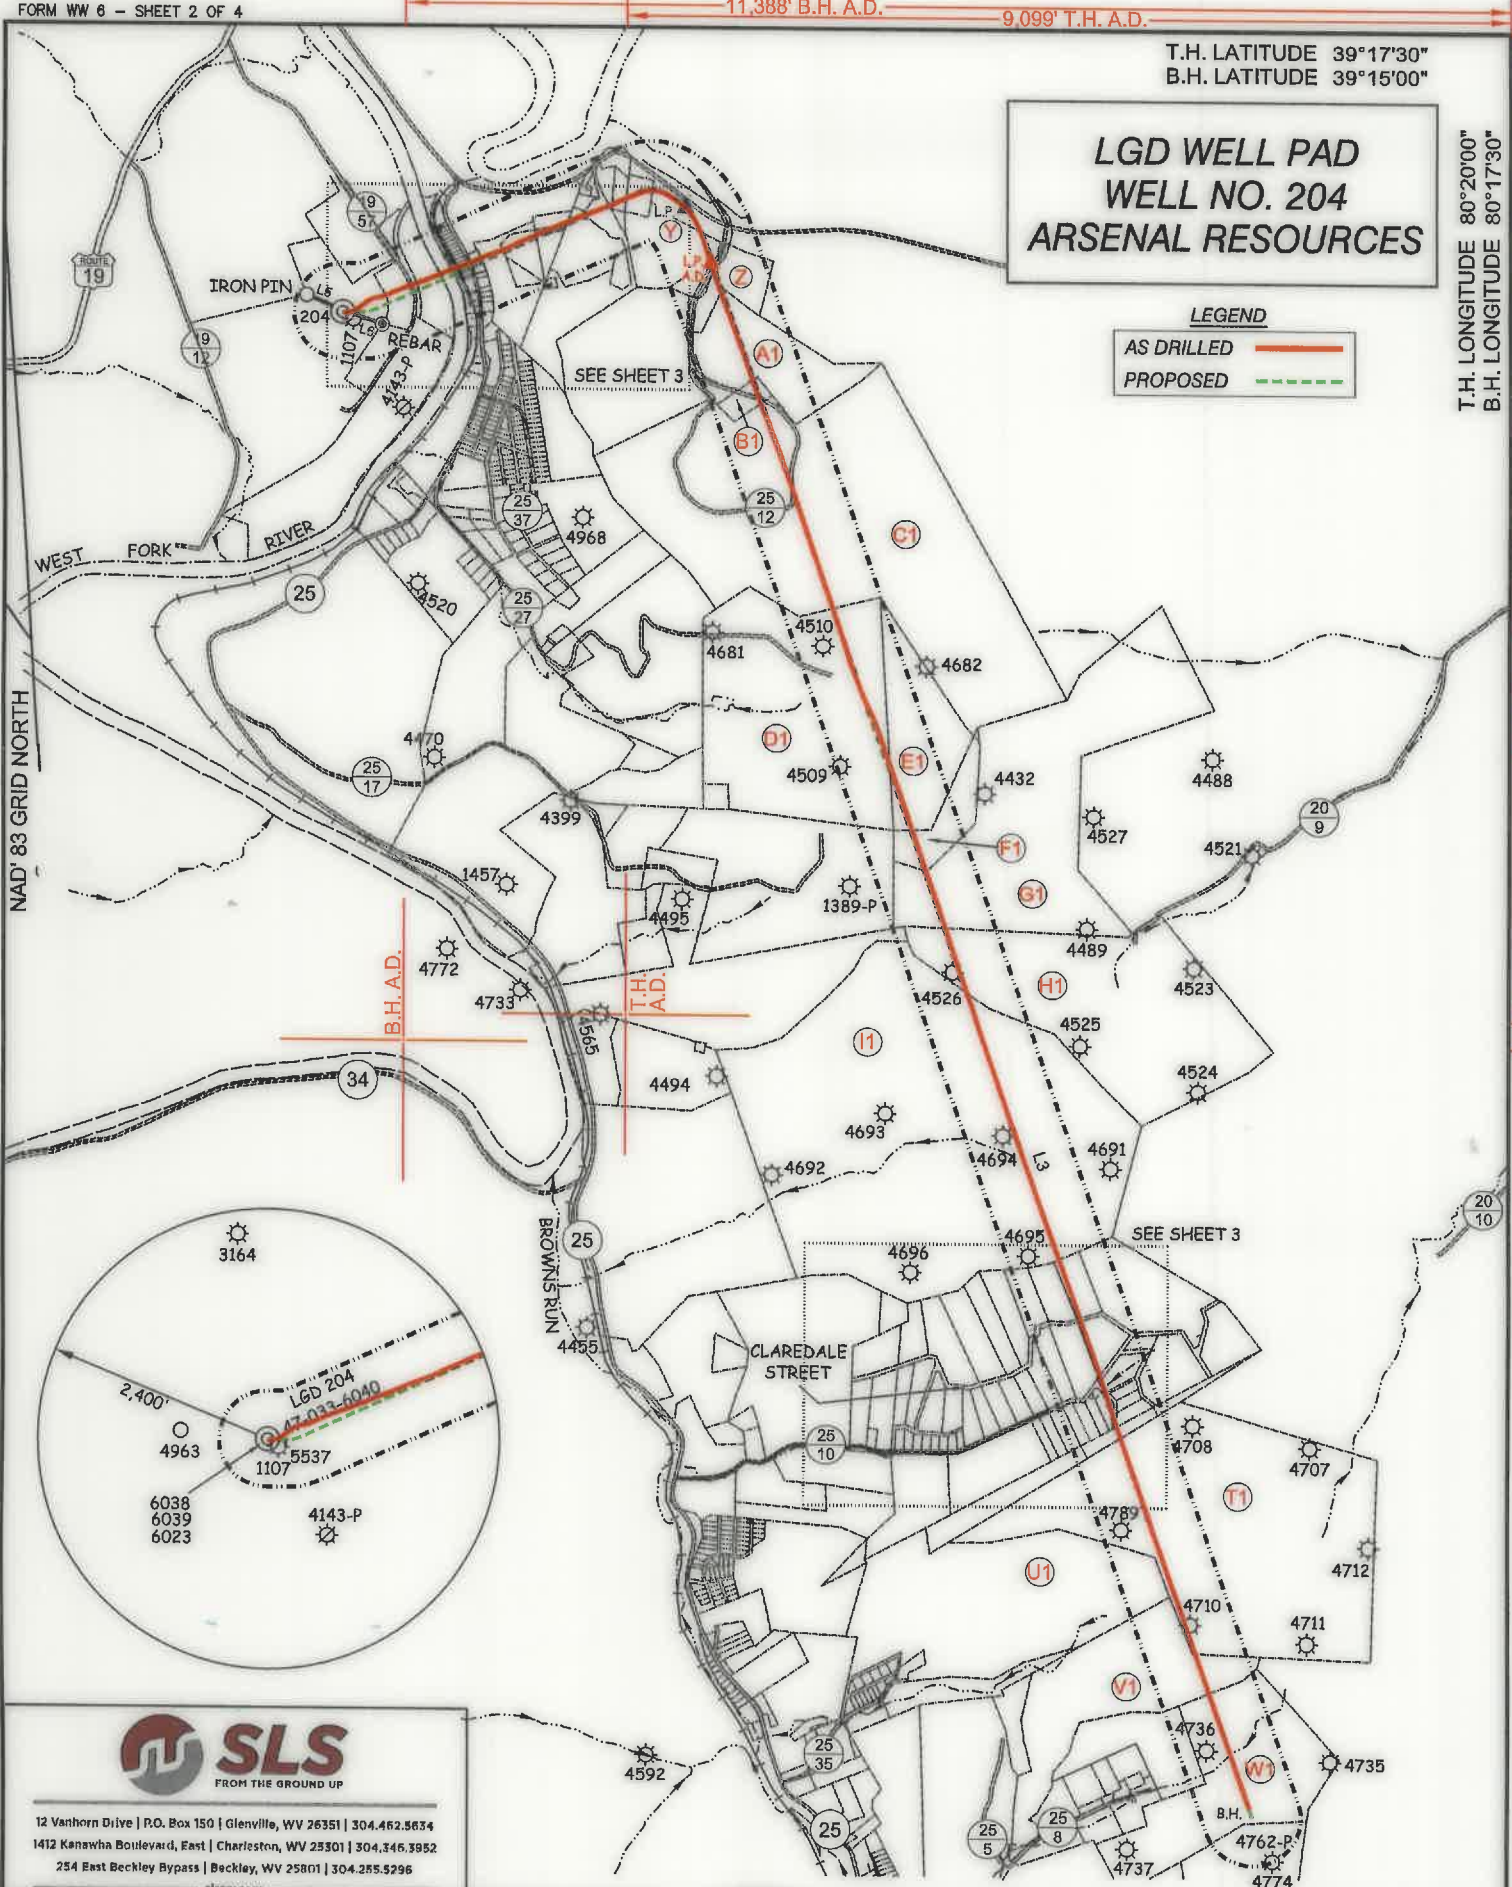12 Vanhorn Drive | P.O. Box 150 | Glenville, WV 26351 | 304.462.5634
1412 Kanawha Boulevard, East | Charleston, WV 25301 | 304.546.9552
254 East Beckley Bypass | Beckley, WV 25801 | 304.255.5296
slswv.com

(S.P.C. NORTH ZONE) (UTM(M) ZONE 17)

NAD'83 S.P.C.(FT) N. 279,242.52 E. 1,723,456.00
NAD'83 GEO. LAT-(N) 39.263430 LONG-(W) 80.365469
NAD'83 UTM (M) N. 4,346,202.2 E. 554,741.1

LANDING POINT

NAD'83 S.P.C.(FT) N. 280,356.7 E. 1,726,983.2
NAD'83 GEO. LAT-(N) 39.266582 LONG-(W) 80.353049
NAD'83 UTM (M) N. 4,346,559.5 E. 555,810.0

BOTTOM HOLE

NAD'83 S.P.C.(FT) N. 263,603.8 E. 1,732,852.5
NAD'83 GEO. LAT-(N) 39.220739 LONG-(W) 80.331772
NAD'83 UTM (M) N. 4,341,485.3 E. 557,683.1

SCALE 1" = 2000' FILE NO. 9423P204AD.dwg

DATE SEPTEMBER 11, 2024

REVISED JUNE 1, 2025

OPERATORS WELL NO. 204

API WELL NO. 47-033-06040
STATE COUNTY PERMIT

WELL OPERATOR ARSENAL RESOURCES

ADDRESS 6031 WALLACE RD. EXT. SUITE 200
WEXFORD, PA 15090STATE OF WEST VIRGINIA
DIVISION OF
ENVIRONMENTAL PROTECTION
OFFICE OF OIL AND GAS

(+) DENOTES LOCATION OF WELL ON UNITED STATES TOPOGRAPHIC MAPS

P.S.
677

Gregory A. Smith

LEGEND

LEASE LINE
SURFACE LINE
WELL LATERAL
500' OFFSET LINE
TIE LINE
CREEK
ROAD
COUNTY ROUTE
PROPOSED WELL
EXISTING WELL
PERMITTED WELL
TAX MAP-PARCEL
SURFACE OWNER (SEE TABLE)
LEASE # (SEE WW-6A1)

09/19/2025





COUNTY NAME

PERMIT

LGD WELL PAD
WELL NO. 204
ARSENAL RESOURCES



12 Vanhorn Drive | P.O. Box 150 | Glenville, WV 26351 | 304.462.5634
1412 Kanawha Boulevard, East | Charleston, WV 25301 | 304.346.3952
254 East Beckley Bypass | Beckley, WV 25801 | 304.255.5296
slewv.com

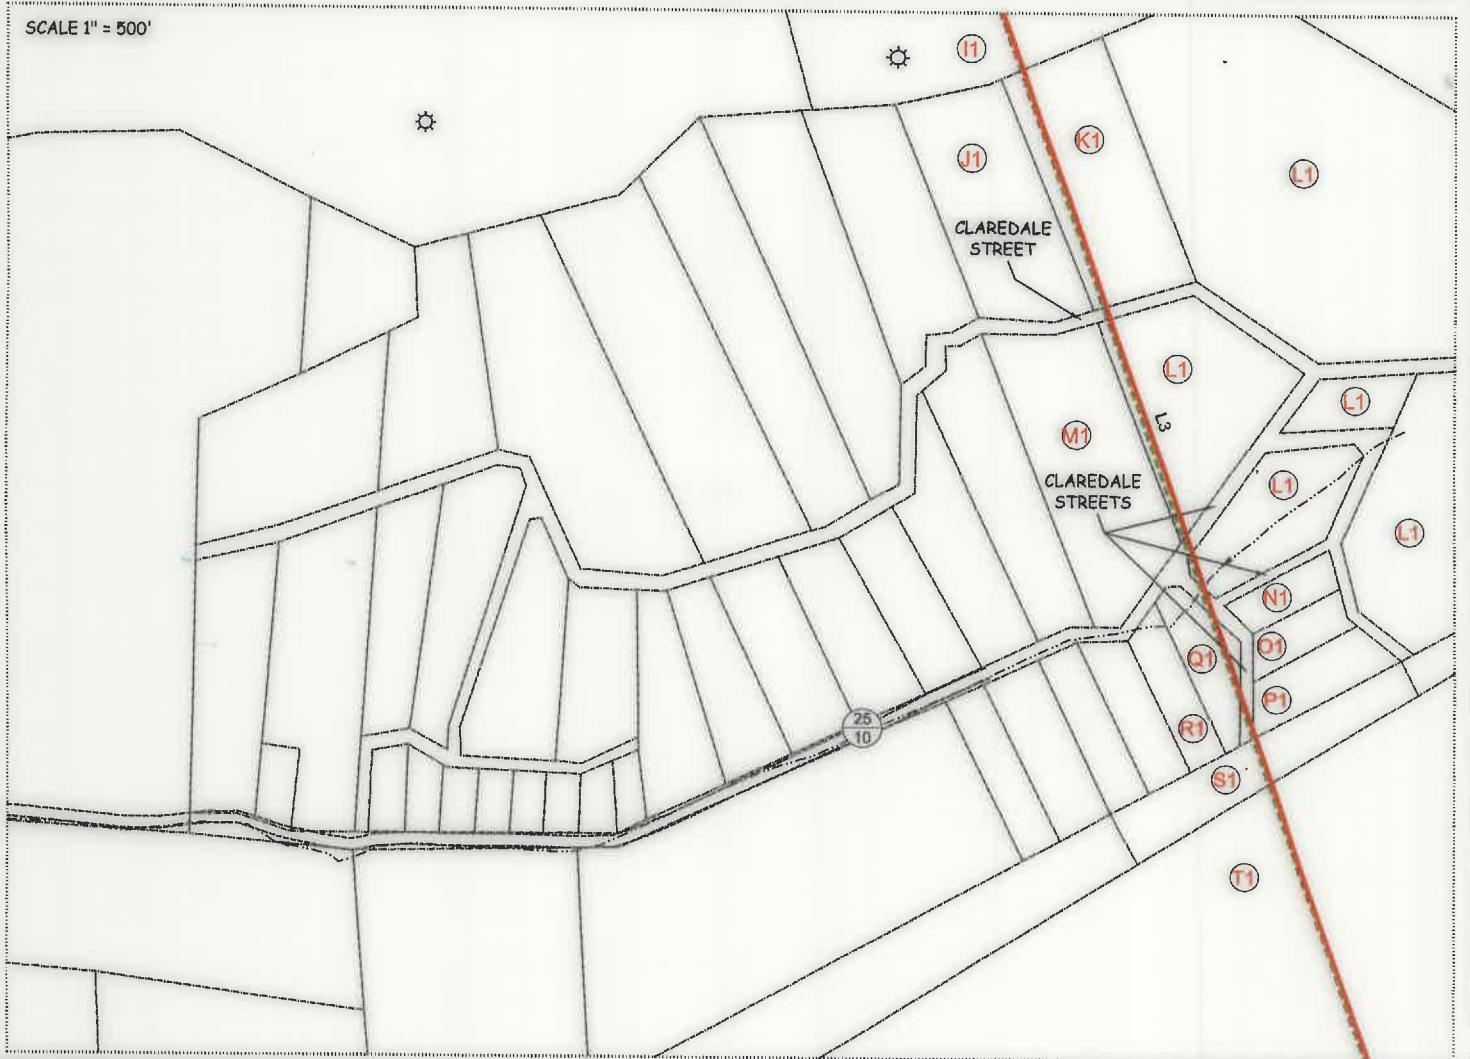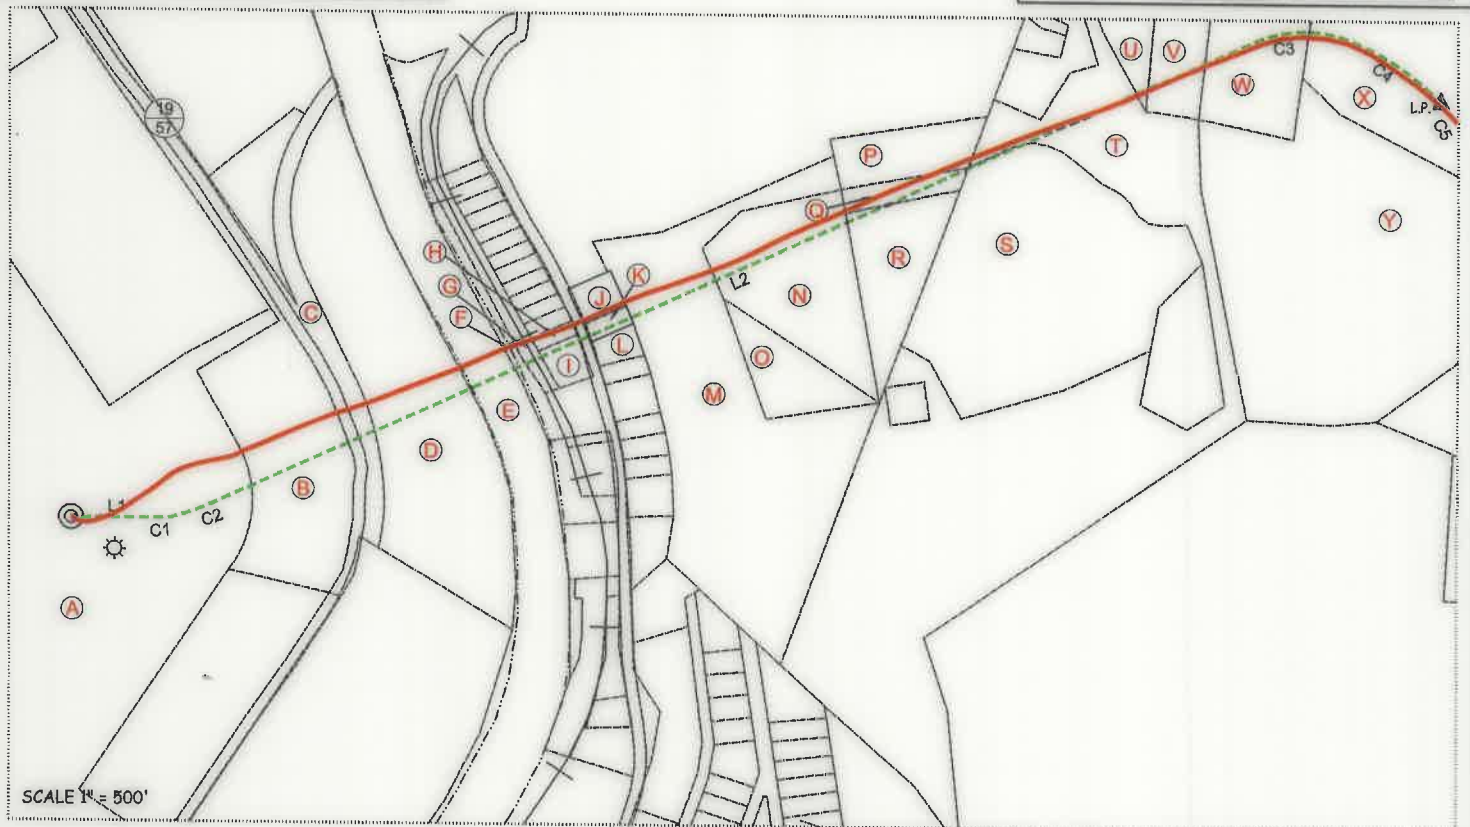


FILE NO. 9423P204AD.dwg

DATE SEPTEMBER 11, 2024

REVISED JUNE 1, 2025

OPERATORS WELL NO. 204

API WELL NO. 47 — 033 — 06040
STATE COUNTY PERMIT

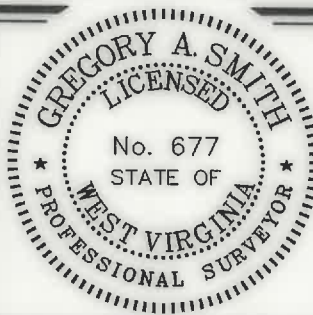

STATE OF WEST VIRGINIA
DIVISION OF ENVIRONMENTAL PROTECTION
OFFICE OF OIL AND GAS



P.S. 677

Gregory A. Smith

WELL OPERATOR ARSENAL RESOURCES
ADDRESS 6031 WALLACE RD. EXT. SUITE 200
WEXFORD, PA 15090

DESIGNATED AGENT ERIC MORRIS
ADDRESS 633 WEST MAIN STREET
BRIDGEPORT, WV 26330

COUNTY NAME

PERMIT

LGD WELL PAD
WELL NO. 204
ARSENAL RESOURCES



FROM THE GROUND UP

12 Vanhorn Drive | P.O. Box 150 | Glenville, WV 26351 | 304.462.5634
1412 Kanawha Boulevard, East | Charleston, WV 25301 | 304.346.3952
254 East Beckley Bypass | Beckley, WV 25801 | 304.255.5296
slswv.com

TAG	PARCEL	SURFACE OWNER/ROAD/RIVER	ACREAGE
A	1-326-37	LAURA GOFF DAVIS	161.22
B	1-326-37.3	SHAFFER ENTERPRISES INC	3.82
ROAD	N/A	COUNTY ROUTE 19/57-ARMORY ROAD	N/A
C	1-326-85	GENERAL CORPORATION	1.45
D	1-326-38	GENERAL CORPORATION	8.21
E	N/A	WEST FORK RIVER	N/A
F	1-115-14	MINNIE REED WHALEY	LOT 1
G	1-326-102	W.V. STATE RAIL AUTHORITY	108.47
H	1-115-24	PAMELA J HARRIS	LOT 13
I	1-115-26	RICHARD A & EDITH M BENNETT	LOTS 14,15,16
ROAD	N/A	COUNTY ROUTE 25-WESTON FAIRMONT TURNPIKE	N/A
J	1-115-21	MICHAEL W & PAMELA J HARRIS	LOT 100 X 120
K	1-115-23	MICHAEL W & PAMELA J HARRIS	LOT 50 X 120
L	1-115-27	ALLEN W & ELIZABETH COMPTON	0.35
M	1-326-84.2	CHARLES & DEBRA MCCLUNG	9.3
N	1-326-43.3	MICHAEL J & MARTA L HODGE	3.07
O	1-326-43.4	MICHAEL J & MARTA L HODGE	1.1
P	1-326-43.6	LISA D & JASON B MENENDEZ	1.11
Q	1-326-43.5	LISA D MENENDEZ ET AL	0.43
R	1-326-43.2	LISA D MENENDEZ ET AL	1.69
S	1-326-44.5	AMY MACCOLEMAN	7.88
T	1-326-44	WVTD LLC	11.58
U	1-326-44.4	GENA HILL DAVIS	1.25
V	1-326-44.3	FERRELL FAMILY PARTNERSHIP	1.33
W	1-327-6.1	MARK A & ANN D WANSTREET	1.66
X (ROAD)	N/A	W.V. ROUTE 98	N/A
Y	1-327-6	MARK A & ANN D WANSTREET	12.29
ROAD	N/A	COUNTY ROUTE 25/12- EAGLE WAY	N/A
Z	1-327-7	ERNST P HALL JR	8.56
A1	1-327-15	JOYCE PROPERTIES INC	26.29
B1	1-327-14	JOYCE PROPERTIES INC	2.385
C1	3-326-26	HARRISON COUNTY BOARD OF EDUCATION	185.84
D1	1-347-5	MICHAEL E & MELISSA L WHITE	94.4
E1	1-347-6	MICHAEL E & MELISSA L WHITE	29.8
F1	1-347-7	MICHAEL E & MELISSA L WHITE	10
G1	1-347-8	ROGER & BETTY PHILLIPS	93.96
H1	1-347-33	KURT G SKASIK & MARK ADAM SKASIK	93.35
I1	12-347-32	WV DNR	245.15
J1	12-347-48	MICHAEL W & MARY M BALL	LOT 42
K1	12-347-49	MICHAEL W & MARY M BALL	LOT 41
ROAD	N/A	STREETS IN CLAREDALE SUBDIVISION	N/A
L1	12-347-50	MICHAEL W & MARY M BALL	39.88
M1	12-347-87	MICHAEL W & MARY M BALL	5
N1	12-367-18	MICHAEL W & MARY M BALL	LOT 24
O1	12-367-19	MICHAEL W & MARY M BALL	LOT 23
P1	12-367-20	MICHAEL W & MARY M BALL	LOT 22
ROAD	N/A	COUNTY ROUTE 25/10-MT CLARE & NORWOOD RD.	N/A
Q1	12-367-17	MICHAEL W & MARY M BALL	LOT 21
R1	12-367-16	MICHAEL W & MARY M BALL	LOT 20
S1	12-367-15	MICHAEL W & MARY M BALL	2.36
T1	1-367-37	WV DNR	160
U1	12-367-36.1	PERRY H ALLEN ETAL	79
V1	12-367-43	KENNETH W MONEYPENNY	51.415
W1	12-367-55.1	MARK S & MARCIE G BRAGG	56.81

FILE NO. 9423P204AD.dwg

DATE SEPTEMBER 11, 2024

REVISED JUNE 1, 2025

OPERATORS WELL NO. 204

API WELL NO. 47 — 033 — 06040

STATE COUNTY PERMIT



STATE OF WEST VIRGINIA
DIVISION OF ENVIRONMENTAL PROTECTION
OFFICE OF OIL AND GAS

09/19/2025

P.S. 677 Gregory A. Smith

WELL OPERATOR ARSENAL RESOURCES

DESIGNATED AGENT ERIC MORRIS

ADDRESS 6031 WALLACE RD. EXT. SUITE 200

ADDRESS 633 WEST MAIN STREET

WEXFORD, PA 15090

BRIDGEPORT, WV 26330

COUNTY NAME

PERMIT