

47-033-06042

Well Plugging Map

Legend

Well

Pits

Pad


Access Road

Public Roads


RECEIVED
Office of Oil and Gas
AUG 20

AUG 20 2025

WV Department of
Environmental Protection

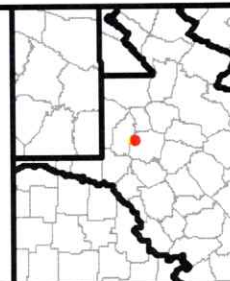


1" = 200'

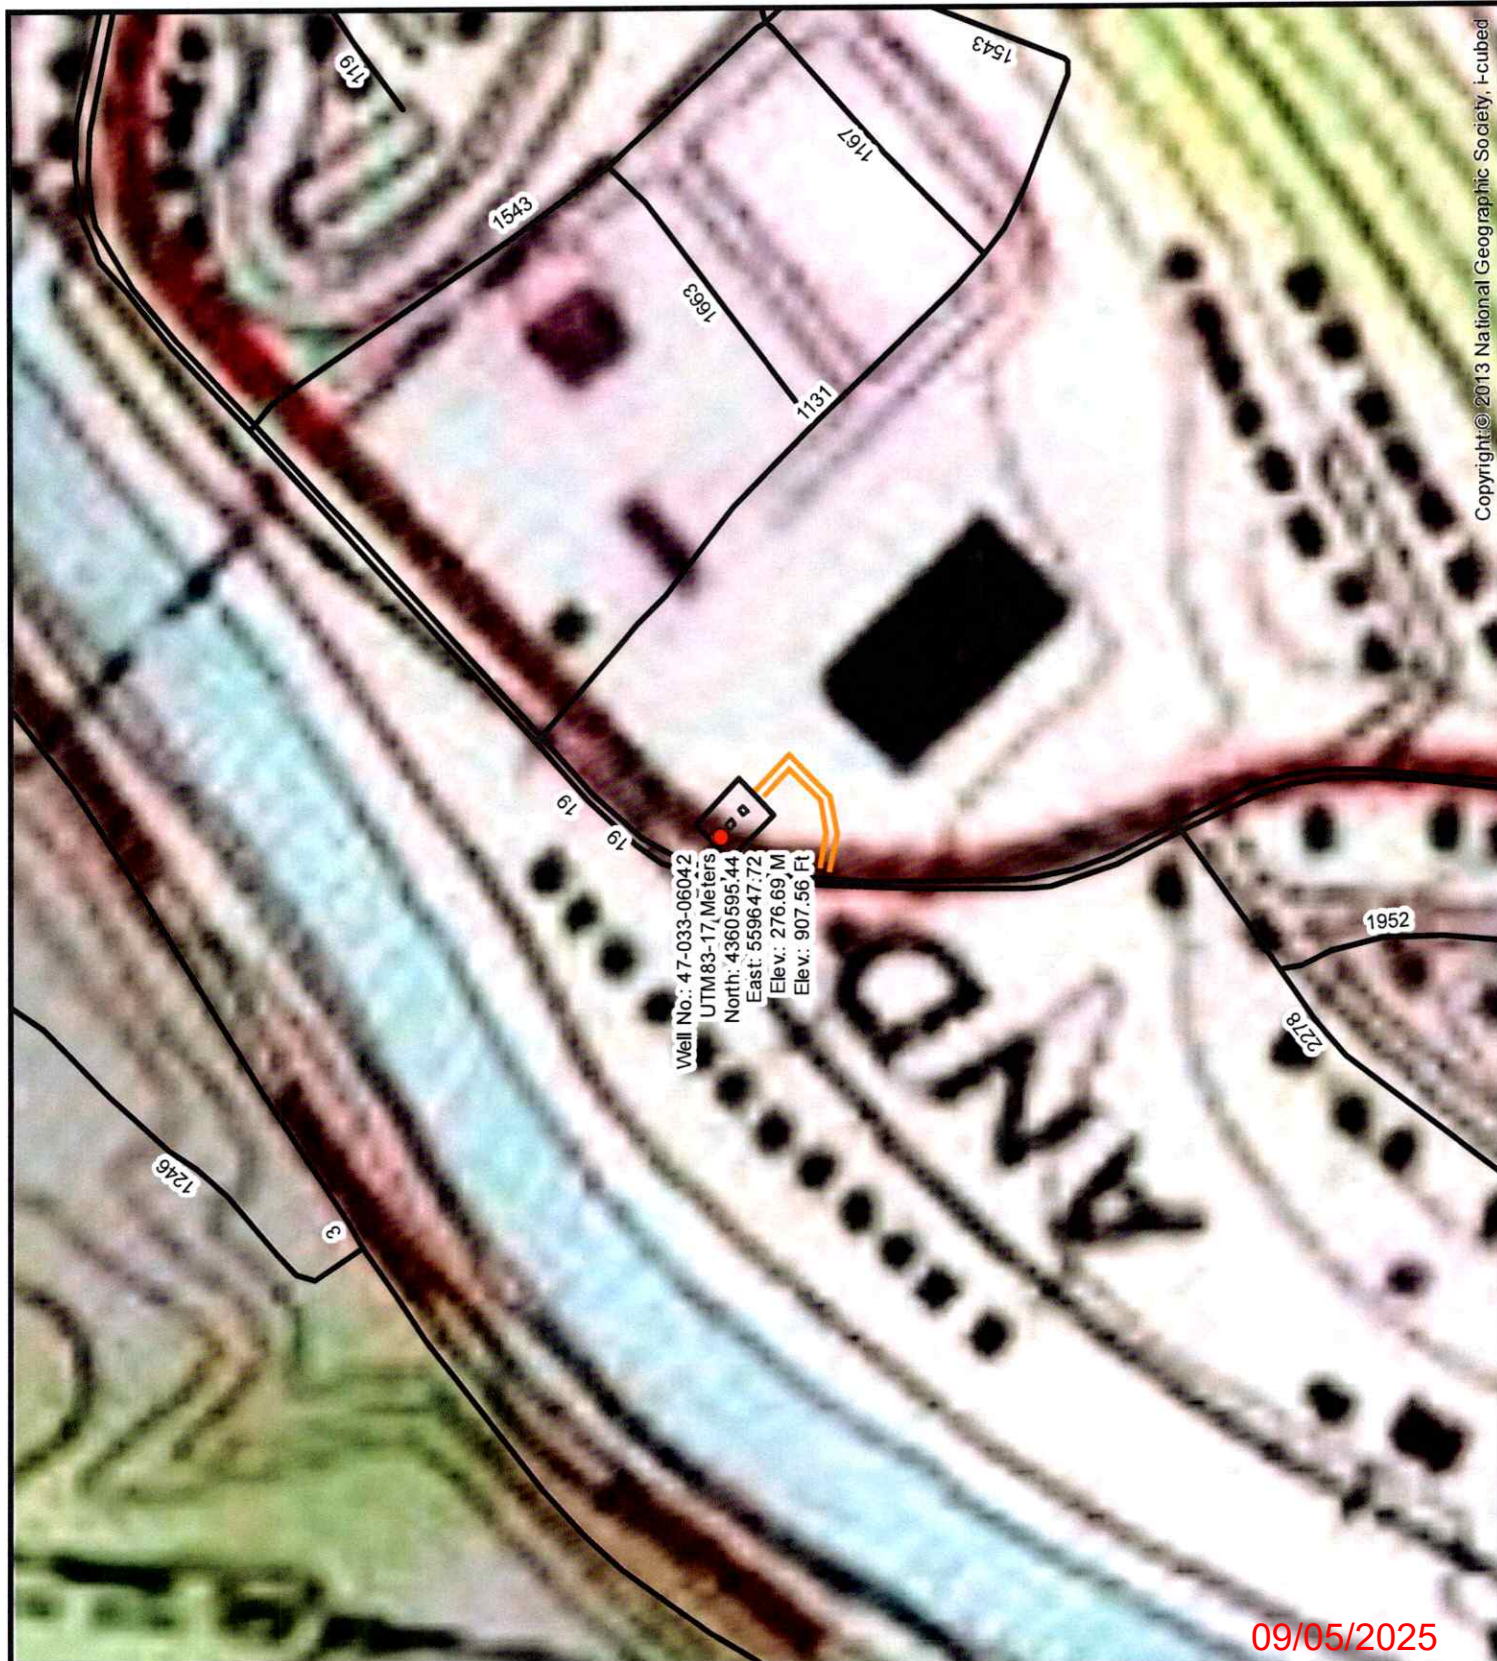A horizontal graphic scale bar with a black and white alternating pattern. It is marked with '0', '100', and '200' at regular intervals. The unit 'Ft' is written at the right end.

Copyright © 2013 National Geographic Society, i-cubed


09/05/2025

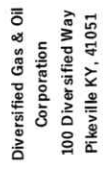

Well Plugging Map

Well

Well

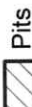

Pad



Accepted

— Pub

WV Department of
Environmental Protection

RECEIVED
Office of Oil and Gas
AUG 22

AUG 20 2025



1" = 50'



0 25 50 Ft



Source: Esri, Maxar, Earthstar Geographics, and the GIS User Community

09/05/2025



3574 Teays Valley Road
Hurricane, WV 25526
Ph: 304.933.3119
www.cecinc.com


SURFACE HOLE 4433'

Top Hole Latitude: 39°25'00"

GRID NORTH
UTM, NAD83 DATUM, ZONE 17, US FT

Top Hole Longitude: 80°17'30"

SURFACE HOLE 8688'

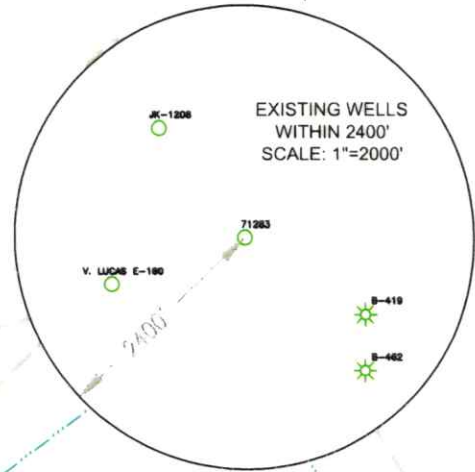

FRALL DEVELOPERS, INC
TAX MAP 1003 PARCEL 1.1
0.20 ACRES±

FRALL DEVELOPERS
TAX MAP 1003 PARCEL 2.3
0.28 ACRES±

WAGRADOL WV 2 LLC
TAX MAP 1003 PARCEL 2
1.31 ACRES±

SUNSHINE VALLEY
MOBILE COURT INC
TAX MAP 1003
PARCEL 5
3.88 ACRES±

UNITED CENTRAL
INDUSTRIAL SUPPLY
COMPANY LLC
TAX MAP 1002 PARCEL 1
6.50 ACRES±

MICHAEL & LAURIE RICHARDS
TAX MAP 1002 PARCEL 2.2
0.83 ACRES±

MICHAEL & LAURIE RICHARDS
TAX MAP 1002 PARCEL 2.5
0.42 ACRES±

TEDA J FAMILY LIMITED
PARTNERSHIP
TAX MAP 1002 PARCEL 1.1
0.32 ACRES±

TEDA J FAMILY LIMITED
PARTNERSHIP
TAX MAP 1002 PARCEL 5
7.52 ACRES±

JMC RENTALS LLC
TAX MAP 1002 PARCEL 7
1.44 ACRES±
VINCENT BROTHERS RENTALS LLC
TAX MAP 1002 PARCEL 7.1
0.70 ACRES±
RONALD L & LINDA L VINCENT
TAX MAP 1002 PARCEL 8
0.28 ACRES±

JOHN J & MICHELLE D CASALINOVA
TAX MAP 1002 PARCEL 10
0.18 ACRES±

EXISTING WELL LOCATION (SHL):

GEOGRAPHIC (NAD83):
LATITUDE: 39.392782°
LONGITUDE: -80.307330°
UTM (NAD83, ZONE 17, FEET):
NORTHING: 14,306,383.015
EASTING: 1,836,107.729
UTM (NAD83, ZONE 17, METERS):
NORTHING: 4,360,594.264
EASTING: 559,646.755

SCALE IN FEET



I, THE UNDERSIGNED, HEREBY CERTIFY THAT THIS PLAT IS
CORRECT TO THE BEST OF MY KNOWLEDGE AND BELIEF AND SHOWS
ALL THE INFORMATION REQUIRED BY LAW AND REGULATIONS ISSUED
AND PRESCRIBED BY THE DEPARTMENT OF ENVIRONMENTAL PROTECTION.

P.S. 2396

Zachary R. Huff



WELL RESTRICTIONS

1. NO OCCUPIED DWELLINGS > WITHIN 200 FEET OF CENTER OF PAD.
2. NO AGRICULTURE BUILDINGS > 2500 SQ FT. WITHIN 625 FEET OF CENTER OF PAD.
3. NO WATER WELLS OR DEVELOPED SPRINGS ARE WITHIN CENTER OF 200 FEET OF PAD.

NOTES ON SURVEY

1. SURFACE AND ROYALTY OWNER INFORMATION AND THEIR BOUNDARIES SHOWN HEREON WERE PLOTTED FROM DEEDS AND/OR TAX PARCEL MAPS PROVIDED BY CLIENT AND/OR FIELD LOCATIONS.
2. THIS PLAT DOES NOT REPRESENT A BOUNDARY SURVEY OF THE PARCELS SHOWN HEREON.
3. ALL INSETS ARE GRID NORTH UNLESS OTHERWISE DEPICTED.

COMPANY:

**NEXT
LVL
ENERGY**



(+) DENOTES LOCATION OF WELL ON
UNITED STATES TOPOGRAPHIC MAPS

WVDEP
OFFICE OF OIL & GAS
601 57TH STREET
CHARLESTON, WV 25034

MINIMUM DEGREE
OF ACCURACY: 1/200

PROVEN SOURCE SURVEY GRADE GPS
OF ELEVATION: (NAVD 88, US FT)

OPERATOR'S WELL #: 71246

API WELL #: 47 033 06042
STATE COUNTY PERMIT

WELL TYPE: OIL ☐ WASTE DISPOSAL ☐ PRODUCTION ☐ DEEP ☐ GAS ☒ LIQUID INJECTION ☐ STORAGE ☐ SHALLOW ☒
WATERSHED: WEST FORK RIVER ELEVATION: 911.11
DISTRICT: CLAY-SHINNSTON CORP COUNTY: HARRISON QUADRANGLE: SHINNSTON
SURFACE OWNER: UNITED CENTRAL INDUSTRIAL SUPPLY COMPANY LLC ACREAGE: 6.50±
OIL & GAS ROYALTY OWNER: N/A ACREAGE: N/A
DRILL ☐ DRILL DEEPER ☐ REDRILL ☐ FRACTURE OR STIMULATE ☐ PLUG OFF OLD FORMATION ☐ PERFORATE NEW FORMATION ☐
CONVERT ☐ PLUG & ABANDON ☒ CLEAN OUT & REPLUG ☐ OTHER CHANGE ☐ (SPECIFY) 09/05/2025
TARGET FORMATION: N/A ESTIMATED DEPTH: TVD TMD

WELL OPERATOR: UNKNOWN WVDEP PAID PLUGGING CONTRACT	DESIGNATED AGENT: JASON HARMON
ADDRESS: 601 57TH STREET	ADDRESS: 601 57TH STREET
CITY: CHARLESTON STATE: WV ZIP CODE: 25304 (WVDEP)	CITY: CHARLESTON STATE: WV ZIP CODE: 25304

LEGEND:	REVISIONS:	DATE: 05-29-2025
ACTIVE PRODUCING WELLHEAD		352-115
ABANDONED WELLHEAD		DRAWN BY: S.C.S.
LEASE BOUNDARY		SCALE: 1" = 400'
ADJOINER LINE		DRAWING NO: 352-115
EXISTING ROAD		WELL LOCATION PLAT
EXISTING STREAM		