



Diversified Gas & Oil
Corporation
100 Diversified Way
Pikeville KY, 41051

47-033-06068

Well Plugging Map

Legend


Well



Pad






Access Road

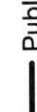

Public Roads



RECEIVED
Office of Oil and Gas
AUG 20 2025
WV Department of
Environmental Protection

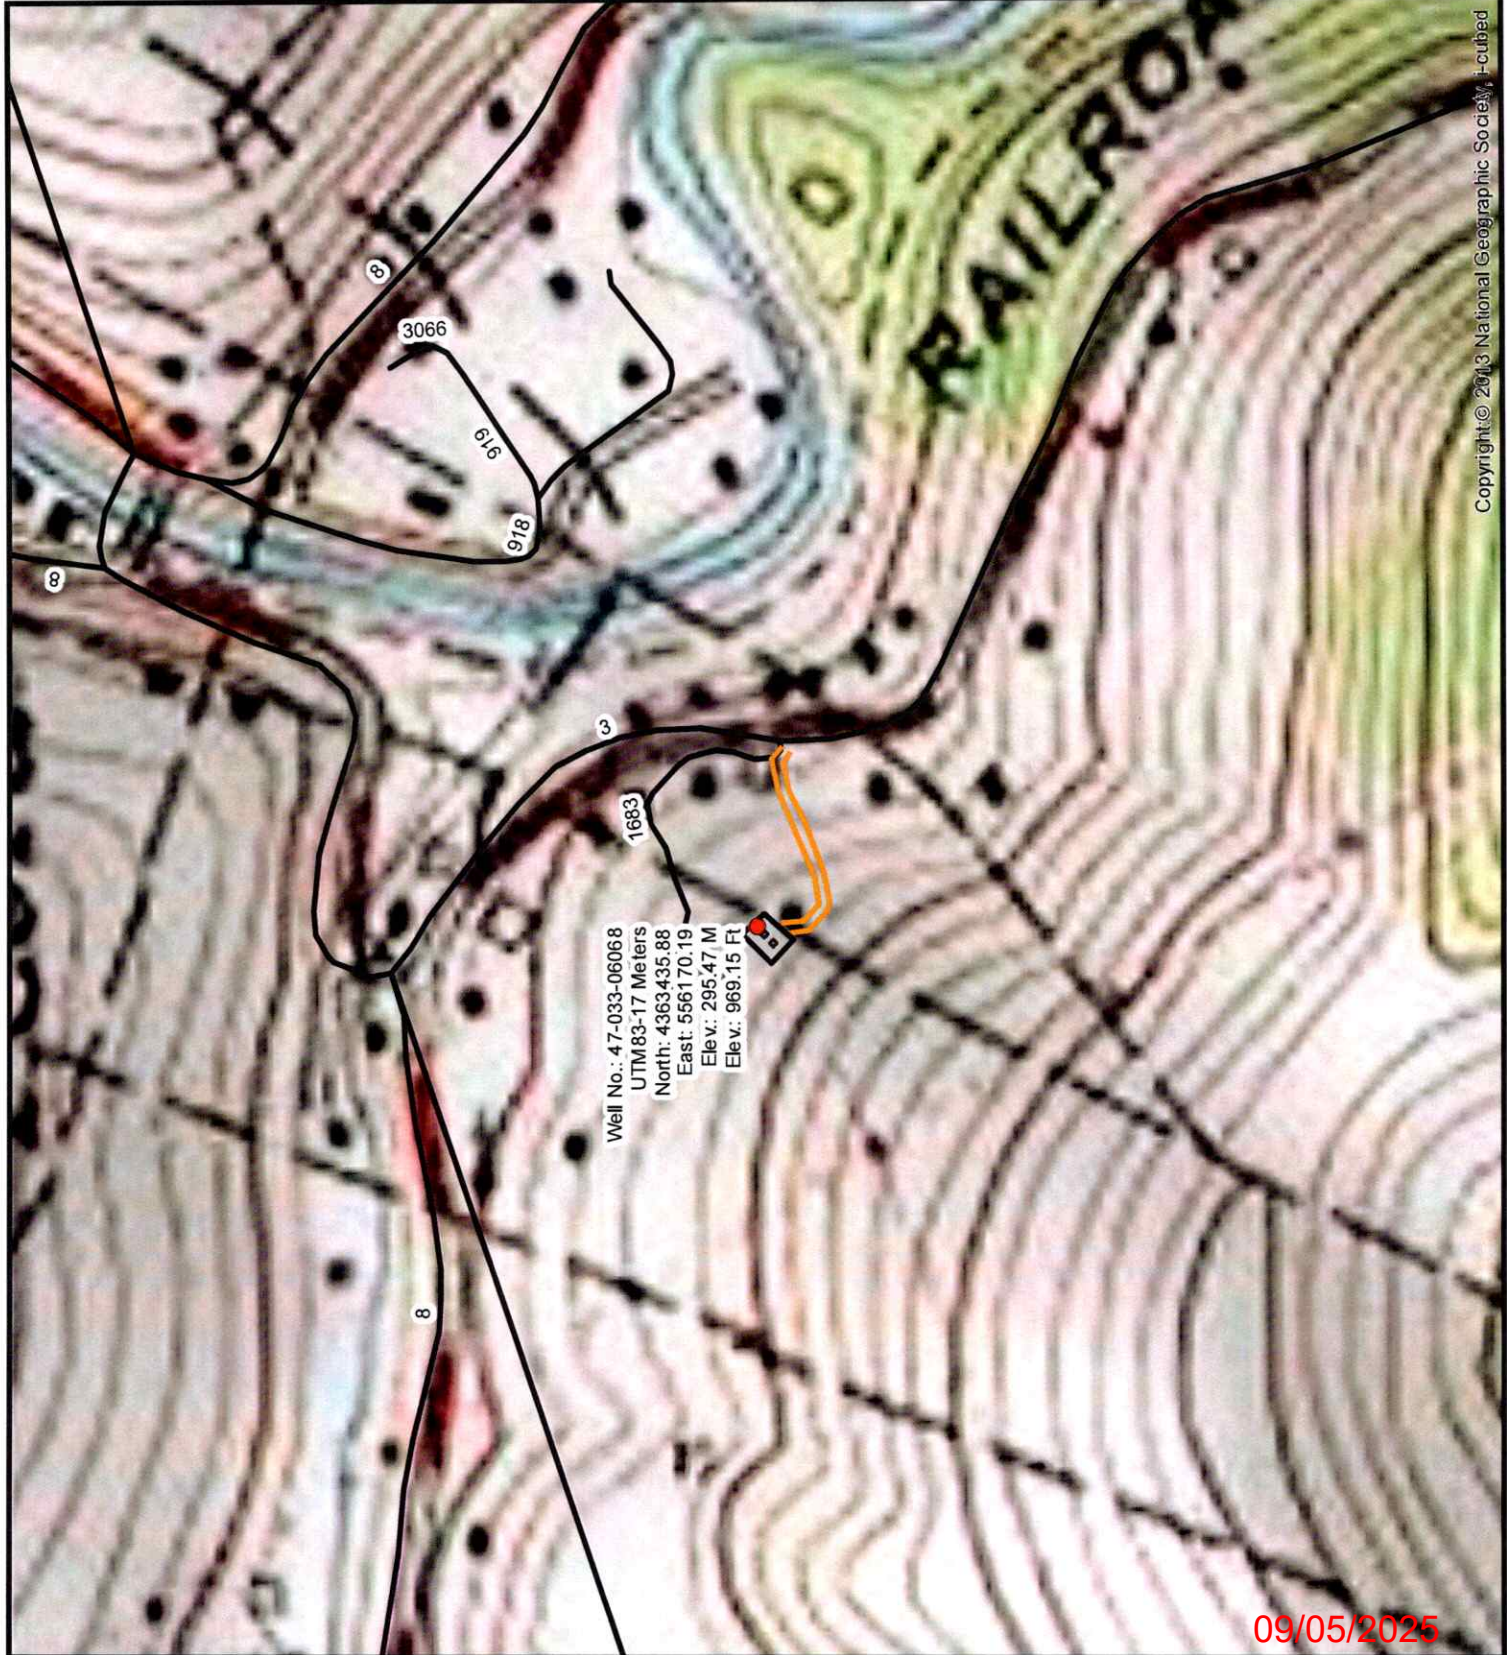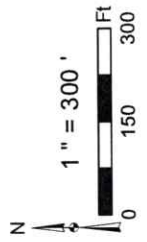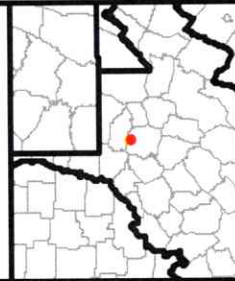

Well No.: 47-033-06068
UTM83-17 Meters
North: 4363435.88
East: 566170.19
Elev.: 295.47 M
Elev.: 969.15 Ft

Copyright © 2013 National Geographic Society, Inc.

09/05/2025



Diversified Gas & Oil
Corporation
100 Diversified Way
Pikeville KY, 41051

47-033-06068

Well Plugging Map

Legend



Well



Pad






Access Road



Public Roads

RECEIVED
Office of Oil and Gas
AUG 20 2025
WV Department of
Environmental Protection

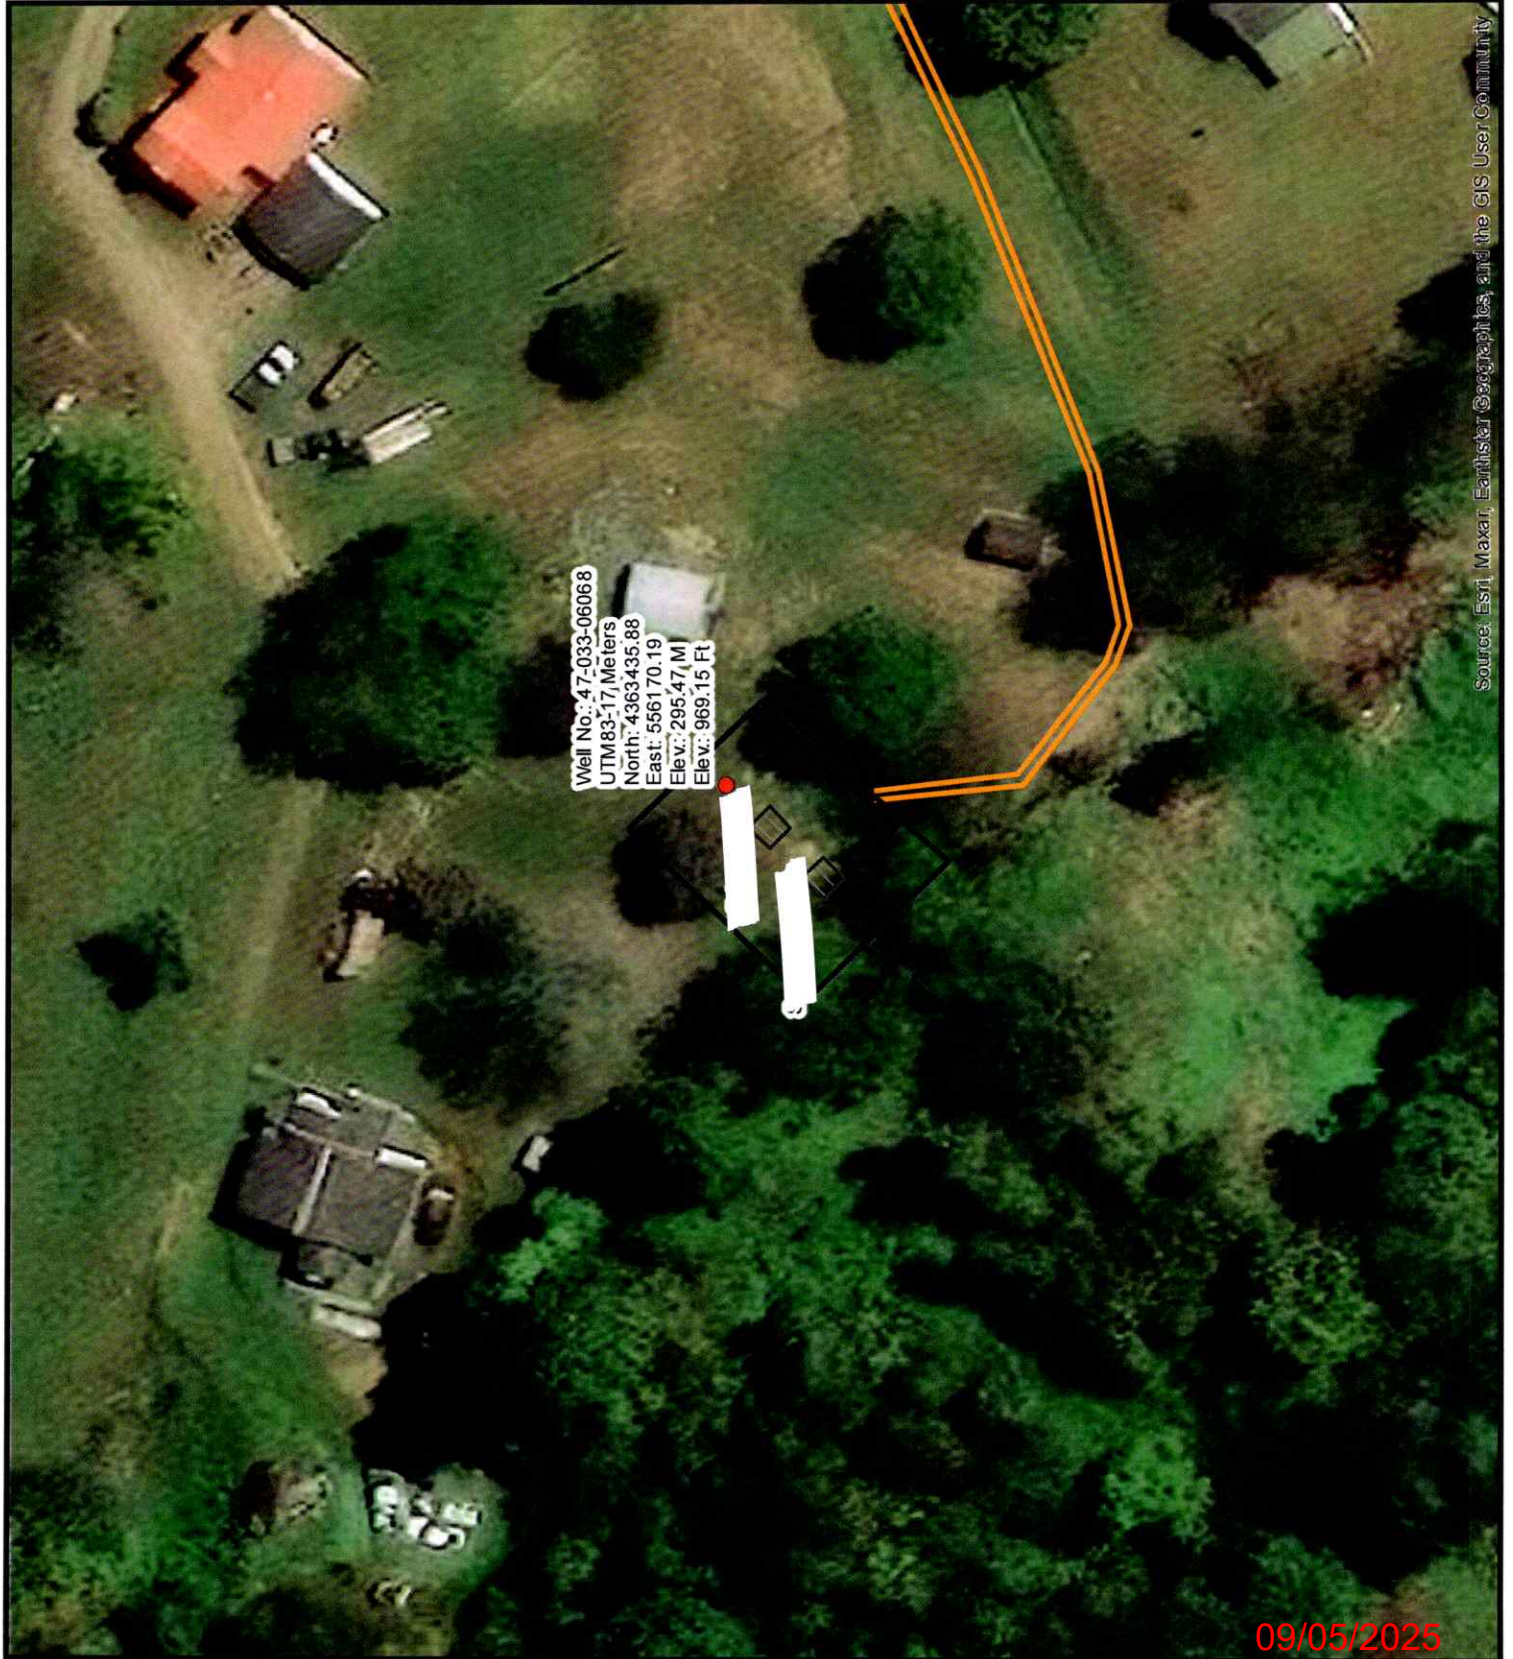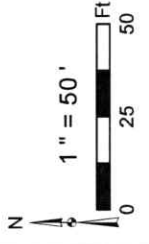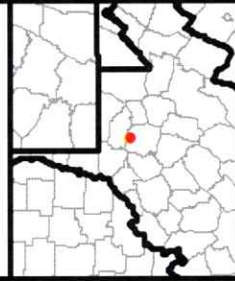

Source: Esri, Maxar, Earthstar Geographics, and the GIS User Community

09/05/2025



Civil & Environmental
Consultants, Inc.

3574 Teays Valley Road
Hurricane, WV 25526

Ph: 304.933.3119

www.cecinc.com

WELL RESTRICTIONS

1. ONE (1) OCCUPIED DWELLING > WITHIN 200 FEET OF CENTER OF PAD.
2. NO AGRICULTURE BUILDINGS > 2500 SQ. FT. WITHIN 625 FEET OF CENTER OF PAD.
3. NO WATER WELLS OR DEVELOPED SPRINGS ARE WITHIN CENTER OF 200 FEET OF PAD.


SURFACE HOLE 3976'

Top Hole Latitude: 39°27'30"



Top Hole Longitude: 80°20'00"

SURFACE HOLE 14430'

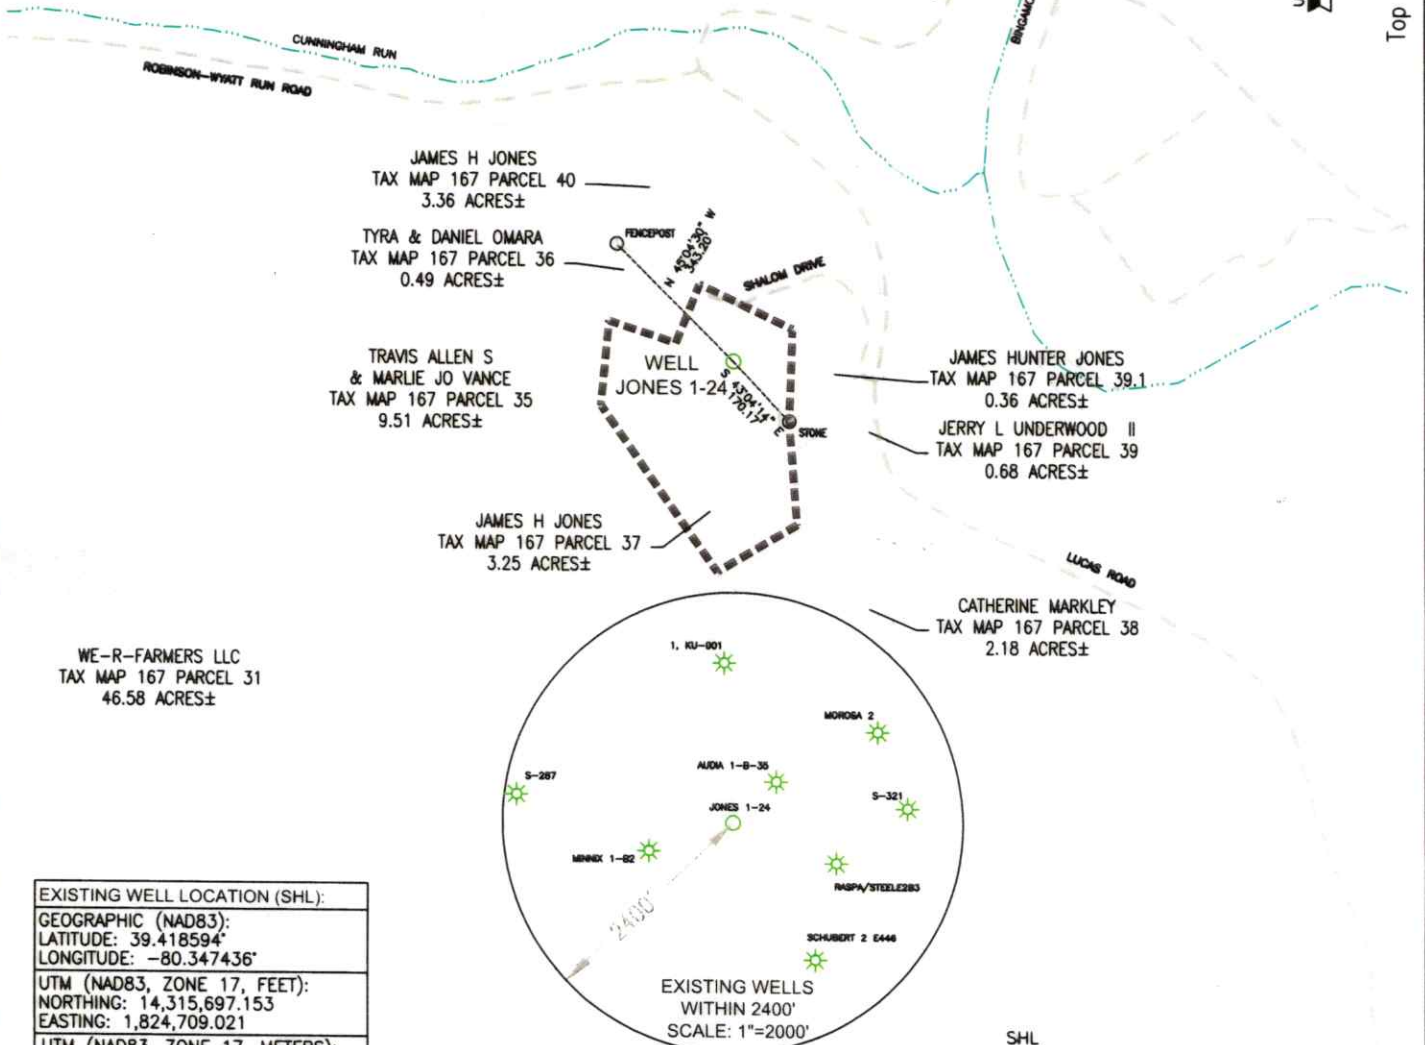

EXISTING WELL LOCATION (SHL):

GEOGRAPHIC (NAD83):
LATITUDE: 39.418594°
LONGITUDE: -80.347436°

UTM (NAD83, ZONE 17, FEET):
NORTHING: 14,315,697.153
EASTING: 1,824,709.021

UTM (NAD83, ZONE 17, METERS):
NORTHING: 4,363,433.219
EASTING: 556,172.422

SCALE IN FEET

0 400' 800'

I, THE UNDERSIGNED, HEREBY CERTIFY THAT THIS PLAT IS CORRECT TO THE BEST OF MY KNOWLEDGE AND BELIEF AND SHOWS ALL THE INFORMATION REQUIRED BY LAW AND REGULATIONS ISSUED AND PRESCRIBED BY THE DEPARTMENT OF ENVIRONMENTAL PROTECTION.

P.S. 2396

Zachary R. Hupp



NOTES ON SURVEY

1. SURFACE AND ROYALTY OWNER INFORMATION AND THEIR BOUNDARIES SHOWN HEREON WERE PLOTTED FROM DEEDS AND/OR TAX PARCEL MAPS PROVIDED BY CLIENT AND/OR FIELD LOCATIONS.
2. THIS PLAT DOES NOT REPRESENT A BOUNDARY SURVEY OF THE PARCELS SHOWN HEREON.
3. ALL INSETS ARE GRID NORTH UNLESS OTHERWISE DEPICTED.

COMPANY:



(+) DENOTES LOCATION OF WELL ON UNITED STATES TOPOGRAPHIC MAPS

WVDEP
OFFICE OF OIL & GAS
601 57TH STREET
CHARLESTON, WV 25034

MINIMUM DEGREE
OF ACCURACY: 1/200

PROVEN SOURCE OF ELEVATION: SURVEY GRADE GPS (NAVD 88, US FT)

OPERATOR'S WELL #: JONES 1-24

API WELL #: 47 033 06068
STATE COUNTY PERMIT

WELL TYPE: OIL ☐ WASTE DISPOSAL ☐ PRODUCTION ☐ DEEP ☐ GAS ☒ LIQUID INJECTION ☐ STORAGE ☐ SHALLOW ☒
WATERSHED: CUNNINGHAM RUN ELEVATION: 1068.55
DISTRICT: EAGLE-OUTSIDE COUNTY: HARRISON QUADRANGLE: SHINNSTON
SURFACE OWNER: JAMES H JONES ACREAGE: 3.25±
OIL & GAS ROYALTY OWNER: N/A ACREAGE: N/A
DRILL ☐ DRILL DEEPER ☐ REDRILL ☐ FRACTURE OR STIMULATE ☐ PLUG OFF OLD FORMATION ☐ PERFORATE NEW FORMATION ☐
CONVERT ☐ PLUG & ABANDON ☒ CLEAN OUT & REPLUG ☐ OTHER CHANGE ☐ (SPECIFY) 09/05/2025
TARGET FORMATION: N/A ESTIMATED DEPTH: TVD TMD

WELL OPERATOR: UNKNOWN WVDEP PAID PLUGGING CONTRACT

DESIGNATED AGENT: JASON HARMON

ADDRESS: 601 57TH STREET

ADDRESS: 601 57TH STREET

CITY: CHARLESTON STATE: WV ZIP CODE: 25304 (WVDEP)

CITY: CHARLESTON STATE: WV ZIP CODE: 25304

LEGEND:

- ☀ ACTIVE PRODUCING WELLHEAD
- ABANDONED WELLHEAD

- ===== LEASE BOUNDARY
- ADJOINER LINE
- EXISTING ROAD
- EXISTING STREAM

REVISIONS:

DATE: 05-29-2025

352-115

DRAWN BY: S.C.S.

SCALE: 1" = 400'

DRAWING NO: 352-115

WELL LOCATION PLAT