






Diversified Gas & Oil  
Corporation  
100 Diversified Way  
Pikeville KY, 41051

47-033-06078

Well Plugging Map

### Legend

- Well
- Access Road
- Pad
- Public Roads

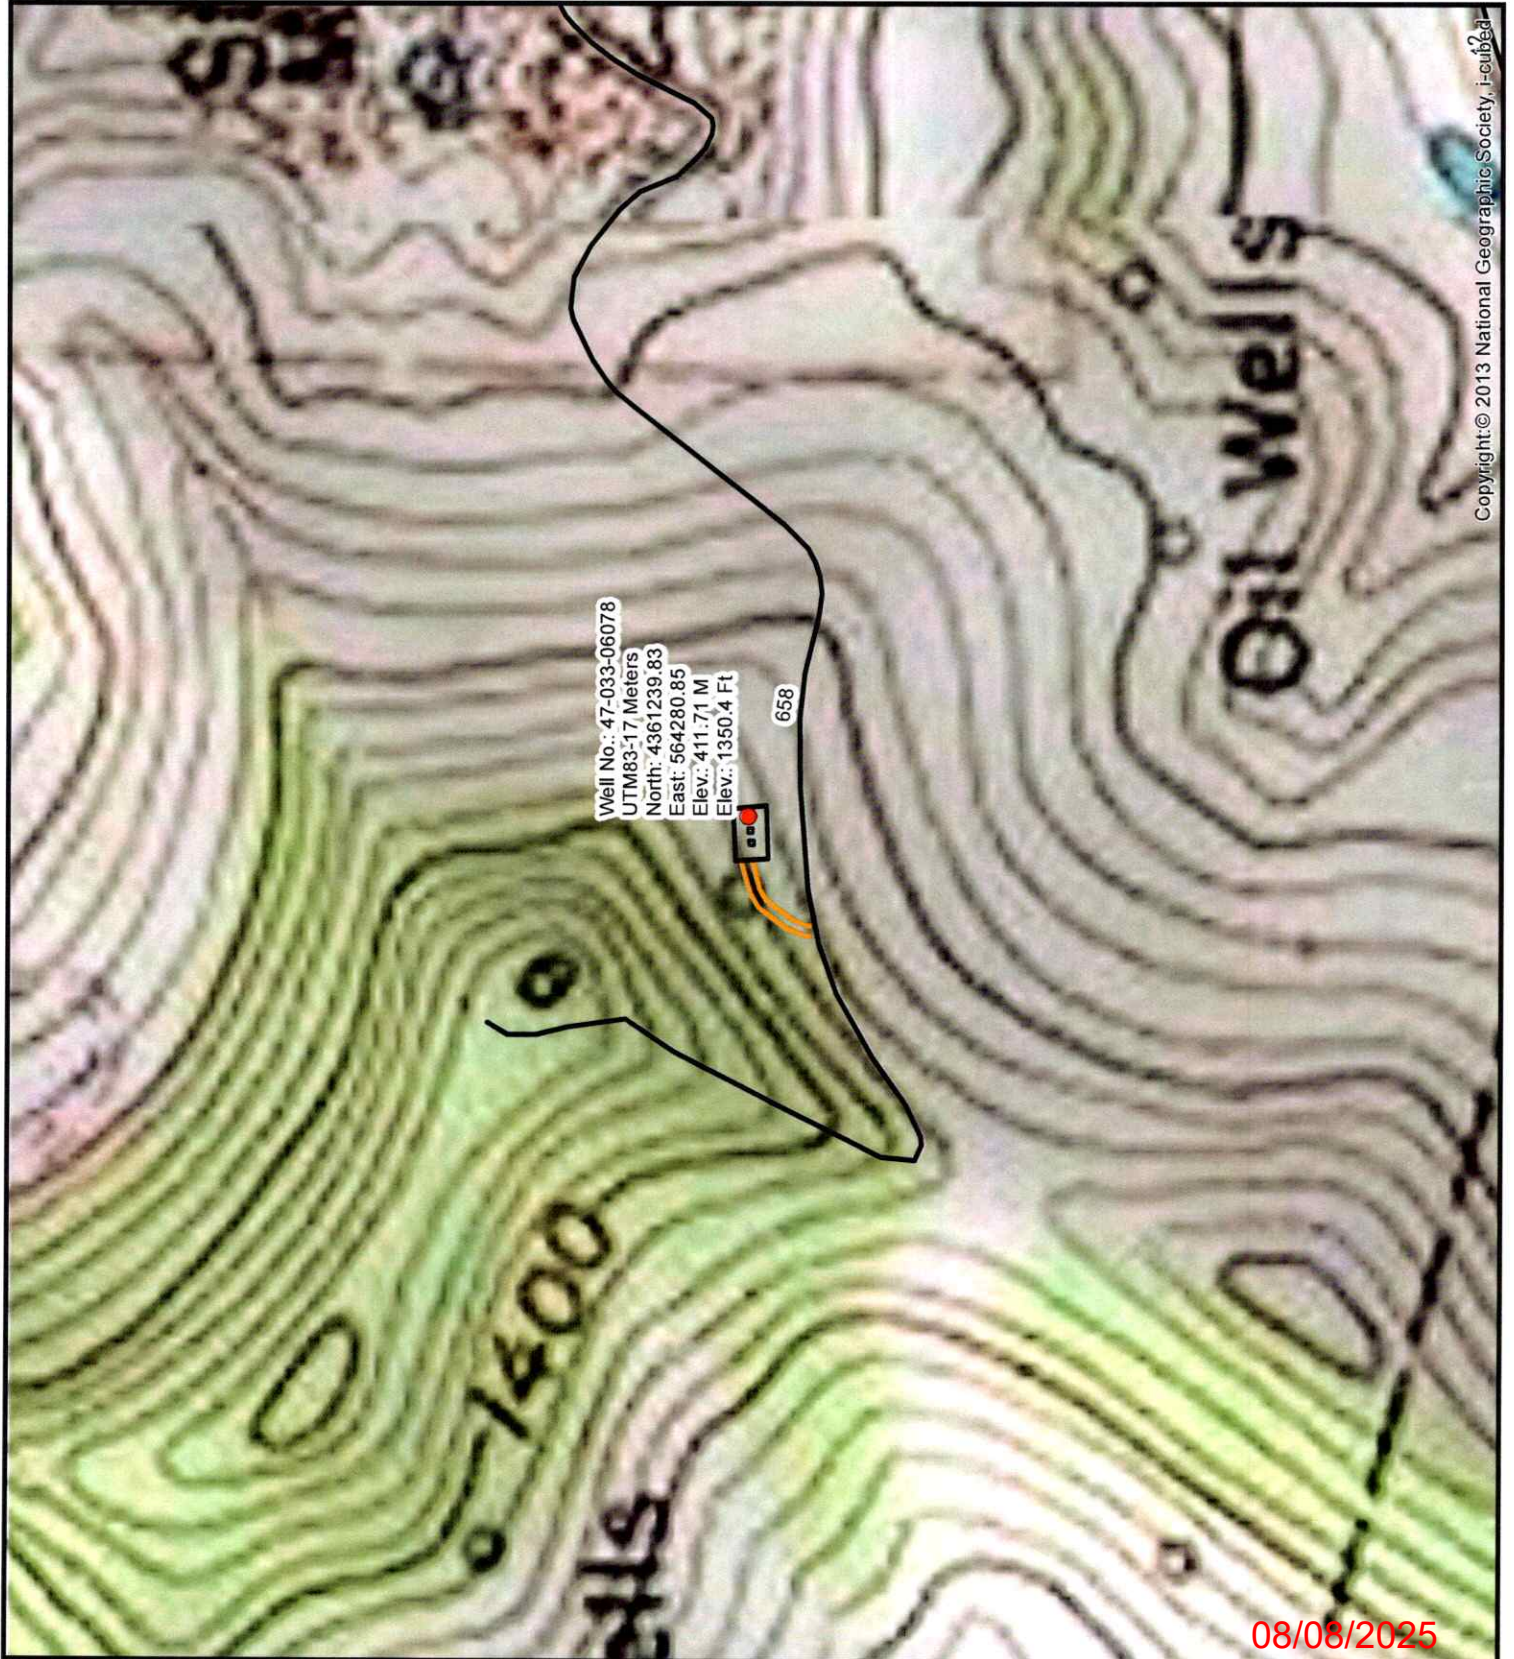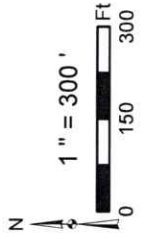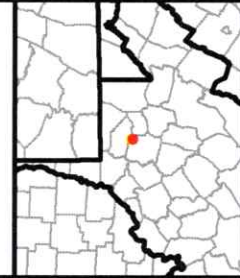

Well No.: 47-033-06078  
UTM83-17 Meters  
North: 4361239.83  
East: 564280.85  
Elev.: 411.71 M  
Elev.: 1350.4 Ft

658

08/08/2025







Diversified Gas & Oil  
Corporation  
100 Diversified Way  
Pikeville KY, 41051

47-033-06078

Well Plugging Map

## Legend

- Well
- Access Road
- Pad
- Public Roads

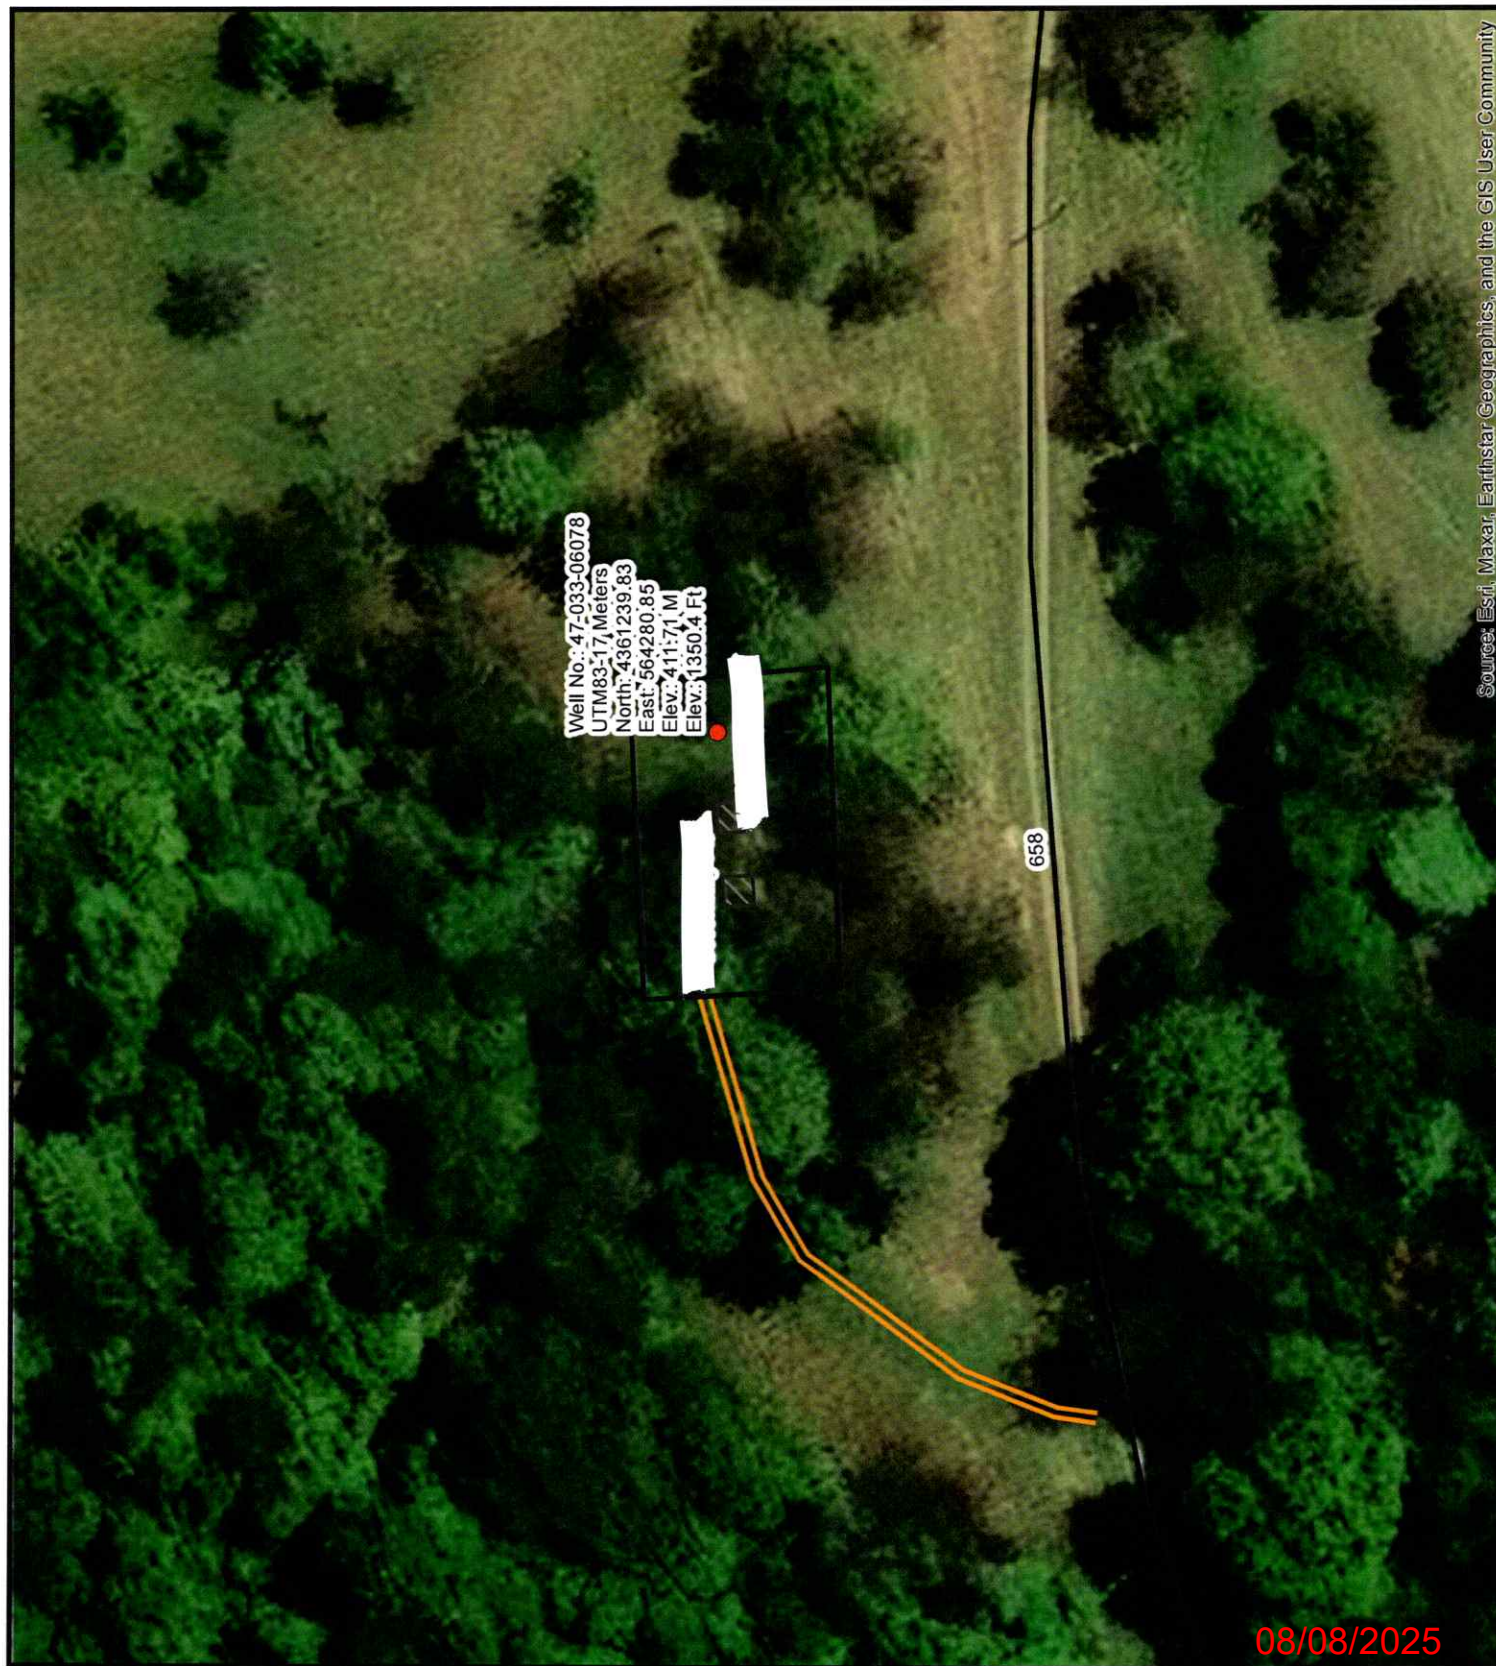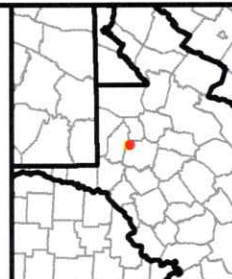


Well No.: 47-033-06078  
UTM83: 17, Meters  
North: 4361239.83  
East: 564280.85  
Elev.: 411.71 M  
Elev.: 1350.4 Ft

Source: Esri, Maxar, Earthstar Geographics, and the GIS User Community

08/08/2025



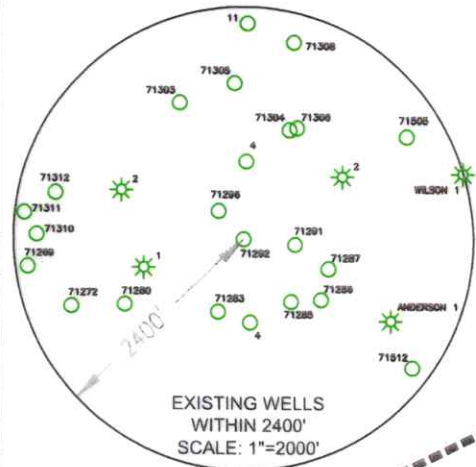

DANAL "PETE" MCMILLION  
TAX MAP 189 PARCEL 11  
15.40 ACRES±

JOHN T. AND MARY L. PAUSHEL  
TAX MAP 189 PARCEL 26  
29.22 ACRES±

MILAN JR & ANITA PATRICK  
TAX MAP 189 PARCEL 24  
21.54 ACRES±

VILERY TALKINGTON  
TAX MAP 189 PARCEL 35  
35.77 ACRES±

WILLIAM ROMEO CALOCCIA  
TAX MAP 189 PARCEL 37.1  
53.32 ACRES±

WELL  
71292  
S 89°46'35" W  
176.04'  
FENCE POST  
S 89°27'19" E  
173.45'  
FENCE POST

BRITNEY J. AMODIO AND  
JEREMY R. ROSS  
TAX MAP 189 PARCEL 62  
37.79 ACRES±

JOSEPH M. NEGAARD  
TAX MAP 189 PARCEL 63  
19.61 ACRES±

BRITNEY J. AMODIO AND  
JEREMY R. ROSS  
TAX MAP 189 PARCEL 62.2  
2.82 ACRES±

JAMES HILL ROAD

**WELL RESTRICTIONS**

1. NO OCCUPIED DWELLINGS > WITHIN 200 FEET OF CENTER OF PAD.
2. NO AGRICULTURE BUILDINGS > 2500 SQ FT. WITHIN 625 FEET OF CENTER OF PAD.
3. NO WATER WELLS OR DEVELOPED SPRINGS ARE WITHIN CENTER OF 200 FEET OF PAD.

**EXISTING WELL LOCATION (SHL):**

GEOGRAPHIC (NAD83):  
LATITUDE: 39.398277°  
LONGITUDE: -80.253455°

UTM (NAD83, ZONE 17, FEET):  
NORTHING: 14,308,505.140  
EASTING: 1,851,312.013

UTM (NAD83, ZONE 17, METERS):  
NORTHING: 4,361,241.089  
EASTING: 564,281.030

**SCALE IN FEET**



I, THE UNDERSIGNED, HEREBY CERTIFY THAT THIS PLAT IS CORRECT TO THE BEST OF MY KNOWLEDGE AND BELIEF AND SHOWS ALL THE INFORMATION REQUIRED BY LAW AND REGULATIONS ISSUED AND PRESCRIBED BY THE DEPARTMENT OF ENVIRONMENTAL PROTECTION.

P.S. 2396

*Zachary R. Hupp*



1. SURFACE AND ROYALTY OWNER INFORMATION AND THEIR BOUNDARIES SHOWN HEREON WERE PLOTTED FROM DEEDS AND/OR TAX PARCEL MAPS PROVIDED BY CLIENT AND/OR FIELD LOCATIONS.
2. THIS PLAT DOES NOT REPRESENT A BOUNDARY SURVEY OF THE PARCELS SHOWN HEREON.
3. ALL INSETS ARE GRID NORTH UNLESS OTHERWISE DEPICTED.

COMPANY:

**NEXT  
LVL  
ENERGY**



(+) DENOTES LOCATION OF WELL ON UNITED STATES TOPOGRAPHIC MAPS

WVDEP  
OFFICE OF OIL & GAS  
601 57TH STREET  
CHARLESTON, WV 25034

MINIMUM DEGREE  
OF ACCURACY: 1/200

PROVEN SOURCE  
OF ELEVATION: SURVEY  
GRADE GPS  
(NAVD 88, US FT)

OPERATOR'S WELL #: 71292

API WELL #: 47 033 06078  
STATE COUNTY PERMIT

WELL TYPE: OIL ☐ WASTE DISPOSAL ☐ PRODUCTION ☐ DEEP ☐ GAS ☒ LIQUID INJECTION ☐ STORAGE ☐ SHALLOW ☒

WATERSHED: COON'S RUN

DISTRICT: CLAY COUNTY: HARRISON

SURFACE OWNER: WILLIAM ROMEO CALOCCIA

OIL & GAS ROYALTY OWNER: N/A

ELEVATION: 1354.97

QUADRANGLE: SHINNSTON

ACREAGE: 53.32±

ACREAGE: N/A

DRILL ☐ DRILL DEEPER ☐ REDRILL ☐ FRACTURE OR STIMULATE ☐ PLUG OFF OLD FORMATION ☐ PERFORATE NEW FORMATION ☐

CONVERT ☐ PLUG & ABANDON ☒ CLEAN OUT & REPLUG ☐ OTHER CHANGE ☐ (SPECIFY)

TARGET FORMATION: N/A

ESTIMATED DEPTH: TVD TMD

WELL OPERATOR: UNKNOWN WVDEP PAID PLUGGING CONTRACT

DESIGNATED AGENT: JASON HARMON

ADDRESS: 601 57TH STREET

ADDRESS: 601 57TH STREET

CITY: CHARLESTON

STATE: WV

ZIP CODE: 25304 (WVDEP)

CITY: CHARLESTON

STATE: WV

ZIP CODE: 25304

**LEGEND:**

- ☀ ACTIVE PRODUCING WELLHEAD
- ABANDONED WELLHEAD

- ===== LEASE BOUNDARY
- ADJOINER LINE
- EXISTING ROAD
- EXISTING STREAM

**REVISIONS:**

DATE: 06-6-2025

352-115

DRAWN BY: S.C.S.

SCALE: 1" = 400'

DRAWING NO: 352-115

WELL LOCATION PLAT