


1/22/73

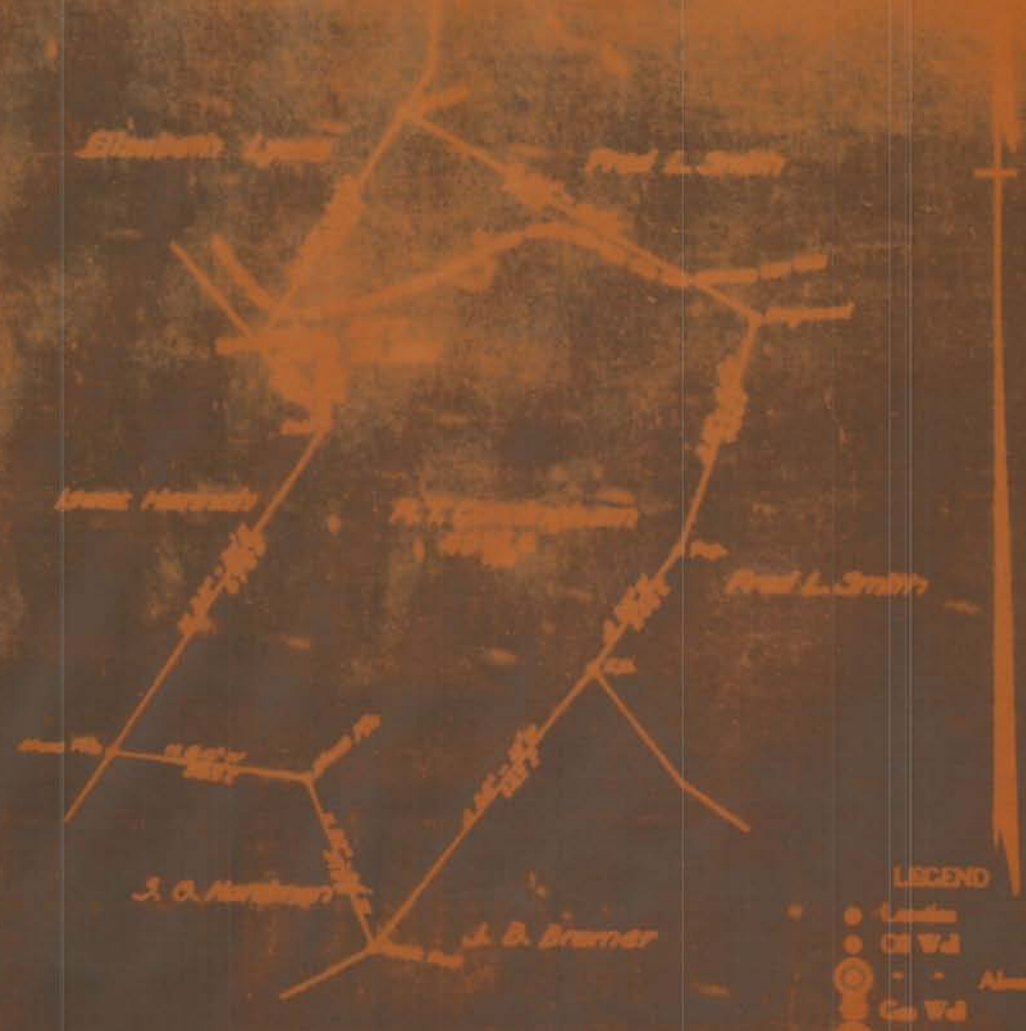

LEGEND

- Location
- Oil Well
- - - - - - Aband.
- Gas Well
- - - - - - Aband.
- Dry Hole

HAR-200-A

ENGINEER'S CERTIFICATE

I, the undersigned, hereby certify that this map is correct and shows all the information to the best of my knowledge and belief, required by the oil and gas section of the state of Texas.

*[Signature]*

OIL AND GAS DIVISION

PRELIMINARY DATA SHEET NO. 1

File No.

Well No. 1

J. M. Reed & Ws. Jones

Company of

Salmon V. Va.

in the

S. C. Cunningham

Field

containing

Oil

area Location

Barlis

District, or

Barliss

County, West Virginia

The surface of the above tract is owned in fee by

Barliss C. Cunningham

of Salmon V. Va.,

S F D No.

address, and the mineral rights are owned in

The oil and gas privileges are held under lease by the above named company and the same is drilled under permit

No. issued by the West Virginia Department of Mines, Oil and Gas

Description of surface as map of well

1-00

Section

The number of feet of the different sand strata met in the well

Feet	Section	Feet	Section	Feet	Section
1000	feet	0-6 1/2'	feet	27-28'	feet
600'	feet	8'	feet		feet
	feet		feet		feet
	portion of		feet		feet
	portion of		feet		feet
	is being perforated at		feet		feet
	is being perforated at		feet		feet

Coal was encountered at 200 feet thickness 420-72 section and at

feet thickness surface and at feet thickness section

Layers were used as follows: (Give details)

June 1911, 1914.

Approved: *[Signature]*  
 by *[Signature]*

FORMATION RECORD

Well No. 1 *HAN 200 A*

Name	Color	Character	Oil, Gas or Water	Top	Bottom	Thickness	Total Depth	Remarks
Pittsburgh Coal				223	No record	App. 6'		
Fifty Foot Sand		Gas	2200	2170	2213	43'		
Fourth Sand		Oil	2412-2416	2396	2431	33'	2454	

shot  
Well was not shot at \_\_\_\_\_ feet; well was shot at 2411 to 2425 feet.

Sub-  
Fresh water at No record feet; fresh water at No record feet.

producing hole  
Well was dry

June 18th, 1942  
Date

Approved *J. M. Reed* <sup>W. H. Mason</sup> by *J. M. Reed*  
Owner

NOTE: All bottom formations

No coal operations in this section.

J. M. Read & Th. Moses

COAL OPERATOR OR OWNER

NAME OF WELL OPERATOR

Coal Owner;

ADDRESS

Salon, N. Va.

COMPLETE ADDRESS

Unknown.

AUG. 1935, 19

COAL OPERATOR OR OWNER

WELL AND LOCATION

ADDRESS

Sardia

District

COAL OPERATOR OR OWNER

Harrison

County

Well No. 1, (Formerly H C & R Co. #207)

ADDRESS

R. T. Cunningham

Farm

AFFIDAVIT TO BE MADE IN REPLICATES, AND COPY TO BE MAILED BY REGISTERED MAIL TO THE APPLICANT, AND COPY TO BE DELIVERED BY THE WELL OPERATOR AND THE THIRD COPY (AND EXTRA COPIES IF DESIRED), TO BE KEPT IN EACH COAL OPERATOR'S OFFICE UNDER AT THEIR RESPECTIVE ADDRESSES.

AFFIDAVIT

STATE OF WEST VIRGINIA,

COUNTY OF Harrison

vs

B. A. MITCHELL & A. G. PARKER

and

being first duly sworn according to law depose and say that they are experienced in the work of plugging and filling oil and gas wells and were employed by RAAD & MOSES, well operator, and participated in the work of plugging and filling the above well, that said work was commenced on the \_\_\_\_\_ day of JUNE XX, 1934, and that the well was plugged and filled in the following manner:

Manner in which mud was plugged: Filled hole with Clay and Mud to 2378-20' above Fourth sand and placed cement plug and revoed 5-3/16 casing - which was set at 2346' and filled hole with mud & Clay to 2150-20' Above Fifty Foot Sand and placed ~~with~~ cement & Wood plug. INSTALLED permanent bridge at 1700' and filled hole with mud and clay to 1610 - 20' above big Injun Sand and placed ~~at~~ Wood Plug and removed 1200 feet of 6 5/8 casing and filled hole with mud and clay to 630' and placed cement and wood plug and continued filling to 250' approximately 30' below Ritts. Coal Seam and filled hole with cement ~~in which coal was plugged~~ water only to 203-20' Above Coal Seam and from this point to the surface the hole was filled to the surface with mud and clay and cement monument erected over the hole as follows.

30 inches by 30 square 12 inches deep with cement post 8 inches square 22 inches high with the name written as follows. In the cement, RAAD & MOSES, CUNNINGHAM #1, JUNE, 1934.

Description of monument.

and that the work of plugging and filling said well was completed on the \_\_\_\_\_ day of July, 1934.

And further deponents with me

*Handwritten:* Mar-200-A  
B. A. Mitchell  
A. G. Parker  
In copy  
Notary Public

Sworn to and subscribed before me this 6th day of July, 1935

Notary Public

LOCATION NOT FOUND