

3.28 S  
0.40 W  
0.48 S  
3.32 S

Well to be abandoned

Company	South Penn Oil Co. 0772
Address	411 7th Ave. Pittsburgh, Pa.
Farm	J. F. Randolph
Tract	Acres 150 Lease N. 33174
Well (Farm) No.	5 Serial No.
Quadrangle	Centerpoint (26)
County	Harrison
District	Ten Mile
Engineer	E. C. Tabler
Engineer's Registration No.	
File No.	Drawing No.
Date	1-18-37 Scale 1" 800'

STATE OF WEST VIRGINIA  
Department of Mines  
OIL AND GAS DIVISION  
Charleston

WELL LOCATION MAP  
File No. HAR-362A

+ Denotes location of well on U.S. Topographic Maps, scale 1 to 62,500 latitude and longitude lines being represented by border lines as shown.

- Denotes one inch spaces on border line of original tracing.

305

WEST VIRGINIA DEPARTMENT OF MINES  
OIL AND GAS DIVISION

WELL RECORD

OIL  
GAS

Permit No. HAR-362-A


Oil or Gas Well (Kind) .....

Company SOUTH PENN OIL COMPANY  
 Address C. of C. Bldg. Pittsburgh, Pa.  
 Farm J. F. Randolph Acres 150  
 Location (waters) Salem Fork of Ten Mile  
 Well No. 5 Elev. 1232.04  
 District Ten Mile County Harrison  
 The surface of tract is owned in fee by B.C. Nicholson  
R.F.D. No. 2 Address Salem, W.Va.  
 Mineral rights are owned by Martena F. Randolph et al  
 Address Salem, W.Va.  
 Drilling commenced Feb. 15, 1908  
 Drilling completed May 9, 1908  
 Date shot 1-18-11-15 Depth of shot -  
 Open Flow 20 /10ths Water in 1" Inch  
- /10ths Merc. in - Inch  
 Volume - Cu. Ft.  
 Rock Pressure 75 lbs. 24? hrs.  
 Oil 3 bbls., 1st 24 hrs.  
 Fresh water 1800 feet - feet  
 Salt water - feet - feet

Casing and Tubing	Used in Drilling	Left in Well	Packers
Size			Kind of Packer. -
16			
13			
10	397	302	Size of. -
8 1/4	1540	604	-
ad 5/8	2359	2359	Depth set. -
5 3/16	3046	3046	-
3			Perf. top. -
2	3100		Perf. bottom. -
Liners Used			Perf. top. -
			Perf. bottom. -

CASING CEMENTED - SIZE - No. FT. - Date -  
 COAL WAS ENCOUNTERED AT - FEET - INCHES  
- FEET - INCHES - FEET - INCHES  
- FEET - INCHES - FEET - INCHES

Formation	Color	Hard or Soft	Top	Bottom	Oil Gas or Water	Depth Found	Remarks
Pittsburgh Coal			1023	1029			
Little Dunkard Sand			1430	1460			
Big Dunkard Sand			1535	1570			
First Gas Sand			1775	1825			
Big Lime			2315	2365	Water	1800	
Big Injun Sand			2365	2470			
Thirty Foot Sand			2985	3010			
Stray Sand			3048	3068			
Gordon Sand			3091	3104	Oil Gas	3096 3063	
Total Depth				3104			

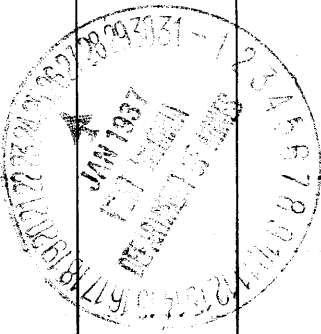



Ten Mile District, Harrison County, W. Va.

By South Penn Oil Co., C. of C. Bldg., Pittsburgh, Pa.

On 150 acres, on Salem Fork of Ten Mile Creek; surface owned by

B. C. Nicholson, R. F. D. No. 2, Salem, W. Va., and minerals

by Martena F. Randolph et al., Salem, W. Va.

Elevation, 1232.04' L.

Drilling commenced Feb. 15, 1908; completed, May 9, 1908.

Shot 5-8-09, with 20 qts.; and 1-18-11, with 15 qts.

Open flow, 20/10ths water in 1".

Rock pressure, 75 lbs. in 24<sup>1</sup>/<sub>2</sub> hrs.

Oil, 3 bbls. 1st 24 hrs.

Water at 1800'.

10" casing, 397'; 8<sup>1</sup>/<sub>4</sub>"<sup>1</sup>/<sub>2</sub>", 1540'; 6<sup>5</sup>/<sub>8</sub>"<sup>1</sup>/<sub>2</sub>", 2359'; 5<sup>1</sup>/<sub>2</sub>"<sup>1</sup>/<sub>2</sub>", 3046'; 2" tubing, 3100'.

Oil and gas well. Abandonment reported to Dept. of Mines Jan. 22, 1937.

Record to RCT from D. G. Courtney (Dept. of Mines) 5-5-37.

	Top.	Bottom.
Pittsburgh Coal	1023	- 1029
Little Dunkard Sand	1430	- 1460
Big Dunkard Sand	1535	- 1570
First Gas Sand (water, 1800')	1775	- 1825
Big Lime	2315	- 2365
Big Injun Sand	2365	- 2470
30-Ft. Sand	2985	- 3010
Stray Sand	3048	- 3068
Gordon Sand (oil, 3096'; gas, 3063')	3091	- 3104
Total depth		3104