


0
1
2
3

J. H. Benedum

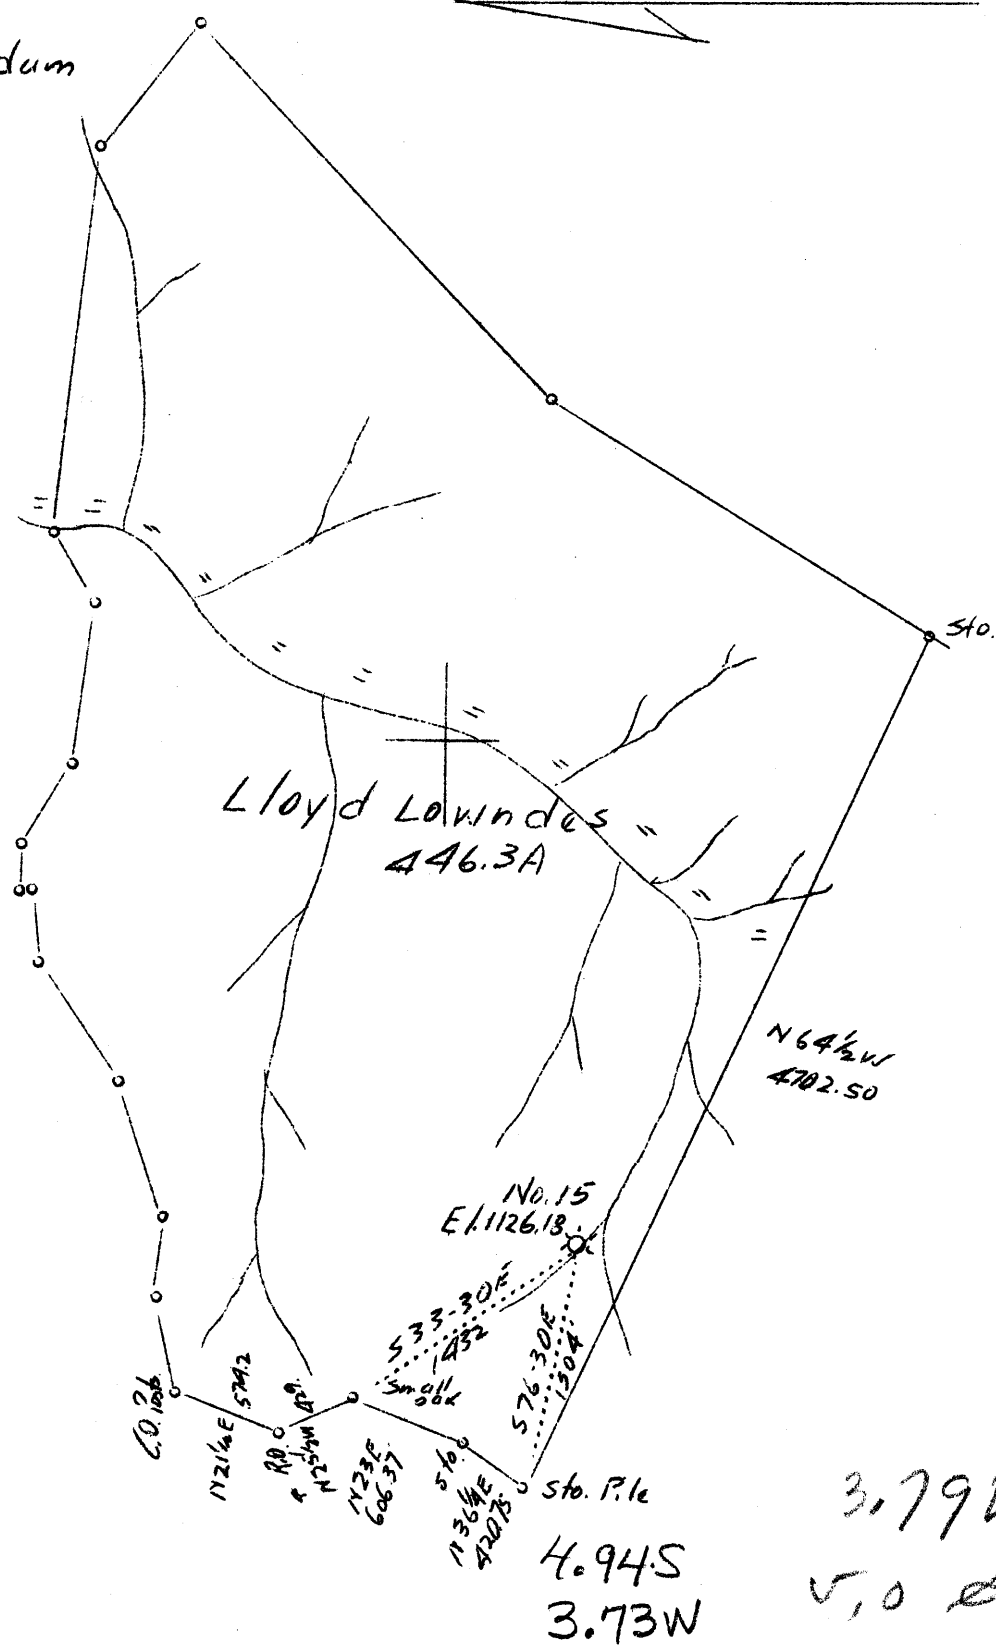

Company	F.G. Bish	1964
Address	Clarksburg, W. Va.	
Farm	Lloyd Lowndes	
Tract	Acres	446.3 Lease No.
Well (Farm) No.	15	Serial No.
Elevation (Spirit Level)	1126.18	
Quadrangle	Centerpoint	SE
County	Harrison	District Ten Mile
Engineer	Hornor Bros., (Paul Allen Hornor)	
Engineer's Registration No.	602	
File No.	Drawing No.	
Date	July 17, 1937	Scale 1"-1000'

STATE OF WEST VIRGINIA
 Department of Mines
 OIL AND GAS DIVISION
 CHARLESTON

WELL LOCATION MAP
 File No. FIAR-396A

+ Denotes location of well on United States Topographic Maps, scale 1 to 62,500, latitude and longitude lines being represented by border lines as shown.

— Denotes one inch spaces on border

RECEIVED
AUG 23 1937

RECEIVED
AUG 23 1937