


0
-1
-2
-3

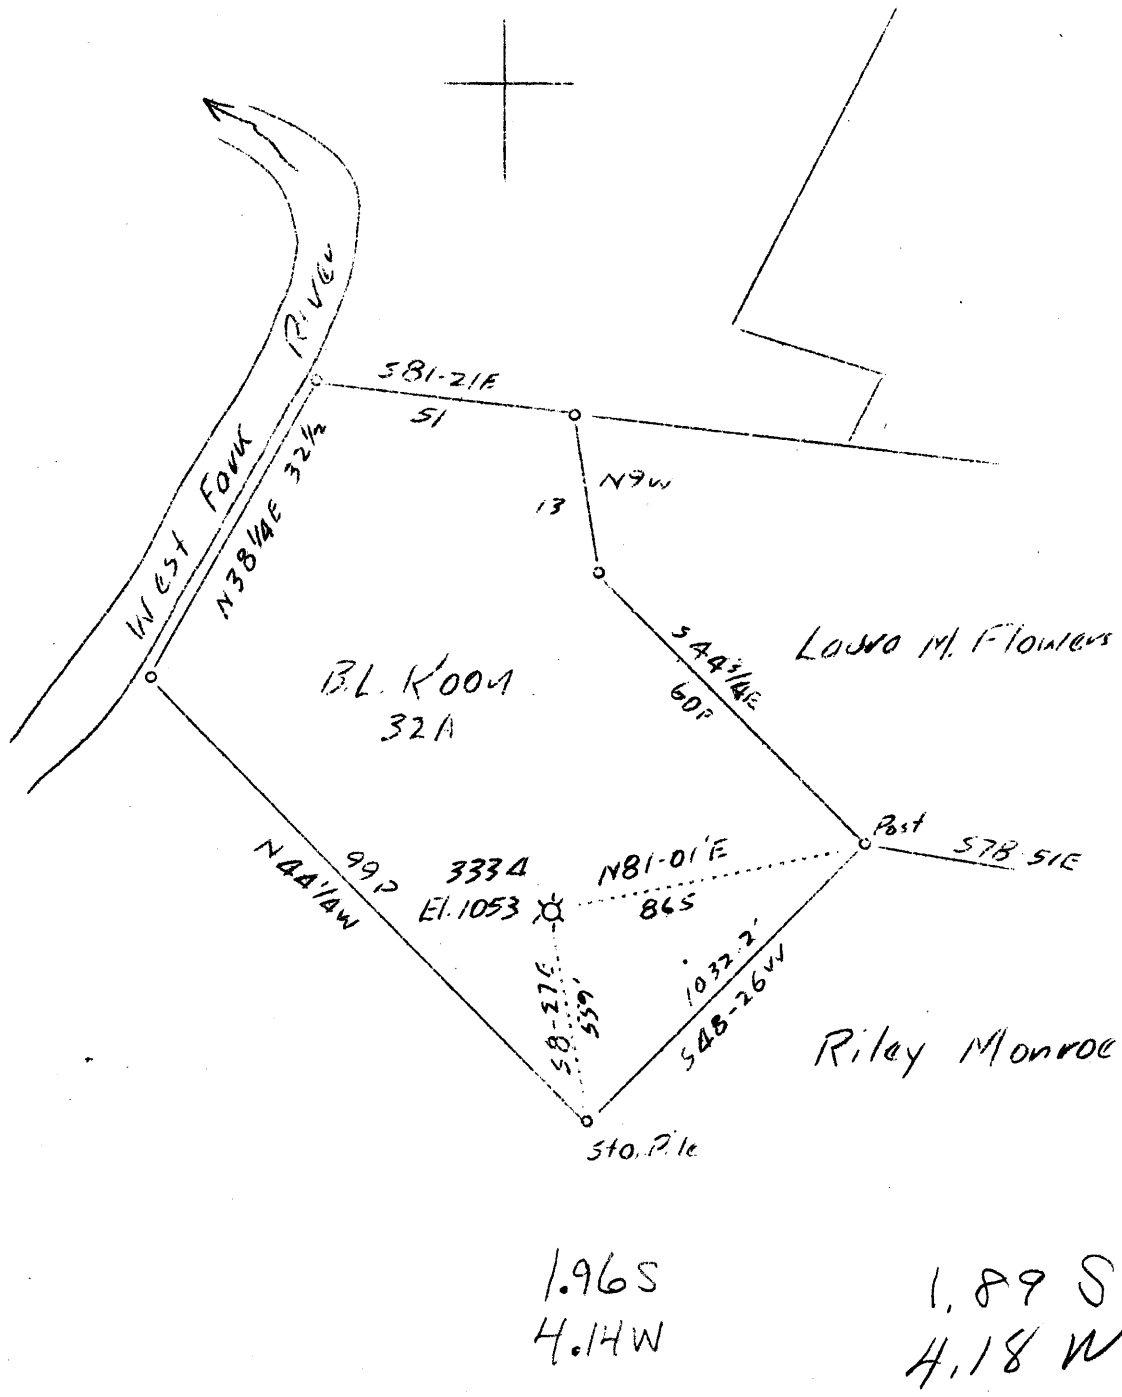

Abd.

Company	Hope Natural Gas Co. 0394
Address	Clarksburg, W.Va.
Farm	B.L.Koon
Tract	Acres 32 Lease No. _____
Well (Farm) No.	1 Serial No. 3334
Elevation (Spirit Level)	1053'
Quadrangle	Clarksburg SC.
County	Harrison District Coal
Engineer	J.A.Clark
Engineer's Registration No.	744
File No.	Drawing No. _____
Date	9-30-37 Scale 1"-500'

STATE OF WEST VIRGINIA
 Department of Mines
 OIL AND GAS DIVISION
 CHARLESTON

WELL LOCATION MAP

File No. HAR-413A

+ Denotes location of well on United States Topographic Maps, scale 1 to 62,500, latitude and longitude lines being represented by border lines as shown.

— Denotes one inch spaces on border line of original tracing.

RECEIVED
JAN 4 1938
AMERICAN
LIBRARY

[Faint, illegible text on a lined page, possibly bleed-through from the reverse side of the document.]