

ABD

FB. 668 P. 12-13 S. 12-E. 13 SH. 44

Company Reserve Gas Co. 5159
 Address Clarksburg, W. Va.
 Farm T. T. Carter
 Acres 124
 Lease No. 598
 Well (Farm) No. One
 Serial No. R-165
 Elevation (SP) 1336
 Quadrangle Clarksburg S. C.
 County Harrison
 District Clark
 Engineer C. C. Reed
 Eng. Reg. No. 911
 Date Oct. 25, 1938
 Scale 1" - 400'

STATE OF WEST VIRGINIA
 Department of Mines
 OIL & GAS DIVISION
 Charleston

WELL LOCATION MAP

File No. Har-450-1

x Denotes location of well on U. S. Topographic Maps, scale 1 to 62,500, latitude and longitude lines being represented by border lines as shown.

- Denotes one inch spaces on border line of original tracing.

STATE OF WEST VIRGINIA
DEPARTMENT OF MINES
OIL AND GAS DIVISION

362

AD 450-A

WELL RECORD

Oil or Gas Well Gas
(Kind)


Permit No. 450-A

Company Reserve Gas Company
 Address Clarksburg, W. Va
 Farm T. T. Carter Acres 124
 Location (waters) Davissons Run
 Well No. 165 Elev. _____
 District Clark County Harrison
 The surface of tract is owned in fee by _____
 Address _____
 Mineral rights are owned by _____
 Address _____
 Drilling commenced 5-12-1909
 Drilling completed 6-16-1909, Deeper April 1926.
 Date shot 3-12-1914 Depth of shot 2513
 Open Flow /10ths Water in _____ Inch
 /10ths Merc. in _____ Inch
 Volume _____ Cu. Ft.
 Rock Pressure _____ lbs. _____ hrs.
 Oil _____ bbls., 1st 24 hrs.
 Fresh water _____ feet _____ feet
 Salt water 1120 feet _____ feet

Casing and Tubing	Used in Drilling	Left in Well	Packers
Size			
16.			Kind of Packer
13.			
10.	<u>165</u>	<u>166</u>	Size of
8 3/4	<u>1154</u>	<u>1154</u>	
6 5/8	<u>1603</u>	<u>1603</u>	Depth set
5 3/16	<u>2325</u>	<u>2325</u>	
3.	<u>3233</u>	<u>Pulled</u>	Perf. top
2.			Perf. bottom
Liners Used			Perf. top
			Perf. bottom

CASING CEMENTED _____ SIZE _____ No. FT. _____ Date _____
Not cemented
 COAL WAS ENCOUNTERED AT 151 FEET 60 INCHES
 _____ FEET _____ INCHES _____ FEET _____ INCHES
 _____ FEET _____ INCHES _____ FEET _____ INCHES

Formation	Color	Hard or Soft	Top	Bottom	Oil Gas or Water	Depth Found	Remarks
Pittsburgh Coal			151	156			
Little Dunkard Sand			580	615			
Big Dunkard Sand			652	690			
Gas Sand			760	800			
First Salt Sand			845	880			
Second Salt Sand			1075	1146	Water	1120	
Maxon Sand			1400	1425			
Little Lime			1485	1505			
Pencil Cave			1505	1531			
Big Lime			1531	1597			
Big Injun Sand			1597	1708	Gas	1700	
Squaw Sand			1798	1820			
Gantz Sand			1825	1845			
Berea Sand			2020	2035			
Fifty Foot Sand			2079	2164	Gas	2094	
Thirty Foot Sand			2179	2201			
Gordon Stray Sand			2305	2325			
Gordon Sand			2333	2355			
Fourth Sand			2431	2451			
Fifth Sand			2513	2535	Gas	2516	
Speechley Sand			3211	3221	Gas	3212	
Total Depth				3233			

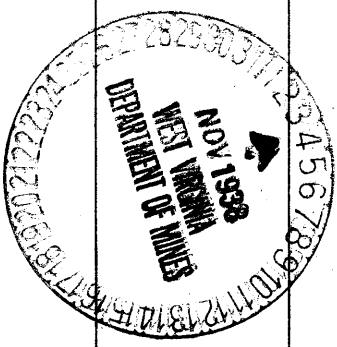

NOV 16 1938

