

4.53S 4.33S
 0.54W 0.48W

ABD. R-122

F.B. 670 P13 513E10 54.44

Company	Reserve Gas Co.
Address	Clarksburg, W. Va.
Farm	Jas. Garrett
Acres	112
Lease No.	27
Well (Farm) No.	1-2
Serial No.	R-43 and R-122
Elevation (SL)	See plat
Quadrangle	Clarksburg
County	Harrison
District	Clark
Engineer	W. M. Bowers
Eng. Reg. No.	900
Date	March 21, 1939
Scale	1" - 800'

STATE OF WEST VIRGINIA
 Department of Mines
 OIL & GAS DIVISION
 Charleston

WELL LOCATION MAP

File No. Har-473-17

x Denotes location of well on U. S. Topographic Maps, scale 1 to 62,500, latitude and longitude lines being represented by border lines as shown.

- Denotes one inch spaces on border line of original tracing.

STATE OF WEST VIRGINIA
DEPARTMENT OF MINES
OIL AND GAS DIVISION

389

WELL RECORD

AP 473-A
Permit No. 473-A


Oil or Gas Well Gas
(Kind)

Company **Reserve Gas Company**
 Address **Clarksburg, W. Va.**
 Farm **Jas. Garrett** Acres **112**
 Location (waters) **Davissons Run**
 Well No. **122** Elev. **1107**
 District **Clark** County **Harrison**
 The surface of tract is owned in fee by **Jas. Garrett Heirs**
Agnes J. Garrett Address **Clarksburg, W. Va.**
 Mineral rights are owned by _____
 Address _____
 Drilling commenced **December 30, 1907**
February 5, 1908
 Drilling completed _____
 Date shot **June 25, 1913** Depth of shot **2927-2935**
 Open Flow /10ths Water in _____ Inch
 /10ths Merc. in _____ Inch
 Volume _____ Cu. Ft.
 Rock Pressure _____ lbs. _____ hrs.
 Oil _____ bbls., 1st 24 hrs.
 Fresh water **None recorded** feet _____ feet
 Salt water **850** feet _____ feet

Casing and Tubing	Used in Drilling	Left in Well	Packers
Size			Kind of Packer
16.			
13.			
10.	248	248	Size of
8 1/4	870	870	
6 5/8	1509	1509	Depth set
5 3/16	2059	2059	
3.			Perf. top
2.	2958	2958	Perf. bottom
Liners Used			Perf. top
			Perf. bottom

CASING CEMENTED _____ SIZE _____ No. FT. _____ Date _____
Not cemented
 COAL WAS ENCOUNTERED AT _____ FEET _____ INCHES
No coal
 _____ FEET _____ INCHES _____ FEET _____ INCHES
 _____ FEET _____ INCHES _____ FEET _____ INCHES

Formation	Color	Hard or Soft	Top	Bottom	Oil Gas or Water	Depth Found	Remarks
Little Dunkard Sand			250	300			
Big Dunkard Sand			380	460			
Gas Sand			600	660			
First Salt Sand			700	750			
Second Salt Sand			800	855	Water	850	
Maxon Sand			1025	1040			
Little Lime			1265	1275			
Pencil Cave							
Big Lime			1277	1332			
Big Injun Sand			1332	1432	Gas	1362	
Fifty Foot Sand			1848	1880			
Thirty Foot Sand			1895	1925	Gas	1920	
Gordon Stray Sand			1970	2062			
Gordon Sand			2070	2098			
Fifth Sand			2225	2250	Gas	2227	
Speechley Sand			2925	2932	Gas	2927	
Total Depth			2950				

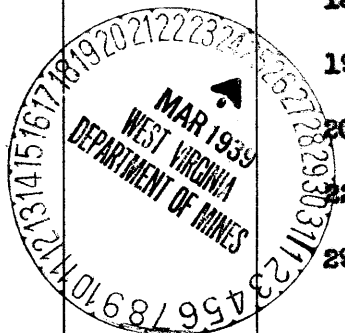

MAY 21 1909

