


LATITUDE 39° 20'

LONGITUDE 80° 20'

JOHN DOLAN
301 A^c

HARRISON CO. POOR FARM

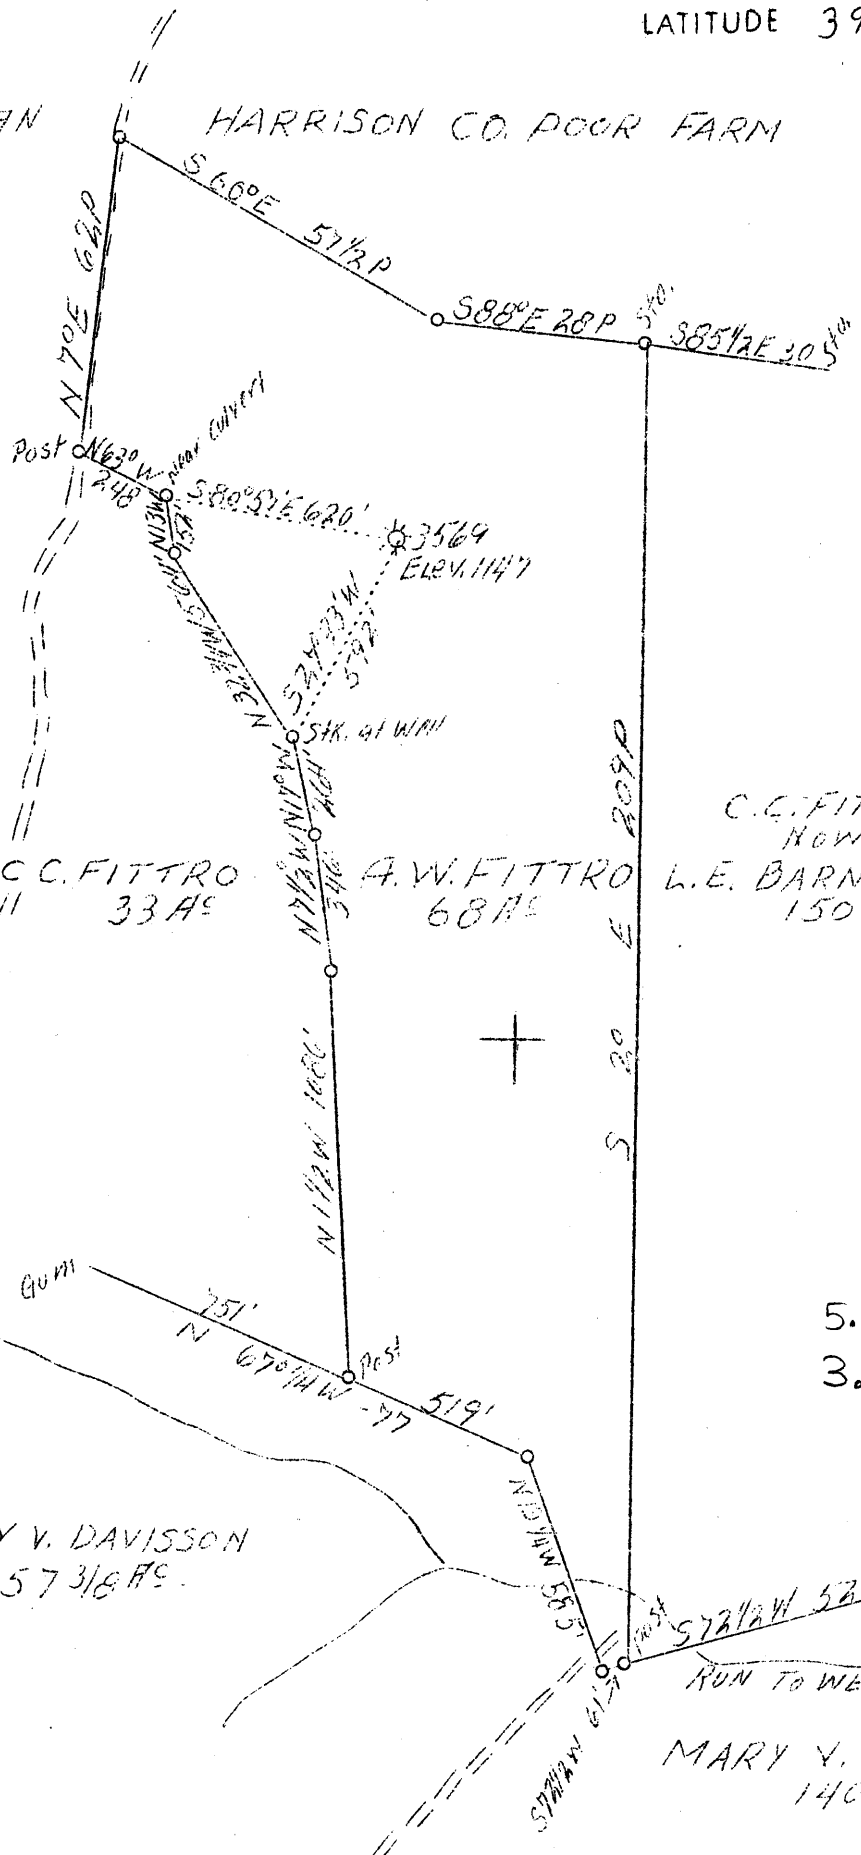

C.C. FITTRO
33 A^c

A.W. FITTRO
68 A^c

C.C. FITTRO
NOW
L.E. BARNETT HRS.
150 A^c

MARY V. DAVISSON
57 3/8 A^c

MARY V. DECK
140 A^c

5.34S
3.08W

A.B.D.

F.B. 512 P27, MAP # 44, 514 E 12

Company Hope Natural Gas Co.
 Address Clarksburg, W.Va.
 Farm A.W. Fittro
 Tract 1
 Acres 68
 Lease No. 15359
 Serial No. 3569
 Well (Farm) No. 1
 El. (S. L.) 1147
 Quadrangle Clarksburg *SC*
 County Harrison
 District Clark
 Eng. W.M. Bowers
 Eng. Reg. No. 900
 Date 4/21/39
 Scale 1" = 500'

STATE OF WEST VIRGINIA
 Department of Mines
 OIL AND GAS DIVISION
 Charleston

WELL LOCATION MAP

File No. Hos-479-A

x Denotes location of well on U.S. Topographic Maps, scale 1 to 62,500, latitude and longitude lines being represented by border lines as shown.

- Denotes one inch spaces on border line of original tracing.

STATE OF WEST VIRGINIA
DEPARTMENT OF MINES
OIL AND GAS DIVISION

WELL RECORD

388

Oil or Gas Well Gas
(Kind)

AD
Permit No. 479-A

Company Hope Natural Gas Company
Address Clarksburg, W. Va.
Farm A. W. Fittro Acres 33
Location (waters) West Fork River
Well No. 3569 Elev. 1147
District Clark County Harrison
The surface of tract is owned in fee by Mary V. Davisson
R #1. Address Clarksburg, W. Va.
Mineral rights are owned by Mary V. Davisson
Address _____
Drilling commenced 7-25-1914
Drilling completed 9-18-1914
Date shot 8-19-1914 Depth of shot 5th sand
8-28-1914 Speechley
Open Flow /10ths Water in _____ Inch
/10ths Merc. in _____ Inch
Volume _____ Cu. Ft.
Rock Pressure _____ lbs. _____ hrs.
Oil _____ bbls., 1st 24 hrs.
Fresh water 75 feet _____ feet
Salt water 735 feet _____ feet

Casing and Tubing	Used in Drilling	Left in Well	Packers
Size			
16.			Kind of Packer
13.			
10.	180	168	Size of
8 3/4	930	930	
6 5/8	1464	1464	Depth set
5 3/16	2069	2069	
3.			Perf. top
2.	3118	3118	Perf. bottom
Liners Used			Perf. top
			Perf. bottom

CASING CEMENTED _____ SIZE _____ No. FT. _____ Date _____
Not cemented
COAL WAS ENCOUNTERED AT _____ FEET _____ INCHES
_____ FEET Below coal _____ FEET _____ INCHES
_____ FEET _____ INCHES _____ FEET _____ INCHES

Formation	Color	Hard or Soft	Top	Bottom	Oil Gas or Water	Depth Found	Remarks
Little Dunkard Sand			385	438	Water	75	
Big Dunkard Sand			468	550			
Gas Sand			558	670			
First Salt Sand			685	779	Small Gas Water	717 735	
Second Salt Sand			800	900			
Third Salt Sand			924	990			
Maxon Sand			1255	1330			
Little Lime			1361	1377			
Pencil Cave			1388	1397			
Big Lime			1397	1455			
Big Injun Sand			1455	1566	Gas	1530	
Fifty Foot Sand			1920	1955			
Thirty Foot Sand			1972	2007	Gas	1991	
Gordon Stray Sand			2031	2049	Gas	2059	
Bordon Sand			2250	2265			
Fourth Sand			2290	2312			
Fifth Sand			2368	2391	Gas	2370-2388	
Speechley Sand			3063	3069	Gas	3065	
Total Depth			3105				

Formation	Color	Hard or Soft	Top	Bottom	Oil, Gas or Water	Depth Found	Remarks

Date April 21, 19 39

APPROVED Hope Natural Gas Company, Owner

By *[Signature]* General Supt.
(Title) *[Signature]*