


LATITUDE 39° 10'

LONGITUDE 80° 30'

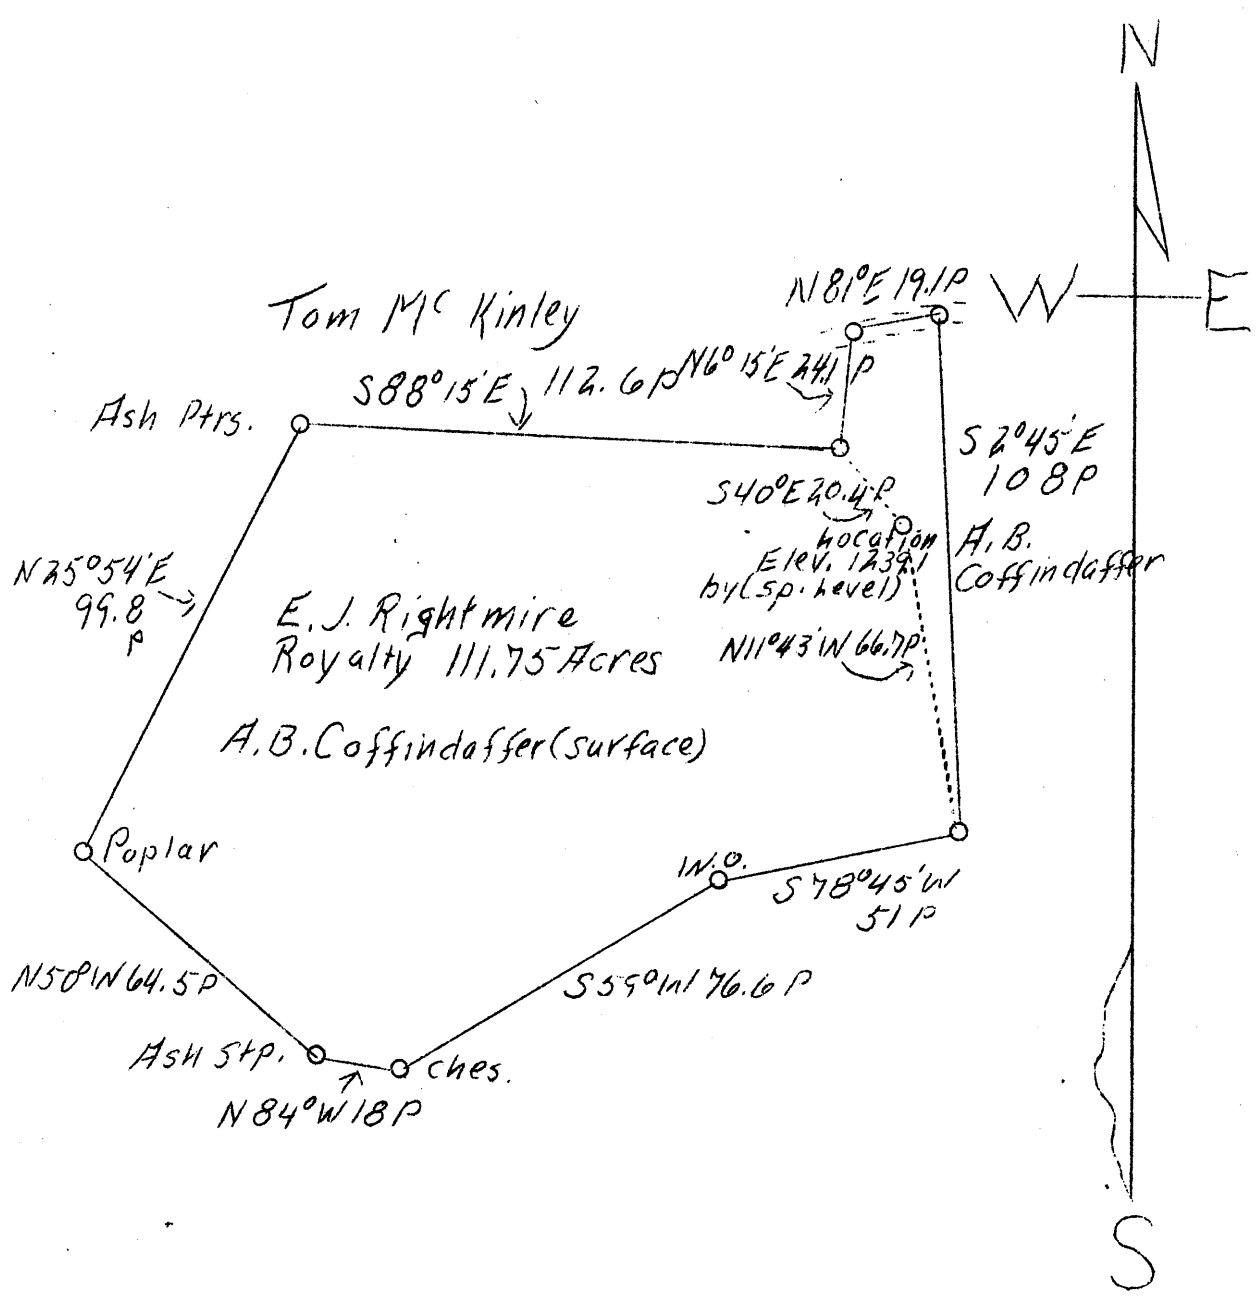

0.23S
1.31W

ABD.

Company	Septer W. Douglas 3307
Address	Pittsburgh, Pa.
Farm	E. J. Rightmire
Tract	1
Acres	111.75
Well (Farm) No.	4
Quadrangle	Vadis, X. E.
County	Harrison
District	Union
Engineer	M. L. B. Linger
Eng. Reg. No.	261
Date	May 29, 1939
Scale	1" - 40 poles

STATE OF WEST VIRGINIA
Department of Mines
OIL & GAS DIVISION
Charleston

WELL LOCATION MAP

File No. Har-489-1A

x Denotes location of well on U. S. Topographic Maps, scale 1 to 62,500, latitude and longitude lines being represented by border lines as shown.

- Denotes one inch spaces on border line of original tracing.