


Latitude 39° 15'

FORK

WEST

RIVER

Longitude 80° 20'

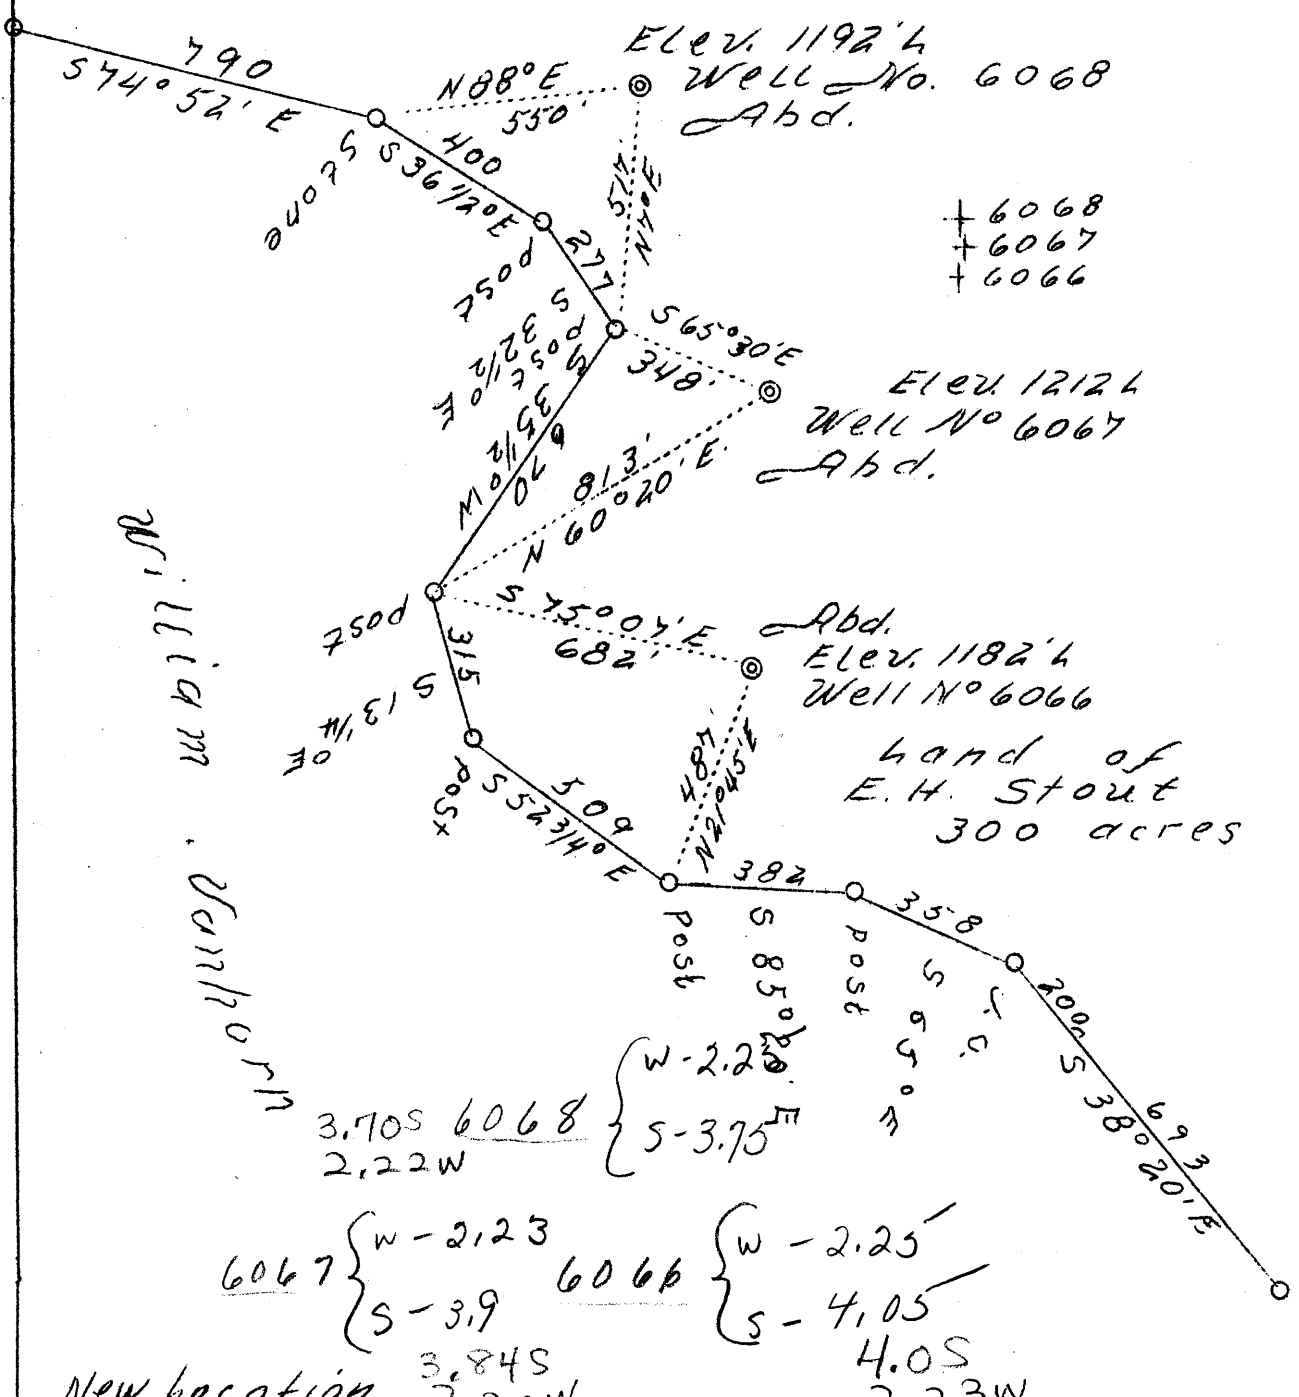

Company H. E. Milliken & A. M. 5257  
 Snider  
 Address Waynesburg, Pa.  
 Farm E. H. Stout  
 Tract 1  
 Acres 300  
 Well No. (Farm) 6068, 6067 and 6066  
 Elevation -  
 Quadrangle Weston N.C.  
 District Grant  
 County Harrison  
 Engineer David Weed  
 Eng. Reg. No. 233-16-5767  
 Date August 14, 1939  
 Scale 1" = 400'

STATE OF WEST VIRGINIA  
 Department of Mines  
 OIL & GAS DIVISION  
 Charleston

WELL LOCATION MAP

File No. HOR-512-13-574

Abandoned  
6068 6067

Grant District, Harrison County, W. Va.

By Milliken & Snider, Waynesburg, Pa.

Abandoned under permit Har-.....-A.

On 300 acres, on West Fork River.

Elevation, 1212' L.

Surface owned by Edward Stout, Clarksburg, W. Va., and minerals by Hutchinson Coal Co., Fairmont, W. Va.

Drilling commenced March 20, 1919; completed, April 29, 1919.

Shot March 12, 1923, at 2348-2361'.

No water recorded.

10" casing, 166'; 8 $\frac{1}{2}$ " , 1037'; 6 $\frac{3}{8}$ " , 1585'; 2" tubing, 2367'; all left in.

Casing not cemented. Starts below coal.

Oil well. Abandonment reported to Dept. of Mines August 18, 1939.

Record to RCT from Mrs. Griffith August 24, 1939.

	Top.	Bottom.
Little Dunkard Sand	425	- 445
Big Dunkard Sand	510	- 560
Gas Sand	605	- 640
First Salt Sand	755	- 805
Second Salt Sand	825	- 965
Third Salt Sand	1005	- 1024
Maxton Sand	1282	- 1334
Little Lime	1495	- 1515
Pencil Cave	1515	- 1530
Big Lime	1530	- 1585
Big Injun Sand	1585	- 1733
Gantz Sand	1960	- 2025
Fifty-foot Sand	2055	- 2097
Thirty-foot Sand (gas, 2165')	2140	- 2223
Gordon Stray Sand	2310	- 2330
Gordon Sand (oil, 2354-2359')	2346	- 2364
Total depth		2364

513A

STATE OF WEST VIRGINIA  
DEPARTMENT OF MINES  
OIL AND GAS DIVISION

415

WELL RECORD

Aband  
Permit No. HAR-513-A

Oil or Gas Well Oil  
(Kind)

Company Milliken & Snider  
Address Waynesburg, Pa.  
Farm E. H. Stout Acres 300  
Location (waters) West Fork River  
Well No. 6067 Elev. 1212  
District Grant County Harrison  
The surface of tract is owned in fee by Edward Stout  
Address Clarksburg, W. Va  
Mineral rights are owned by Hutchinson Coal Co'  
Address Fairmont, W. Va.  
Drilling commenced 3-20-1919  
Drilling completed 4-29-1919  
Date shot 3-12-1923 Depth of shot 2348-2361  
Open Flow /10ths Water in \_\_\_\_\_ Inch  
/10ths Merc. in \_\_\_\_\_ Inch  
Volume \_\_\_\_\_ Cu. Ft.  
Rock Pressure \_\_\_\_\_ lbs. \_\_\_\_\_ hrs.  
Oil \_\_\_\_\_ bbls., 1st 24 hrs.  
Fresh water None recorded feet \_\_\_\_\_ feet  
Salt water None recorded feet \_\_\_\_\_ feet

Casing and Tubing	Used in Drilling	Left in Well	Packers
Size			
16			Kind of Packer
13			
10	166	166	Size of
8 1/4	1037	1037	
6 5/8	1585	1585	Depth set
5 3/16			
3			Perf. top
2	2367	2367	Perf. bottom
Liners Used			Perf. top
			Perf. bottom

CASING CEMENTED \_\_\_\_\_ SIZE \_\_\_\_\_ No. FT. \_\_\_\_\_ Date  
**Not cemented**  
COAL WAS ENCOUNTERED AT \_\_\_\_\_ FEET \_\_\_\_\_ INCHES  
Below coal \_\_\_\_\_ FEET \_\_\_\_\_ INCHES  
\_\_\_\_\_ FEET \_\_\_\_\_ INCHES \_\_\_\_\_ FEET \_\_\_\_\_ INCHES

Formation	Color	Hard or Soft	Top	Bottom	Oil Gas or Water	Depth Found	Remarks
Little Dunkard Sand			425	445			
Big Dunkard Sand			510	560			
Gas Sand			605	640			
First Salt Sand			755	805			
Second Salt Sand			825	965			
Third Salt Sand			1005	1024			
Maxon Sand			1282	1334			
Little Lime			1495	1515			
Pencil Cave			1515	1530			
Big Lime			1530	1585			
Big Injun Sand			1585	1733			
Gantz Sand			1960	2025			
Fifty Foot Sand			2055	2097			
Thirty Foot Sand			2140	2223	Gas	2165	
Gordon Stray Sand			2310	2330			
Gordon Sand			2346	2364	Oil	2354-2359	
Total Depth				2364			

