

3.375
0.94W

N - .97
S - 3.4

New Location
Drill Deeper
Abandonment X

Company South Penn Oil Co. 0792
 Address 411-7th Ave. Pittsburgh, Pa.
 Farm John H. Henderson
 Tract _____ Acres 76 Lease No. 57391
 Well (Farm) No. 6 Serial No. _____
 Elevation (Spirit Level) 1121.27
 Quadrangle Centerpoint E,
 County Harrison District Ten Mile
 Engineer E.C. Tabler
 Engineer's Registration No. _____
 File No. _____ Drawing No. _____
 Date August 25, 1939 Scale 1" = 400'

STATE OF WEST VIRGINIA
 DEPARTMENT OF MINES
 OIL AND GAS DIVISION
 CHARLESTON

WELL LOCATION MAP
 FILE NO. HAR-536A

+ Denotes location of well on United States Topographic Maps, scale 1 to 62,500, latitude and longitude lines being represented by border lines as shown.
 - Denotes one inch spaces on border line of original tracing.

WEST VIRGINIA DEPARTMENT OF MINES
OIL AND GAS DIVISION

423

WELL RECORD

OIL


Permit No. 536-A Oil or Gas Well (Kind) OIL

Company South Penn Oil Company
 Address 411 Seventh Ave., Pittsburgh, Pa.
 Farm John H. Henderson Acres 76
 Location (waters) McIntyre Fork of Rock Camp
 Well No. 6 Elev. 1121.27
 District Sardis County Harrison
 The surface of tract is owned in fee by Camden E. Henderson
c/o Marshall College Address Huntington, W. Va.
 Mineral rights are owned by E.C. Henderson, et al
1619 Fifth Ave. Address Huntington, W. Va.
 Drilling commenced Sept. 28, 1914
 Drilling completed Nov. 28, 1914
 Date shot Dec. 1, 1914 Depth of shot Gordon
 Open Flow 10/10ths Water in 2" Inch
 /10ths Merc. in -- Inch
 Volume -- Cu. Ft.
 Rock Pressure -- lbs. -- hrs.
 Oil 2 bbls., 1st 24 hrs.
 Fresh water -- feet -- feet
 Salt water 1755 feet 1800 feet

Casing and Tubing	Used in Drilling	Left in Well	Packers
Size			Kind of Packer
16			
13			
10"	335 (Pulled)		Size of
8 1/4	1270 (Pulled)		
6 5/8	2306		Depth set
5 3/16	2853		
3			Perf. top
2			Perf. bottom
Liners Used			Perf. top
			Perf. bottom

CASING CEMENTED -- SIZE -- No. FT. -- Date --
 COAL WAS ENCOUNTERED AT 325 (?) FEET ? INCHES
875 FEET 84 INCHES -- FEET -- INCHES
-- FEET -- INCHES -- FEET -- INCHES

Formation	Color	Hard or Soft	Top	Bottom	Oil Gas or Water	Depth Found	Remarks
Native Coal			325				
Pittsburgh Coal			875	882			
Little Dunkard Sand			1255	1305			
Big Dunkard Sand			1380	1410			
Salt Sand			1640	1685			
Do.			1745	1845			
					Water	1755	
					Water	1800	
Maxon Sand			2058	2093			
Little Lime			2105	2123			
Pencil Cave			2123	2128			
Big Lime			2128	2180			
Big Injun Sand			2180	2293			
Fifty Foot Sand			2734	2780			
					Gas	2762	10/10W 2"
Thirty Foot Sand			2853	2865			
Gordon Stray Sand			2884	2941			
Gordon Sand			2960	2992			
					Oil	2968	
Total Depth				3002			

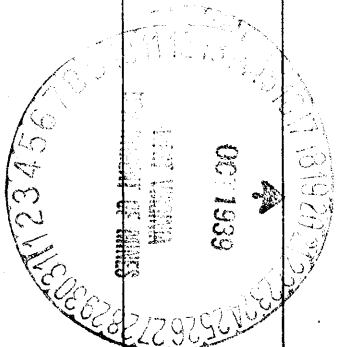

Formation	Color	Hard or Soft	Top	Bottom	Oil, Gas or Water	Depth Found	Remarks

Date **October 18,** 19**39**

APPROVED **SOUTH PENN OIL COMPANY,** Owner

By *Eaton Young* Land Agent
(Title)