


Leonidas Rhoades

J.W. Johnson
&
M.J. Holden

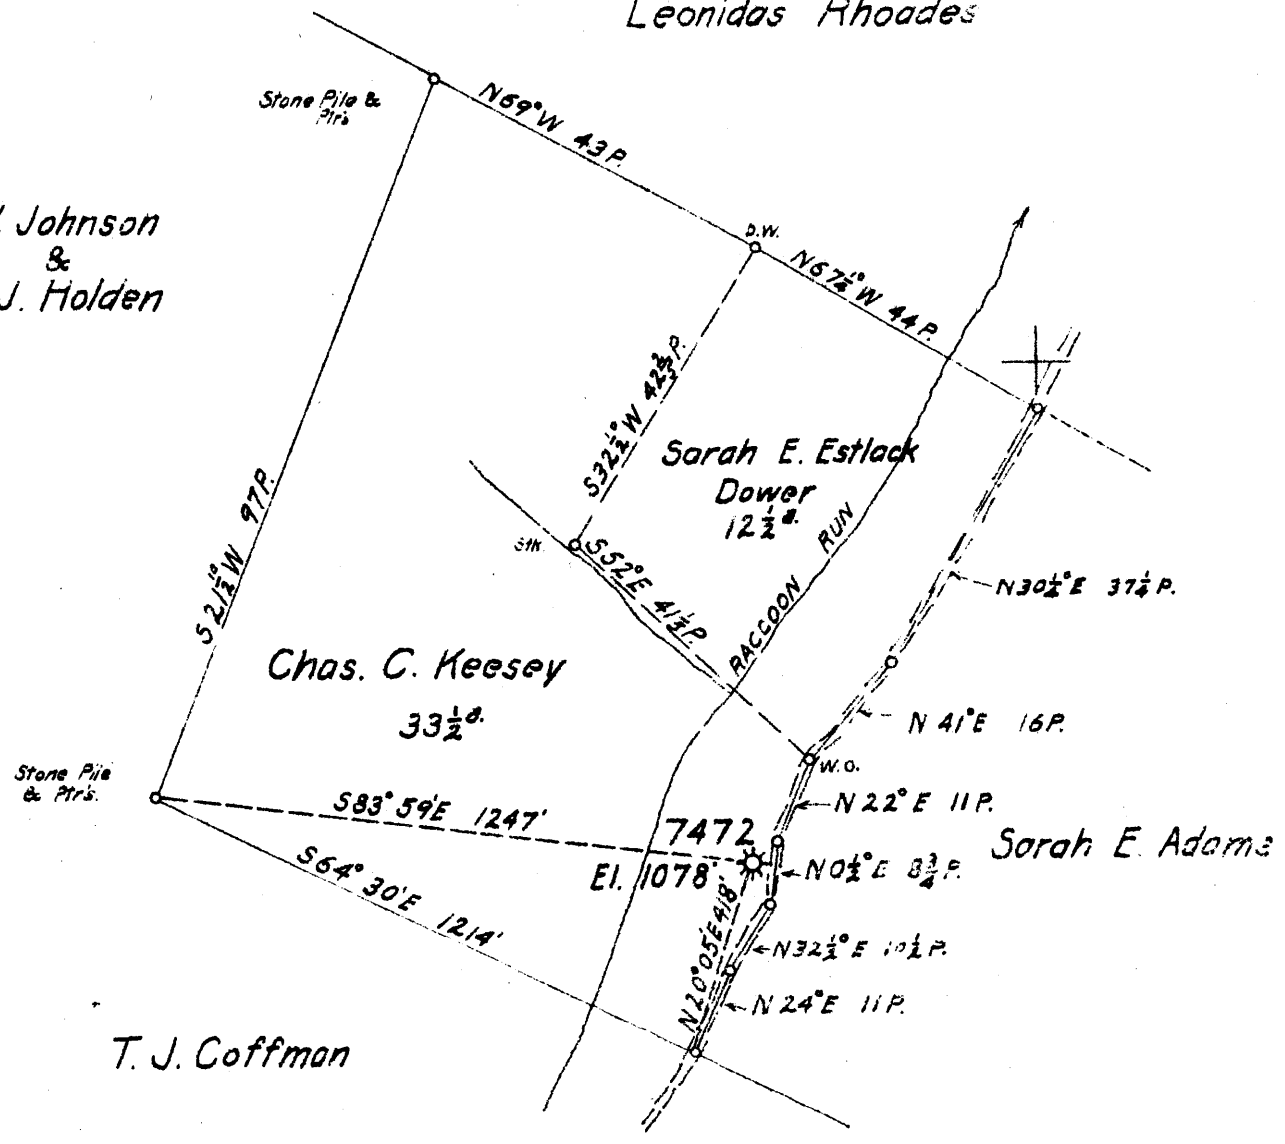

T. J. Coffman

3.98S W - 1.55
1.55W S - 4.05

New Location
Drill Deeper
Abandonment X

FB. 494 P17

Company HOPE NATURAL GAS CO.
 Address CLARKSBURG, W. VA.
 Farm CHAS. C. KEESEY
 Tract _____ Acres 33½ Lease No. _____
 Well (Farm) No. 1 Serial No. 7472
 Elevation (Spirit Level) 1078'
 Quadrangle CENTERPOINT S E
 County HARRISON District TEN MILE
 Engineer W. M. Bowers
 Engineer's Registration No. 900
 File No. _____ Drawing No. _____
 Date NOV. 10, 1939 Scale 1" = 400'

STATE OF WEST VIRGINIA
DEPARTMENT OF MINES
OIL AND GAS DIVISION
CHARLESTON

WELL LOCATION MAP
FILE NO. HAR-543-A

+ Denotes location of well on United States Topographic Maps, scale 1 to 62,500, latitude and longitude lines being represented by border lines as shown.

- Denotes one inch spaces on border line of original tracing.

STATE OF WEST VIRGINIA
DEPARTMENT OF MINES
OIL AND GAS DIVISION

426

WELL RECORD

AB 543-A
Permit No. _____

Gas
Oil or Gas Well _____
(Kind)

Company Hope Natural Gas Company
 Address Clarksburg, W. Va.
 Farm C. C. Keesey Acres _____
 Location (waters) _____
 Well No. 7472 Elev. _____
 District Ten Mile County Harrison
 The surface of tract is owned in fee by _____
 Address _____
 Mineral rights are owned by _____
 Address _____
 Drilling commenced 1922
 Drilling completed August 1922.
 Date shot No record Depth of shot _____
 Open Flow /10ths Water in _____ Inch
 /10ths Merc. in _____ Inch
 Volume _____ Cu. Ft.
 Rock Pressure _____ lbs. _____ hrs.
 Oil _____ bbls., 1st 24 hrs.
 Fresh water None recorded feet _____ feet
 Salt water None recorded feet _____ feet

Casing and Tubing	Used in Drilling	Left in Well	Packers
Size			
16			Kind of Packer
13			
10	355	355	Size of
8 1/4	1277	1277	
6 5/8	2000	2000	Depth set
5 3/16			
3			Perf. top
2	2769	Pulled	Perf. bottom
Liners Used			Perf. top
			Perf. bottom

CASING CEMENTED _____ SIZE _____ No. FT. _____ Date _____
Not cemented
 COAL WAS ENCOUNTERED AT 648 FEET 96 INCHES
 FEET INCHES FEET INCHES
 FEET INCHES FEET INCHES

Formation	Color	Hard or Soft	Top	Bottom	Oil Gas or Water	Depth Found	Remarks
Pittsburgh Coal			648	656			
Little Dunkard Sand			1005	1030			
Big Dunkard Sand			1132	1155			
Gas Sand			1270	1290			
Second Salt Sand			1570	1665			
Maxon Sand			1886	1961			
Little Lime			1961	1964			
Big Lime			1964	2016			
Big Injun Sand			2016	2108			
Squaw Sand			2165	2320			
Fifty Foot Sand			2512	2535			
Thirty Foot Sand			2595	2625			
Gordon Stray Sand			2647	2701	Gas	2690-2698	
Gordon Sand			2714	2756	Gas	2716-2721	
Total Depth				2760			

