


0
1
2
3

Mary E. Brumer

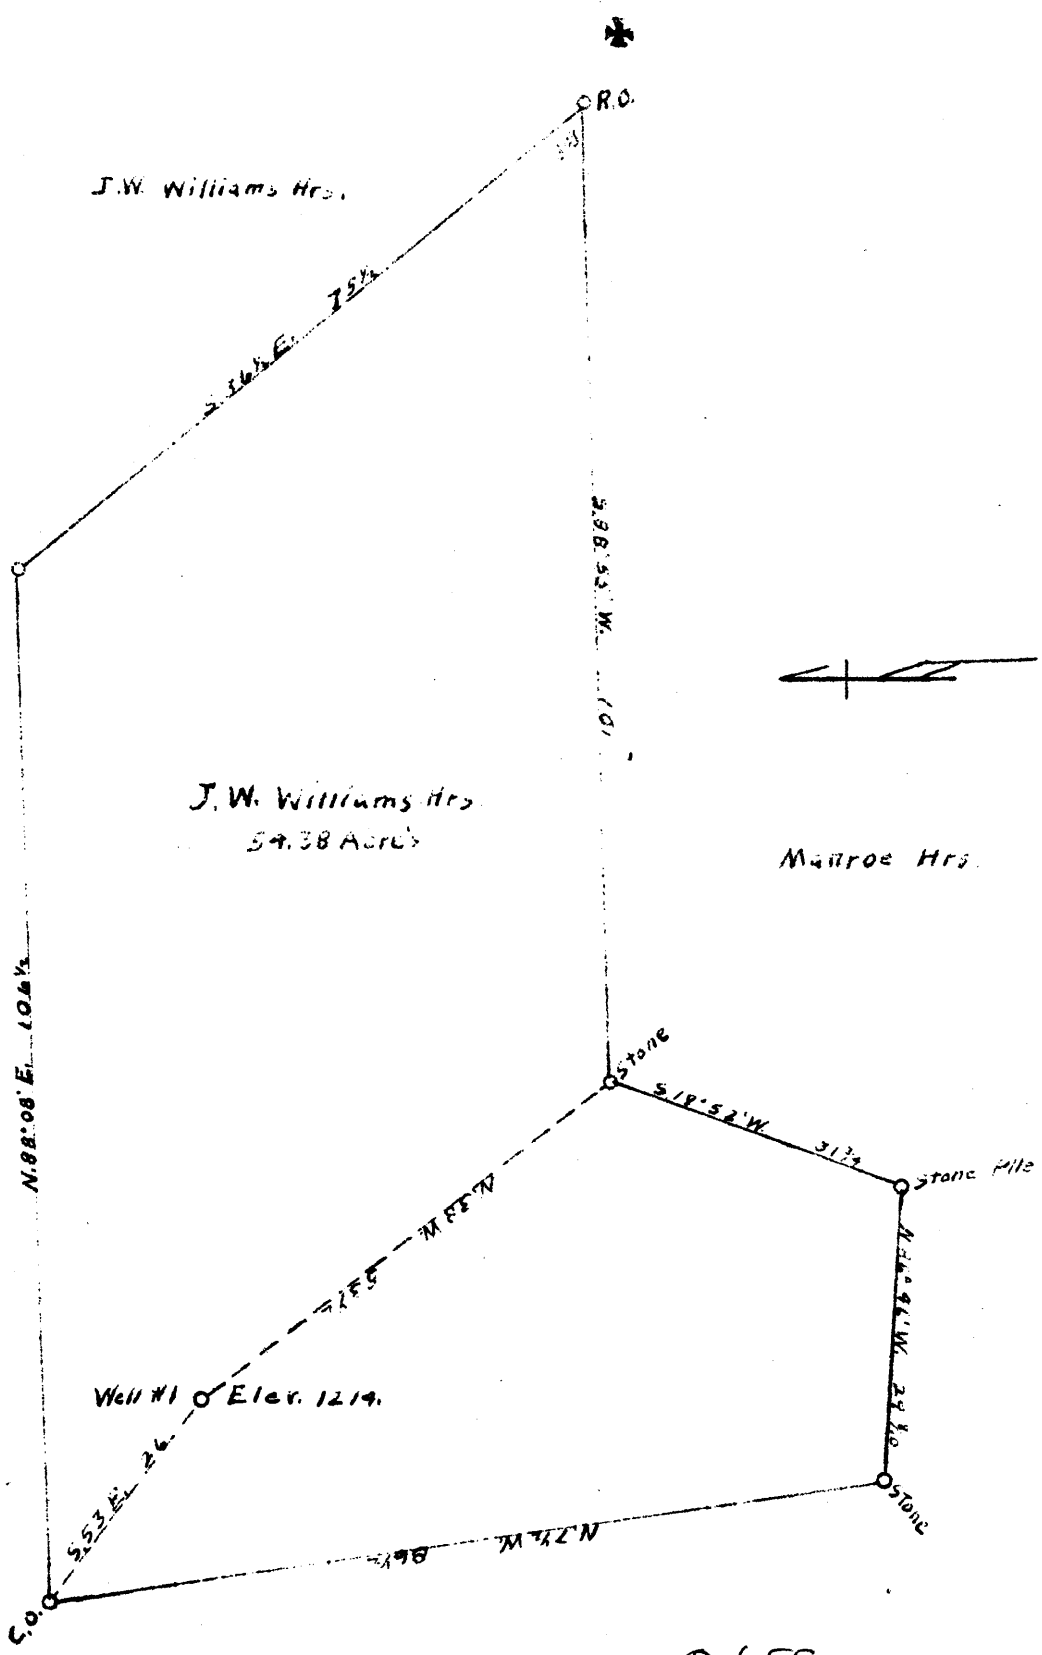

Despart Hrs. 0.65S 2.89W 2.93 W. 0.66 S.

- New Location
- Drill Deeper
- Abandonment

Company William Messes 55202

Address 184 W. Main St. Salem W. Va.

Farm J. W. Williams Hrs.

Tract _____ Acres 59.38 Lease No. _____

Well (Farm) No. 000 Serial No. _____

Elevation (Spirit Level) 1214

Quadrangle Clarkskurg

County Harrison District Ten mile

Engineer C. K. W. [unclear]

Engineer's Registration No. Deputy Co. Surveyor, Ritchie Co.

File No. _____ Drawing No. _____

Date July 17 1946 Scale 1" = 20 Feet

STATE OF WEST VIRGINIA
DEPARTMENT OF MINES
OIL AND GAS DIVISION
CHARLESTON

WELL LOCATION MAP
FILE NO. HAR-598 A

+ Denotes location of well on United States Topographic Maps, scale 1 to 62,500, latitude and longitude lines being represented by border lines as shown.

- Denotes one inch spaces on border line of original tracing.