

Coal: Allegheny Coal Co.
Westernport, Md.
Surface: Mary Barber
Bristol, W.Va.
R.F.D. #2.

0.47S
0.32W
W - .3
S - .48

New Location
Drill Deeper
Abandonment

S15 E 6

Company South Penn Natural Gas Co.
 Address Parkersburg, W.Va.
 Farm W.C. Perrine
 Tract _____ Acres 55 Lease No. 27296
 Well (Farm) No. 4 Serial No. _____
 Elevation (Spirit Level) 1402.96
 Quadrangle Vadis
 County Harrison District Ten Mile
 Engineer E.C. Tabler
 Engineer's Registration No. _____
 File No. _____ Drawing No. _____
 Date March 21, 1940 Scale 1" = 400'

STATE OF WEST VIRGINIA
DEPARTMENT OF MINES
OIL AND GAS DIVISION
CHARLESTON

WELL LOCATION MAP
FILE NO. HAR-626A

+ Denotes location of well on United States Topographic Maps, scale 1 to 62,500, latitude and longitude lines being represented by border lines as shown.

- Denotes one inch spaces on border line of original tracing.

Tennile District, Harrison County, W. Va.

By South Penn Natural Gas Co., Union Trust Bldg., Parkersburg, W. Va.

Abandoned under permit Har-626-A.

On 55 acres, on Colburn Fork of Tennile Creek.

Elevation, 1402.96' L.

Surface owned by Mary Barber, R. F. D. No. 2, Bristol, W. Va., and
minerals by Russell H. Perrine et al., Eastland, Texas.

Drilling commenced Sept. 6, 1899; completed, Oct. 29, 1899.

Shot Oct., 1899, with 24 qts.

Oil, 10 bbls., 1st 24 hrs.

10" casing, 580' (pulled); 8 $\frac{1}{2}$ " , 1177' (pulled); 6 $\frac{3}{8}$ " , 1951'.

Coal was encountered at 560-566'.

Oil well. Abandonment reported to Dept. of Mines April 7, 1941.

Record to RGT from Mrs. Griffith April 12, 1941. Old File No. 505.

	Top.	Bottom.
Pittsburgh Coal	560	- 566
Water sand	1830	- 1900
Big Injun Sand (gas, 2040')	2000	- 2060
Fifty-foot Sand	2467	- 2480
Stray Sand (gas, 2600')	2570	- 2655
Gordon Sand (gas, 2690')	2665	- 2700
Fifth Sand	2880	- 2886
Total depth		2909

STATE OF WEST VIRGINIA
DEPARTMENT OF MINES
OIL AND GAS DIVISION

505

WELL RECORD

Permit No. 676-A


Oil or Gas Well OIL
(KIND)

Company South Penn Natural Gas Company
Address Union Trust Bldg. Parkersburg, W. Va.
Farm W. C. Perrine Acres 55
Location (waters) Coburns Fork of Tenmile
Well No. 4 Elev. 1402.96'
District Ten Mile County Harrison
The surface of tract is owned in fee by Mary Barber
R. F. D. No. 2, Address Bristol, W. Va.
Mineral rights are owned by Russell H. Perrine et al
Address Eastland, Texas
Drilling commenced Sept. 6, 1899
Drilling completed Oct. 29, 1899
Date shot Oct. -- 1899-24 Depth of shot --
Open Flow /10ths Water in --- Inch
/10ths Merc. in --- Inch
Volume --- Cu. Ft.
Rock Pressure --- lbs --- hrs.
Oil 10 bbls., 1st 24 hrs.
Fresh water -- feet -- feet
Salt water -- feet -- feet

Casing and Tubing	Used in Drilling	Left in Well	Packers
Size			
16			Kind of Packer <u>--</u>
13			<u>--</u>
10	<u>580' (Pulled)</u>		Size of <u>--</u>
8 1/4	<u>1177' (Pulled)</u>		<u>--</u>
6 3/4	<u>1951'</u>		Depth set <u>--</u>
5 3/16			<u>--</u>
3			Perf. top <u>--</u>
2			Perf. bottom <u>--</u>
Liners Used			Perf. top <u>--</u>
			Perf. bottom <u>--</u>

CASING CEMENTED -- SIZE -- No. Ft. -- Date --
COAL WAS ENCOUNTERED AT 560 FEET 72 INCHES
-- FEET -- INCHES -- FEET -- INCHES
-- FEET -- INCHES -- FEET -- INCHES

Formation	Color	Hard or Soft	Top	Bottom	Oil, Gas or Water	Depth Found	Remarks
Pittsburgh Coal			560	566			
Water Sand			1830	1900			
Big Injun Sand			2000	2060			
Fifty Foot Sand			2467	2480	Gas	2040	
Stray Sand			2570	2555			
Gordon Sand			2665	2700	Gas	2600	
Fifth Sand			2880	2886	Gas	2690	
Total Depth				2909			

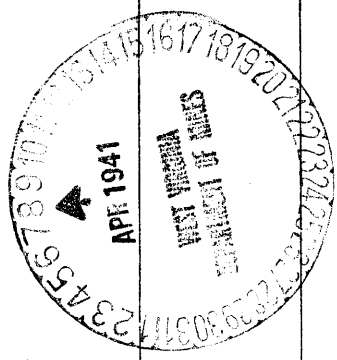

Formation	Color	Hard or Soft	Top	Bottom	Oil, Gas or Water	Depth Found	Remarks

Date April 7, 1941. ~~194~~

APPROVED SOUTH PENN NATURAL GAS COMPANY, Owner

By Eaton Egan Land Agent.
(Title)