


Latitude 39 + 15'

Longitude 80° 15'

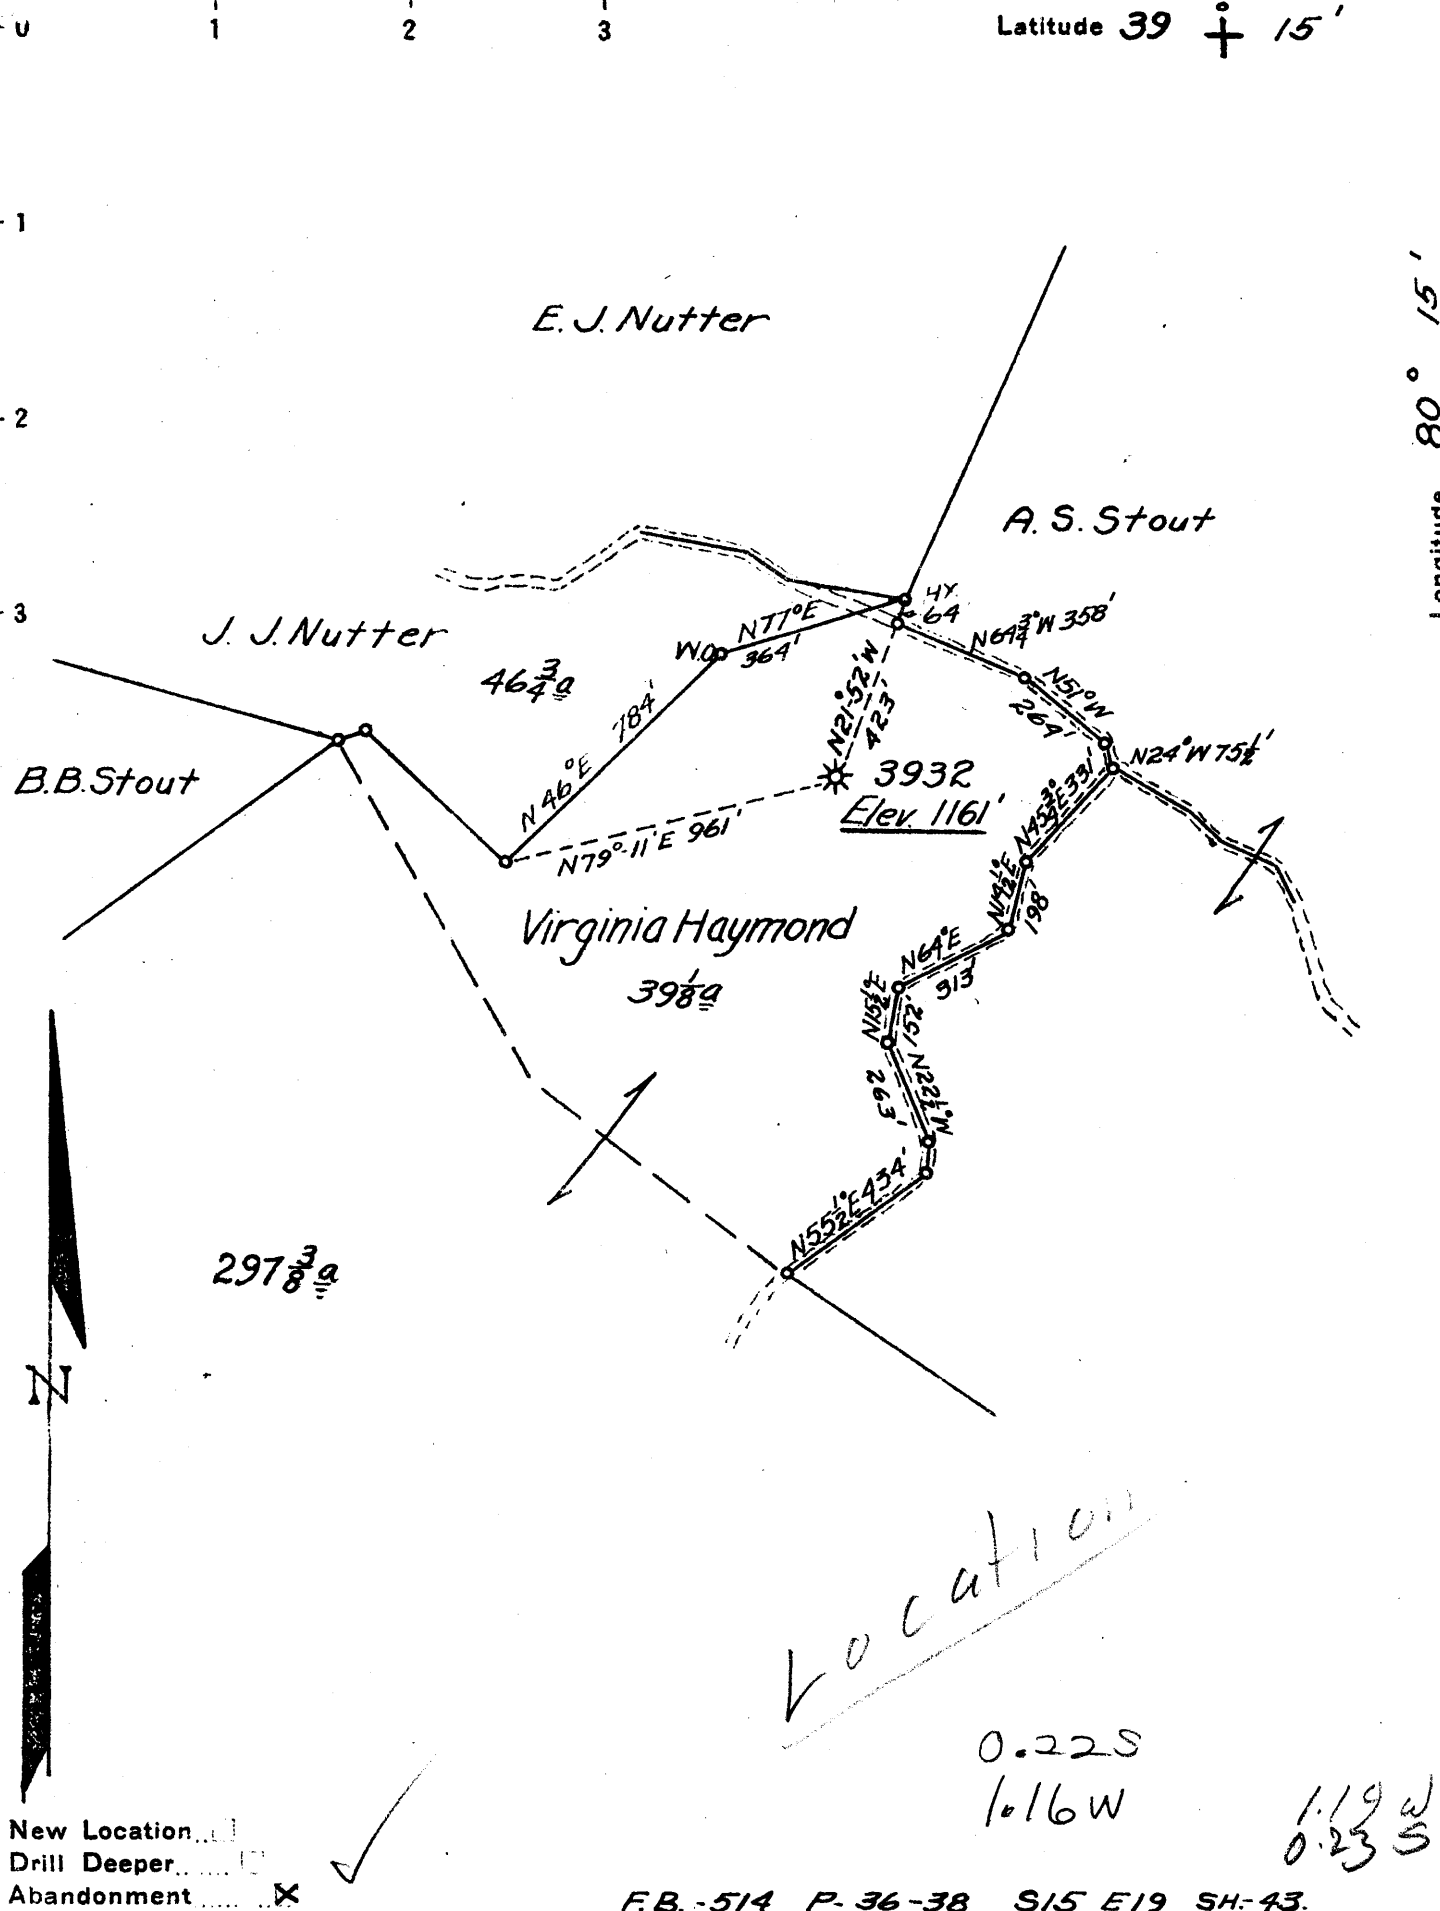

New Location

Drill Deeper

Abandonment

F.B. -514 P-36-38 S15 E19 SH-43.

Company HOPE NATURAL GAS CO.

Address CLARKSBURG, W.VA.

Farm VIRGINIA HAYMOND

Tract _____ Acres 600 Lease No. 26583

Well (Farm) No. 2 Serial No. 3932

Elevation (Spirit Level) 1161

Quadrangle WESTON

County HARRISON District CLARK

Engineer Wm Bowers

Engineer's Registration No. 900

File No. _____ Drawing No. _____

Date 5-6-41 Scale 1" = 500'

STATE OF WEST VIRGINIA
DEPARTMENT OF MINES
OIL AND GAS DIVISION
CHARLESTON

WELL LOCATION MAP
FILE NO. HAR-634A

+ Denotes location of well on United States Topographic Maps, scale 1 to 62,500, latitude and longitude lines being represented by border lines as shown.

- Denotes one inch spaces on border line of original tracing.

STATE OF WEST VIRGINIA
DEPARTMENT OF MINES
OIL AND GAS DIVISION

516

WELL RECORD

Ab
634-A
Permit No.


Oil or Gas Well Gas
(KIND)

Company Hope Natural Gas Company
 Address Clarksburg, W. Va.
 Farm Virginia Haymond Acres 600
 Location (waters) _____
 Well No. 3932 Elev. 1161
 District Clark County Harrison
 The surface of tract is owned in fee by Cletus Stout
 Address Bridgeport, W. Va.
 Mineral rights are owned by _____
 Address _____
 Drilling commenced 10-19-1915
 Drilling completed 12-3-1915
 Date shot 12-7-1915 Depth of shot 2292-2302
 Open Flow _____ /10ths Water in _____ Inch
 _____ /10ths Merc. in _____ Inch
 Volume _____ Cu. Ft.
 Rock Pressure _____ lbs. _____ hrs.
 Oil _____ bbls., 1st 24 hrs.
 Fresh water 95 feet _____ feet
 Salt water None recorded feet _____ feet

Casing and Tubing	Used in Drilling	Left in Well	Packers
Size			
16			Kind of Packer
13			
10	174	174	Size of
8 1/4	970	970	
6 3/8	1260	1260	Depth set
5 3/16	2085	2085	
3			Perf. top
2	2429	Pulled	Perf. bottom
Liners Used			Perf. top
			Perf. bottom

CASING CEMENTED _____ SIZE _____ No. Ft. _____ Date _____
Not cemented
 COAL WAS ENCOUNTERED AT _____ FEET _____ INCHES
 _____ FEET No coal INCHES _____ FEET _____ INCHES
 _____ FEET _____ INCHES _____ FEET _____ INCHES

Formation	Color	Hard or Soft	Top	Bottom	Oil, Gas or Water	Depth Found	Remarks
Little Dunkard Sand			265	297	Water	95	
Big Dunkard Sand			335	345			
Gas Sand			528	575	Show gas	528	
First Salt Sand			623	810			
Second Salt Sand			835	885			
Sand			925	960			
Sand			970	1170			
Big Lime			1250	1310			
Big Injun Sand			1310	1426	Gas	1331-1338	
Berea Sand			1520	1570			
Gantz Sand			1645	1670			
Fifty Foot Sand			1730	1810			
Thirty Foot Sand			1825	1965			
Gordon Stray Sand			2081	2095			
Gordon Sand			2098	2155			
Fourth Sand			2174	2212			
Fifth Sand			2274	2308	Gas	2299	
Total Depth				2429			

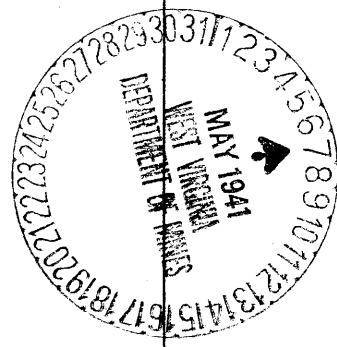

Formation	Color	Hard or Soft	Top	Bottom	Oil, Gas or Water	Depth Found	Remarks

Date May 6, 1941, 194

APPROVED Hope Natural Gas Company, Owner

By [Signature] General Supt.
(Title)

