


John Harbert

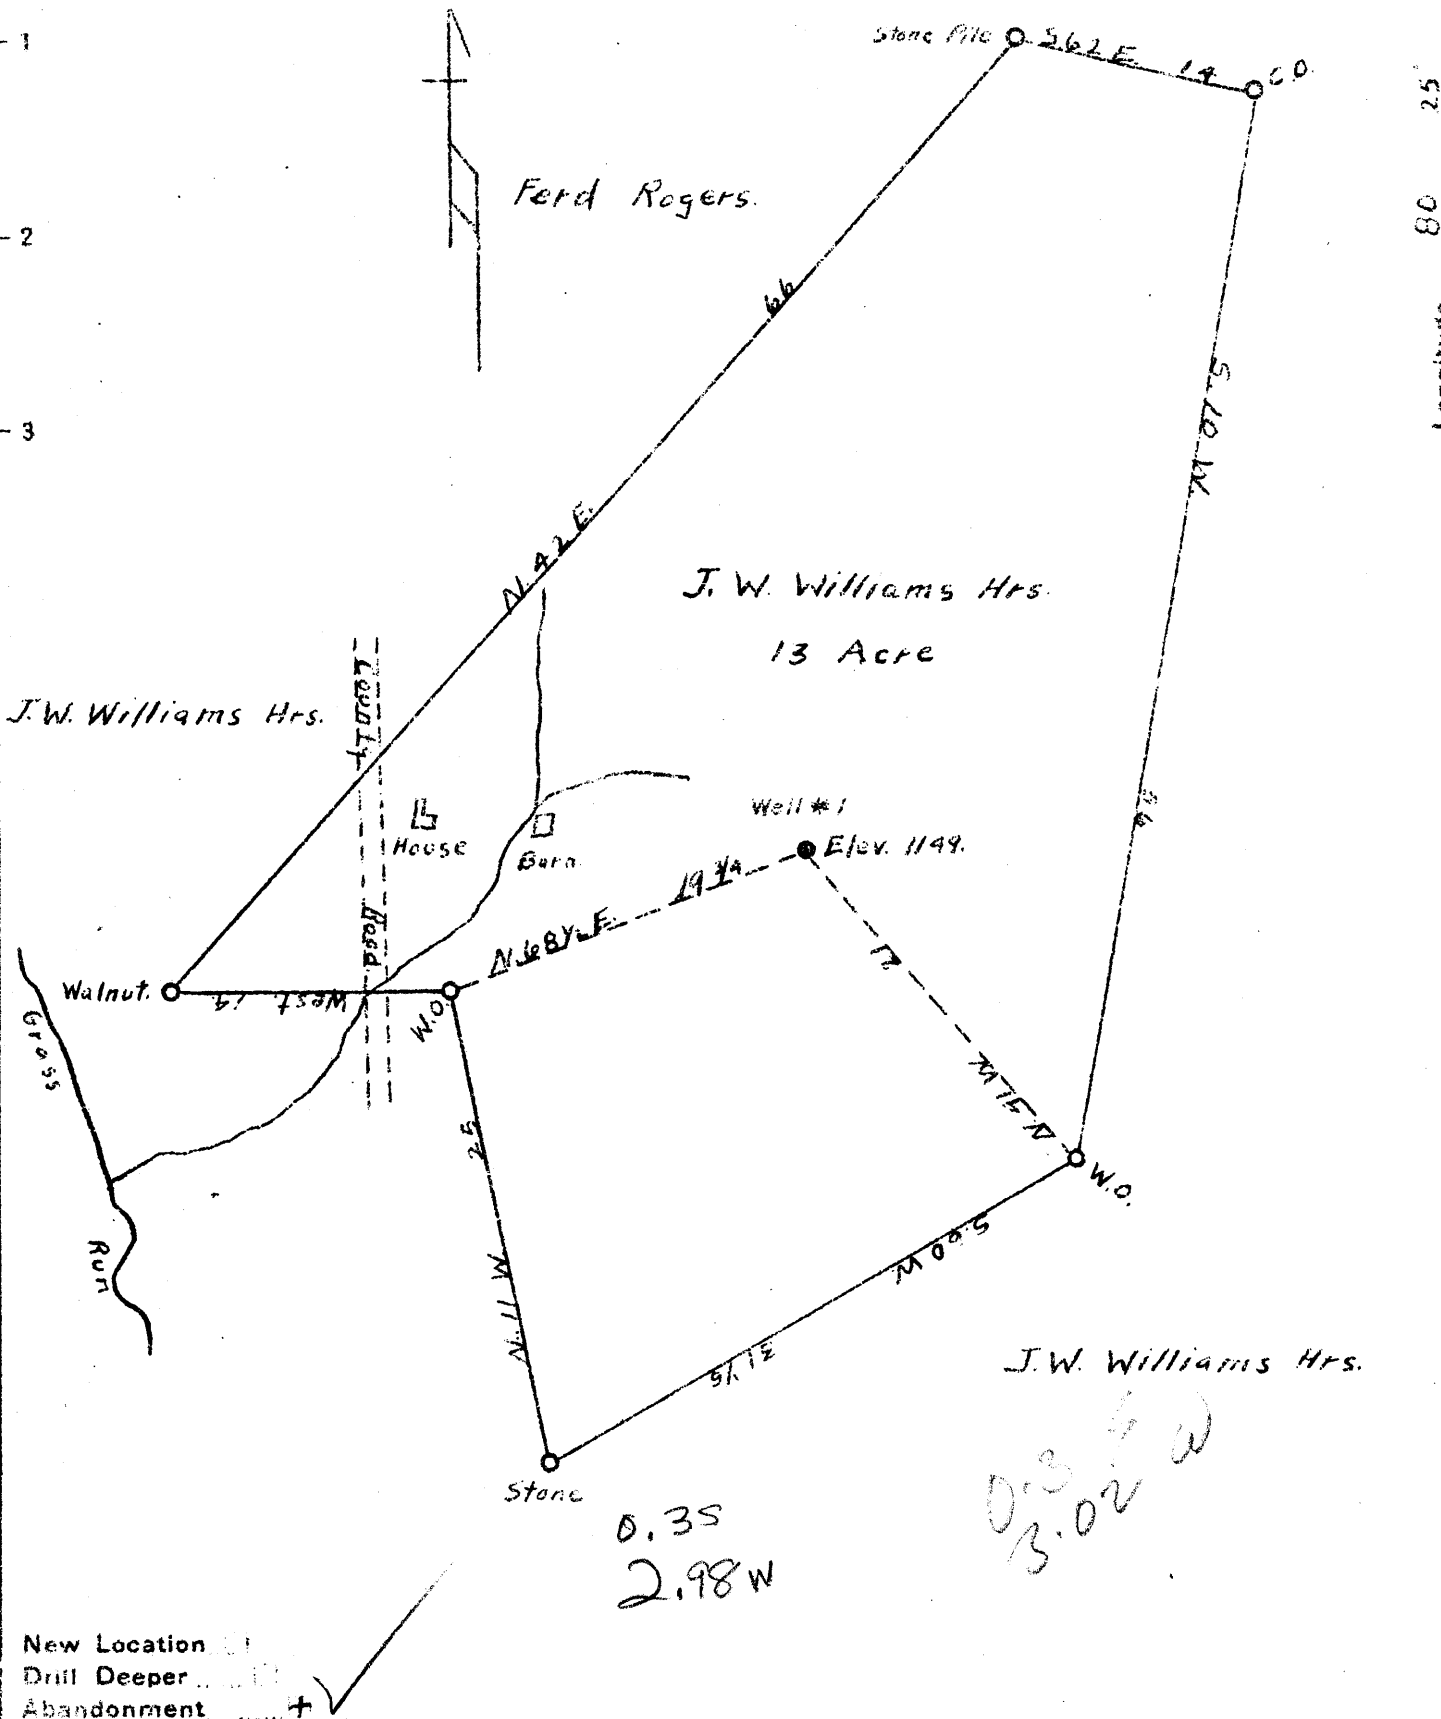

New Location

Drill Deeper

Abandonment

Company William Muses

Address 189 W. Main St. Salem, W. Va.

Farm J. W. Williams

Tract _____ Acres 13 Lease No. _____

Well (Farm) No. One Serial No. _____

Elevation (Spirit Level) 1149'

Quadrangle Clarksburg

County Harrison District Ten Mile

Engineer A. K. Westfall

Engineer's Registration No. Co. Surveyor, Ritchie Co.

File No. _____ Drawing No. _____

Date July 22 1891 Scale 1" = 10 Poles

STATE OF WEST VIRGINIA
DEPARTMENT OF MINES
OIL AND GAS DIVISION
CHARLESTON

WELL LOCATION MAP
FILE NO. HAR-666A

+ Denotes location of well on United States Topographic Maps, scale 1 to 62,500, latitude and longitude lines being represented by border lines as shown.

- Denotes one inch spaces on border line of original tracing.