

5.75S
0.33W

5.80S
0.33W

New Location
 Drill Deeper
 Abandonment

Company Hope Natural Gas Co.
 Address Clarksburg, W Va.
 Farm A. B. Coffindaffer
 Tract Acres 94 Lease No. 12566
 Well (Farm) No. 1 Serial No. 2056
 Elevation (Spirit Level) 1173
 Quadrangle Vadis
 County Harrison District Union
 Engineer Wm Bowers
 Engineer's Registration No. 900
 File No. _____ Drawing No. _____
 Date April 21, 1942 Scale 1" = 40'

STATE OF WEST VIRGINIA
 DEPARTMENT OF MINES
 OIL AND GAS DIVISION
 CHARLESTON

WELL LOCATION MAP
 FILE NO. HAR-729-A

+ Denotes location of well on United States Topographic Maps, scale 1 to 62,500, latitude and longitude lines being represented by border lines as shown.

- Denotes one inch spaces on border line of original tracing.

STATE OF WEST VIRGINIA
DEPARTMENT OF MINES
OIL AND GAS DIVISION

574

WELL RECORD

Gas

Permit No. 729-A

Oil or Gas Well.....
(KIND)

Company Hope Natural Gas Company
 Address Clarksburg, W. Va.
 Farm A. B. Coffindaffer Acres 94
 Location (waters).....
 Well No. 2056 Elev. 1173
 District Union County Harrison
 The surface of tract is owned in fee by.....
 Address.....
 Mineral rights are owned by.....
 Address.....
 Drilling commenced 12-22-1910
 Drilling completed 2-17-1911
 Date Shot 10-7-20 From..... To.....
 With 30 quarts in Fifth Sand.


Casing and Tubing	Used in Drilling	Left in Well	Packers
Size			Kind of Packer.....
16			
13			
10	<u>320</u>	<u>Pulled</u>	Size of.....
8 1/4	<u>1065</u>	<u>1065</u>	
6 5/8	<u>1865</u>	<u>1865</u>	Depth set.....
5 3/16	<u>2340</u>	<u>2340</u>	
3			Perf. top.....
2	<u>2522</u>	<u>Pulled</u>	Perf. bottom.....
Liners Used.....			Perf. top.....
			Perf. bottom.....

Open Flow /10ths Water in..... Inch
 /10ths Merc. in..... Inch
 Volume..... Cu. Ft.
 Rock Pressure..... lbs..... hrs.
 Oil..... bbls., 1st 24 hrs.
 Fresh water..... feet..... feet
 Salt water..... feet..... feet

CASING CEMENTED..... SIZE..... No. Ft..... Date
Not cemented
 COAL WAS ENCOUNTERED AT 260 FEET 24 INCHES
 FEET..... INCHES..... FEET..... INCHES
 FEET..... INCHES..... FEET..... INCHES

Formation	Color	Hard or Soft	Top	Bottom	Oil, Gas or Water	Depth Found	Remarks
Pittsburgh Coal			260	262			
Big Dunkard Sand			780	830			
Gas Sand			950	1050			
First Salt Sand			1060	1120			
Second Salt Sand			1120	1350			
Maxon Sand			1470	1460	Gas	1475	
Little Lime			1700	1730			
Pencil Cave			1730	1733			
Big Lime			1733	1840			
Big Injun Sand			1840	1930			
Beros Sand			2035	2050			
Gantz Sand			2152	2177			
Thirty Foot Sand			2278	2295	Gas	2280-2282	
Gordon Stray Sand			2300	2325			
Gordon Sand			2340	2370	Gas	2340-2345	
Fourth Sand			2378	2420			
Fifth Sand			2563	2578			

Original total depth..... 2601
 Filled and plugged to present total depth..... 2362.

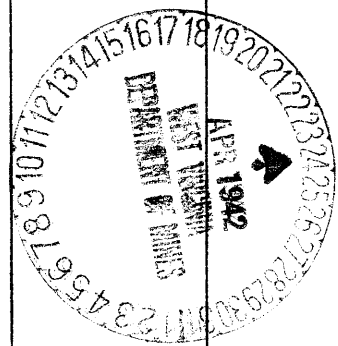

Formation	Color	Hard or Soft	Top	Bottom	Oil, Gas or Water	Depth Found	Remarks


Date **April 21, 1942**

_____, 194

Hope Natural Gas Company

APPROVED _____, Owner

General Supt.

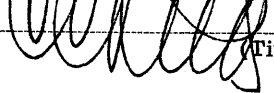By  (Title)