

New Location   
 Drill Deeper   
 Abandonment

Map Sheet 43 Square S15E14 F.B. 510 P.6-9

Company HOPE NATURAL GAS CO.  
 Address CLARKSBURG, W.VA.  
 Farm UPTON SIDEBOTTOM  
 Tract \_\_\_\_\_ Acres 25 1/2 Lease No. 44560  
 Well (Farm) No. 1 Serial No. 7356  
 Elevation (Spirit Level) 1094  
 Quadrangle WESTON  
 County HARRISON District CLARK  
 Engineer Wm Bowers  
 Engineer's Registration No. 900  
 File No. \_\_\_\_\_ Drawing No. \_\_\_\_\_  
 Date Apr. 9, 1943 Scale 1"=300'

STATE OF WEST VIRGINIA  
 DEPARTMENT OF MINES  
 OIL AND GAS DIVISION  
 CHARLESTON  
**WELL LOCATION MAP**  
 FILE NO. H.A.R.-769-A  
 + Denotes location of well on United States Topographic Maps, scale 1 to 62,500, latitude and longitude lines being represented by border lines as shown.  
 - Denotes one inch spaces on border line of original tracing.

STATE OF WEST VIRGINIA  
DEPARTMENT OF MINES  
OIL AND GAS DIVISION

623

WELL RECORD

Permit No. 769 A

~~Oil~~ or Gas Well  
(KIND)


Company Hops Natural Gas Company  
Address 445 West Main St. Clarksburg, W. Va.  
Farm Upton Sidebottom Acres 25 1/2  
Location (waters) (V)  
Well No. 7356 Elev. 1094  
District Clark County Harrison  
The surface of tract is owned in fee by \_\_\_\_\_  
Address \_\_\_\_\_  
Mineral rights are owned by \_\_\_\_\_  
Address \_\_\_\_\_  
Drilling commenced Nov. 7, 1918 Purchased well  
Drilling completed Dec. 31, 1918  
Date Shot \_\_\_\_\_ From \_\_\_\_\_ To \_\_\_\_\_  
With \_\_\_\_\_  
Open Flow \_\_\_\_\_ /10ths Water in \_\_\_\_\_ Inch  
\_\_\_\_\_ /10ths Merc. in \_\_\_\_\_ Inch  
Volume \_\_\_\_\_ Cu. Ft.  
Rock Pressure \_\_\_\_\_ lbs. \_\_\_\_\_ hrs.  
Oil \_\_\_\_\_ bbls., 1st 24 hrs.  
Fresh water none recorded feet \_\_\_\_\_ feet  
Salt water none recorded feet \_\_\_\_\_ feet

Casing and Tubing	Used in Drilling	Left in Well	Packers
Size			Kind of Packer
16			
13			
10			Size of
8 1/4	896	896	
6 5/8	1423	1423	Depth set
5 3/16	2419	pulled	
3 5/16"	1500	1500	Perf. top
2	3100	Pulled	Perf. bottom
Liners Used			Perf. top
			Perf. bottom

**Not cemented**  
CASING CEMENTED \_\_\_\_\_ SIZE \_\_\_\_\_ No. Ft. \_\_\_\_\_ Date \_\_\_\_\_

**None recorded**  
COAL WAS ENCOUNTERED AT \_\_\_\_\_ FEET \_\_\_\_\_ INCHES  
\_\_\_\_\_ FEET \_\_\_\_\_ INCHES \_\_\_\_\_ FEET \_\_\_\_\_ INCHES  
\_\_\_\_\_ FEET \_\_\_\_\_ INCHES \_\_\_\_\_ FEET \_\_\_\_\_ INCHES

Formation	Color	Hard or Soft	Top	Bottom	Oil, Gas or Water	Depth Found	Remarks
Little Dunkard			325	350			
Big Dunkard			440	490			
First Salt sand			690	835			
Second Salt			870	990			
Maxon sand			1310	1340			
Big Lime			1395	1457			
Big Injun			1457	1575			
Gantz sand			1865	1880			
Fifty Foot			1885	1950	gas	1890	
Thirty Foot			1960	2070			
Stray			2105				
Fourth sand			2300	2318			
Fifth sand			2376	2404	Gas	2378-2391	
Speechley sand			3069	3082	Gas	3071- 3080	
Total depth				3100			

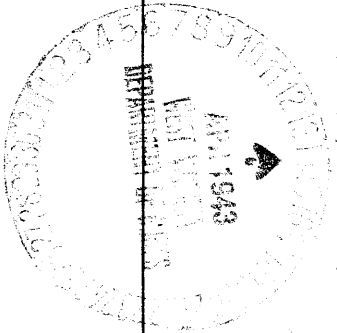

Formation	Color	Hard or Soft	Top	Bottom	Oil, Gas or Water	Depth Found	Remarks

Date April 9, 1943, 194

APPROVED Hope Natural Gas Company., Owner

By  (Title) Gen. Sup't.