

New Location
 Drill Deeper
 Abandonment

0.20S
 3.70W

Map Sheet 58 Square S20E3.F.B.541R2

Company HOPE NATURAL GAS CO.
 Address CLARKSBURG, W.VA.
 Farm J. B. COFFINDAFFER
 Tract _____ Acres 300 Lease No 9827
 Well (Farm) No. _____ Serial No. 945
 Elevation (Spirit Level) 1131
 Quadrangle VADIS
 County HARRISON District UNION
 Engineer W.M. Powers
 Engineer's Registration No. 900
 File No. _____ Drawing No. _____
 Date NOV. 26, 1943 Scale 1" = 40F

STATE OF WEST VIRGINIA
 DEPARTMENT OF MINES
 OIL AND GAS DIVISION
 CHARLESTON

WELL LOCATION MAP
 FILE NO. HAR-792-A

+ Denotes location of well on United States Topographic Maps, scale 1 to 62,500, latitude and longitude lines being represented by border lines as shown.

- Denotes one inch spaces on border line of original tracing.



STATE OF WEST VIRGINIA
DEPARTMENT OF MINES
OIL AND GAS DIVISION

633

Ab 792-A
Permit No. _____

WELL RECORD

Oil or Gas Well
(KIND)


Company Hope Natural Gas Company
Address 445 West Main St. Clarksburg, W.Va.
Farm J.B. Coffindaffer Acres 300
Location (waters) _____
Well No. 945 Eley 1151
District Union County Harrison
The surface of tract is owned in fee by _____
Address _____
Mineral rights are owned by _____
Address _____
Drilling commenced Jan. 3, 1907
Drilling completed Mar. 16, 1907
Date Shot _____ From _____ To _____
With _____
Open Flow _____ /10ths Water in _____ Inch
_____ /10ths Merc. in _____ Inch
Volume _____ Cu. Ft.
Rock Pressure _____ lbs. _____ hrs.
Oil _____ bbls., 1st 24 hrs.
Fresh water none recorded feet _____ feet
Salt water 1372 feet _____ feet

Casing and Tubing	Used in Drilling	Left in Well	Packers
Size			
16			Kind of Packer
18			
10	243	243	Size of
8 1/2	685	685	
6 1/2	1508	1508	Depth set
5 3/16	2622	2622	
3			Perf. top
2	2857	Pulled	Perf. bottom
Liners Used			Perf. top
			Perf. bottom

Not cemented

CASING CEMENTED _____ SIZE _____ No. Ft. _____ Date _____
_____ 551 72
COAL WAS ENCOUNTERED AT _____ FEET _____ INCHES
_____ FEET _____ INCHES FEET _____ INCHES
_____ FEET _____ INCHES FEET _____ INCHES

Formation	Color	Hard or Soft	Top	Bottom	Oil, Gas or Water	Depth Found	Remarks
Pittsburgh Coal			551	557			
Big Dunkard			1065	1125			
Gas Sand			1280	1325			
First Salt			1395	1720	water	1372	
Maxon			1835	1857			
Little Lime			1940	1955			
Pencil cave			1958	1965			
Big Lime			1965	2015			
Big Injun			2015	2164			
Gantz			2360	2374			
Fifty foot			2435	2457			
Thirty foot			2533	2555			
Gordon stray			2580	2612			
Gordon sand			2624	2664			
Fourth			2672	2682			
Fifth sand			2845	2852	gas	2845	
Total depth				2857			

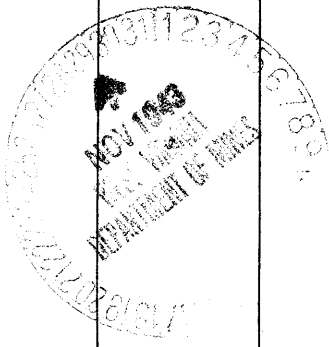

MAR 30 1944

Formation	Color	Hard or Soft	Top	Bottom	Oil, Gas or Water	Depth Found	Remarks

Date November 24, 1943, 194

APPROVED Hops Natural Gas Company, Owner

By [Signature] Gen. Sup't.
(Title)