

5.46S
2.07W

New Location
 Drill Deeper
 Abandonment

Map Sheet 44 Square 99 E 13 F B 515 P 22 & 24

Company HOPE NATURAL GAS CO.
 Address CLARKSBURG, W.VA.
 Farm ROSE ALLEN
 Tract _____ Acres 150 Lease No. 4336
 Well (Farm) No. _____ Serial No. 1195
 Elevation (Spirit Level) 1056
 Quadrange CLARKSBURG
 County HARRISON District EAGLE
 Engineer Wm Bowers
 Engineer's Registration No. 900
 File No. _____ Drawing No. _____
 Date DEC. 29 1943 Scale 1" = 500'

STATE OF WEST VIRGINIA
 DEPARTMENT OF MINES
 OIL AND GAS DIVISION
 CHARLESTON

WELL LOCATION MAP
 FILE NO. HAR-796-A

+ Denotes location of well on United States Topographic Maps, scale 1 to 62,500. latitude and longitude lines being represented by border lines as shown.

- Denotes one inch spaces on border line of original tracing.



631

STATE OF WEST VIRGINIA
DEPARTMENT OF MINES
OIL AND GAS DIVISION

AD 796A
Permit No. 796A

WELL RECORD


Oil or Gas Well (KIND)

Company Hope Natural Gas Company.
Address 445 West Main St. Clarksburg, W. Va.
Farm Rosa Allen Acres 32
Location (waters) _____
Well No. 1196 Elev. 1056
District Eagle County Harrison
The surface of tract is owned in fee by _____
Address _____
Mineral rights are owned by _____
Address _____
Drilling commenced March 22, 1909
Drilling completed April 29, 1909
Date Shot _____ From _____ To _____
With _____
Open Flow _____ /10ths Water in _____ Inch
_____ /10ths Merc. in _____ Inch
Volume _____ Cu. Ft.
Rock Pressure _____ lbs. _____ hrs.
Oil _____ bbls., 1st 24 hrs.
Fresh water none recorded feet _____ feet
Salt water 980 feet _____ feet

Casing and Tubing	Used in Drilling	Left in Well	Packers
Size			
16			Kind of Packer
18			
10	168	Pulled	Size of
8 1/2	980	Pulled	
6 1/2	1443	1443	Depth set
5 3/16	2173	2173	
3			Perf. top
2			Perf. bottom
Liners Used	3125	Pulled	Perf. top
			Perf. bottom

Not cemented
CASING CEMENTED _____ SIZE _____ No. Ft. _____ Date _____
25' Below Pitts. Coal
COAL WAS ENCOUNTERED AT _____ FEET _____ INCHES
_____ FEET _____ INCHES _____ FEET _____ INCHES
_____ FEET _____ INCHES _____ FEET _____ INCHES

Formation	Color	Hard or Soft	Top	Bottom	Oil, Gas or Water	Depth Found	Remarks
Little Dunkard			370	490			
Big Dunkard			495	505			
Gas sand			700	767			
First Salt			782	825			
Second Salt			840	1011	water	980	
Little Lime			1332	1344			
Pencil cave			1344	1348			
Big Lime			1348	1410			
Big Injun			1410	1480			
Cantz			1780	1780			
Fifty Foot			1930	1978	gas	1940	
Thirty Foot			1982	2058			
Stray			2155	2185			
Gordon			2213	2255	gas	2216-2218	
Fourth			2256	2275	show oil	2260-2265	
Fifth			2375	2392	gas	2377-2387	
Speachley			3066	3072	gas	3067	
Total depth				3104			

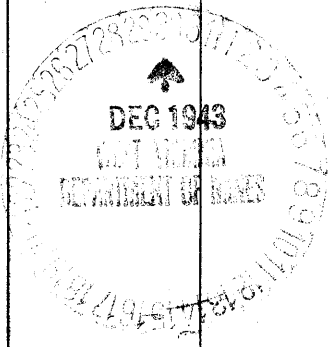

[Handwritten signature]

Formation	Color	Hard or Soft	Top	Bottom	Oil, Gas or Water	Depth Found	Remarks

Date December 27, 1943., 194

APPROVED Hope Natural Gas Company., Owner

By [Signature] Gen. Sup't.
(Title)