


WELL 8021 Latitude 39 15' WELL 8019 WELL 8020

0.29S 0.20S
1.36W 1.18W

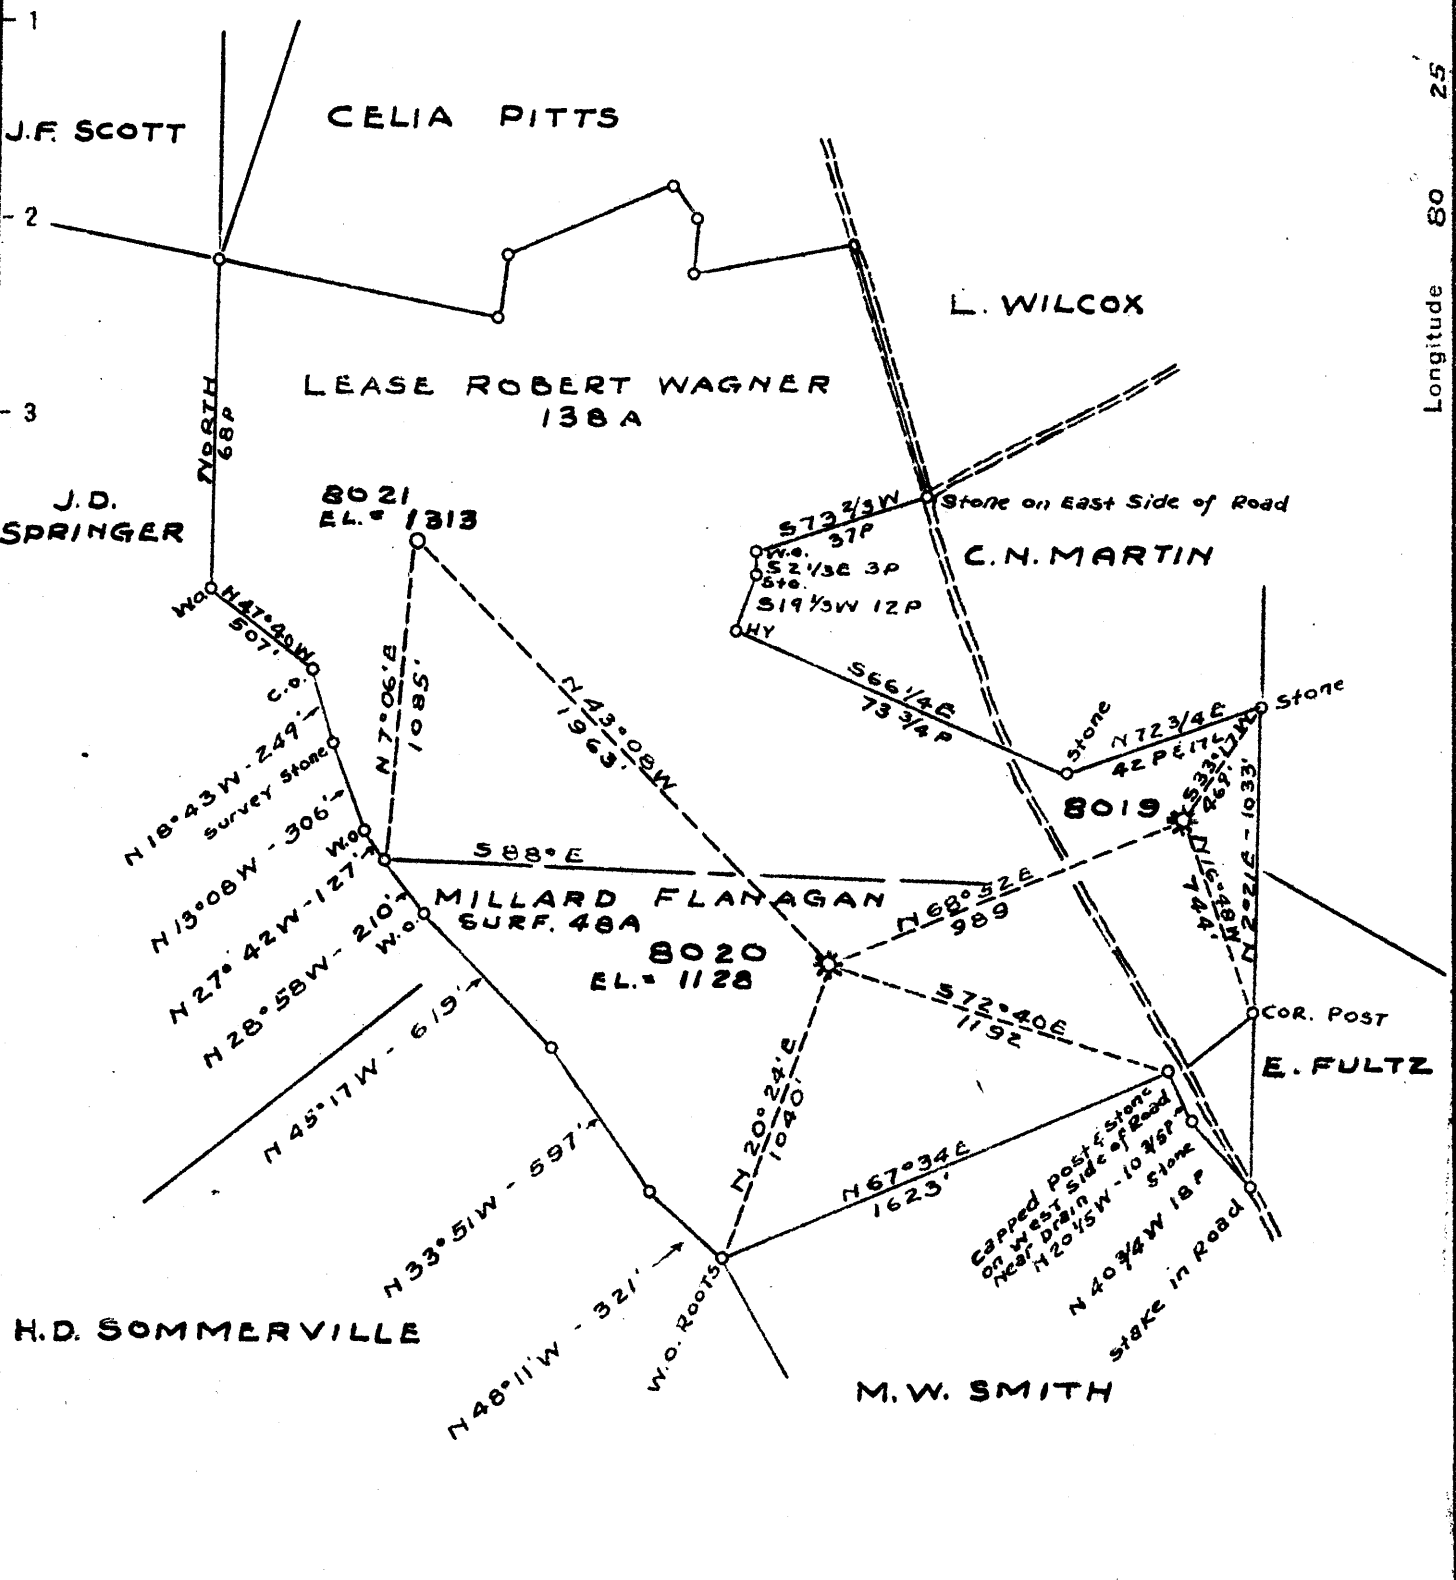

New Location
Drill Deeper
Abandonment **X - 8020**

MAP # 55-51549 - F.B. # 714 P 25, 35, 38 - F.B. 604 P 27-28

Company HOPE NATURAL GAS CO.
 Address CLARKSBURG, W.VA.
 Farm ROBERT WAGNER
 Tract 1 Acres 138 Lease No. 38
 Well (Farm) No. 2 Serial No. 8020
 Elevation (Spirit Level) 1128
 Quadrangle WESTON
 County HARRISON District UNION
 Engineer W.M. Bowen
 Engineer's Registration No. 900
 File No. _____ Drawing No. _____
 Date MAY 5, 1944 Scale 1" = 40 POLES

STATE OF WEST VIRGINIA
 DEPARTMENT OF MINES
 OIL AND GAS DIVISION
 CHARLESTON

WELL LOCATION MAP
 FILE NO. HARP-803-A

+ Denotes location of well on United States Topographic Maps. scale 1 to 62,500, latitude and longitude lines being represented by border lines as shown.

- Denotes one inch spaces on border line of original tracing.