


6
1
2
3

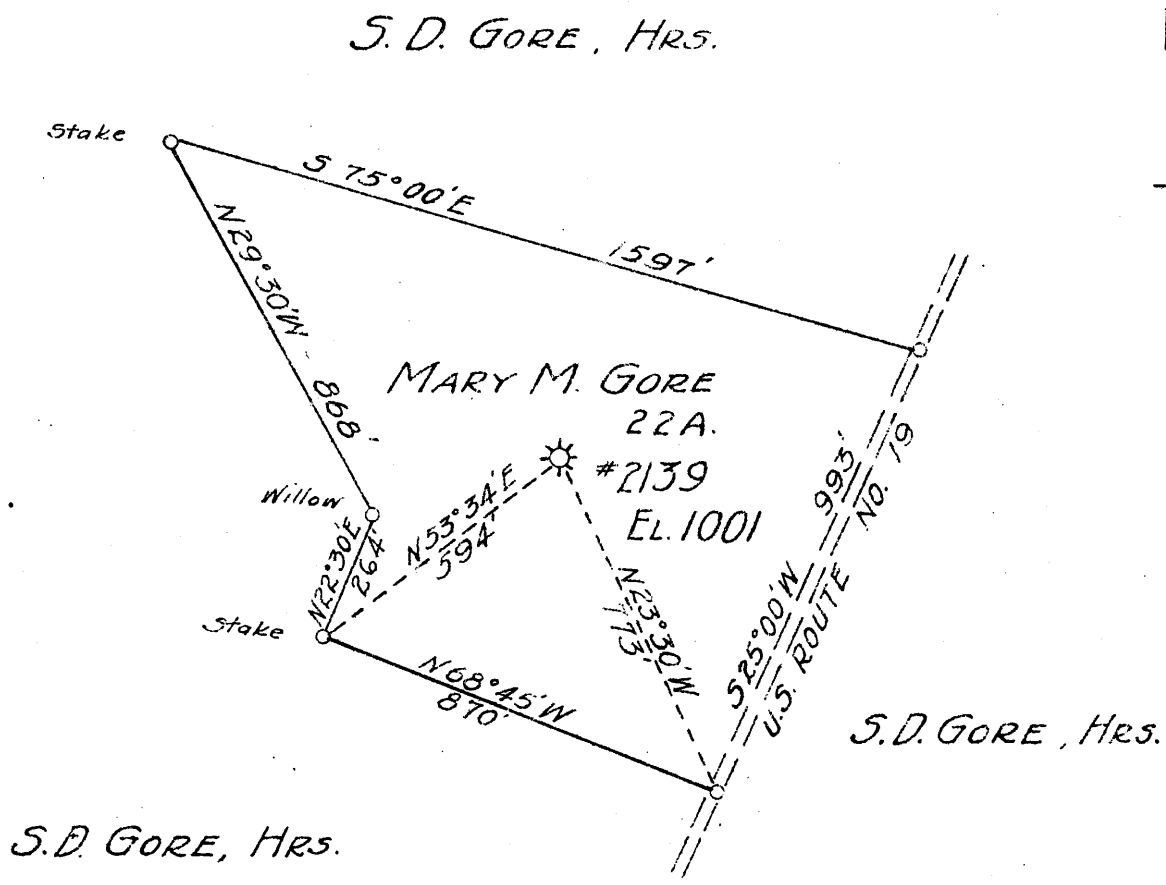

1.58S
1.32W

New Location
 Drill Deeper
 Abandonment

MAP SHEET 44 Sq. 5-10 E-14 N.B.511 P.12,18

Company HOPE NATURAL GAS CO.
 Address CLARKSBURG W.VA.
 Farm MARY M. GORE
 Tract _____ Acres 22 Lease No. 6035
 Well (Farm) No. _____ Serial No. 2139
 Elevation (Spirit Level) 1001'
 Quadrangle CLARKSBURG
 County HARRISON District COAL
 Engineer Wm Cowens
 Engineer's Registration No. 900
 File No. _____ Drawing No. _____
 Date 5-9-44 Scale 1" = 400'

STATE OF WEST VIRGINIA
 DEPARTMENT OF MINES
 OIL AND GAS DIVISION
 CHARLESTON

WELL LOCATION MAP
 FILE NO. HAR-805-A

+ Denotes location of well on United States Topographic Maps, scale 1 to 62,500, latitude and longitude lines being represented by border lines as shown.
 - Denotes one inch spaces on border line of original tracing.



STATE OF WEST VIRGINIA
DEPARTMENT OF MINES
OIL AND GAS DIVISION

640

WELL RECORD

Permit No. 805-A


Gas Well
(KIND)

Company Hape Natural Gas Company.
Address 445 West Main St. Clarksburg, W. Va.
Farm Mary M. Gore Acres 22
Location (waters) _____
Well No. 2139 Elev. 1001
District Coal County Harrison
The surface of tract is owned in fee by _____
Address _____
Mineral rights are owned by _____
Address _____
Drilling commenced February 20, 1911
Drilling completed May 1, 1911
Date Shot _____ From _____ To _____
With _____
Open Flow _____ /10ths Water in _____ Inch
_____ /10ths Merc. in _____ Inch
Volume _____ Cu. Ft.
Rock Pressure _____ lbs. _____ hrs.
Oil _____ bbls., 1st 24 hrs.
Fresh water 25 feet _____ feet
Salt water 810 feet _____ feet

Casing and Tubing	Used in Drilling	Left in Well	Packers
Size			
16			Kind of Packer
13			
10	208	Pulled	Size of
8 1/4	960	787	
6 3/4	1374	1374	Depth set
5 3/16	2062	2062	
3			Perf. top
2			Perf. bottom
Liners Used			Perf. top
			Perf. bottom

CASING CEMENTED _____ SIZE _____ No. Ft. _____ Date _____
COAL WAS ENCOUNTERED AT _____ FEET _____ INCHES
_____ FEET _____ INCHES _____ FEET _____ INCHES
_____ FEET _____ INCHES _____ FEET _____ INCHES

Formation	Color	Hard or Soft	Top	Bottom	Oil, Gas or Water	Depth Found	Remarks
Little Dunkard			375	450	water	25	
Big Dunkard			480	525			
Gas sand			620	670			
First Salt			690		water	810	
Second Salt				950			
Maxon			1220	1295	gas	1228	
Pencil cave			1295	1298			
Big Lime			1298	1360			
Big Injun			1360	1466			
Squaw			1505	1515			
Gantz			1807	1847			
Fifty foot			1860	1921	gas	1890	
Thirty Foot			1925	1998			
Thirty foot			1945	1998			
Gordon stray			2040	2065			
Gordon			2070	2084			
Fourth			2144	2161			
Fifth			2335	2347	gas	2338	
Speechley			3013	3020	gas	3015	
Total depth				3050			

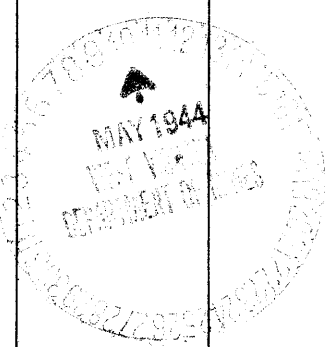

(Handwritten signatures and initials)

Formation	Color	Hard or Soft	Top	Bottom	Oil, Gas or Water	Depth Found	Remarks

Date May 9, 1944., 194

APPROVED Hope Natural Gas Company, Owner

By [Signature] Gen. Sup't.
(Title)