

LATITUDE

39° 10' 00"

80° 30' 00"

LONGITUDE

7'5 OGIS topo location

7.5' loc	<u>.245</u>	15' loc	_____
	<u>1.1640</u>	(calc.)	_____

Company _____

Farm _____


Quad Big Isaac

County Har

District Union

WELL LOCATION MAP

File No. 826A Har

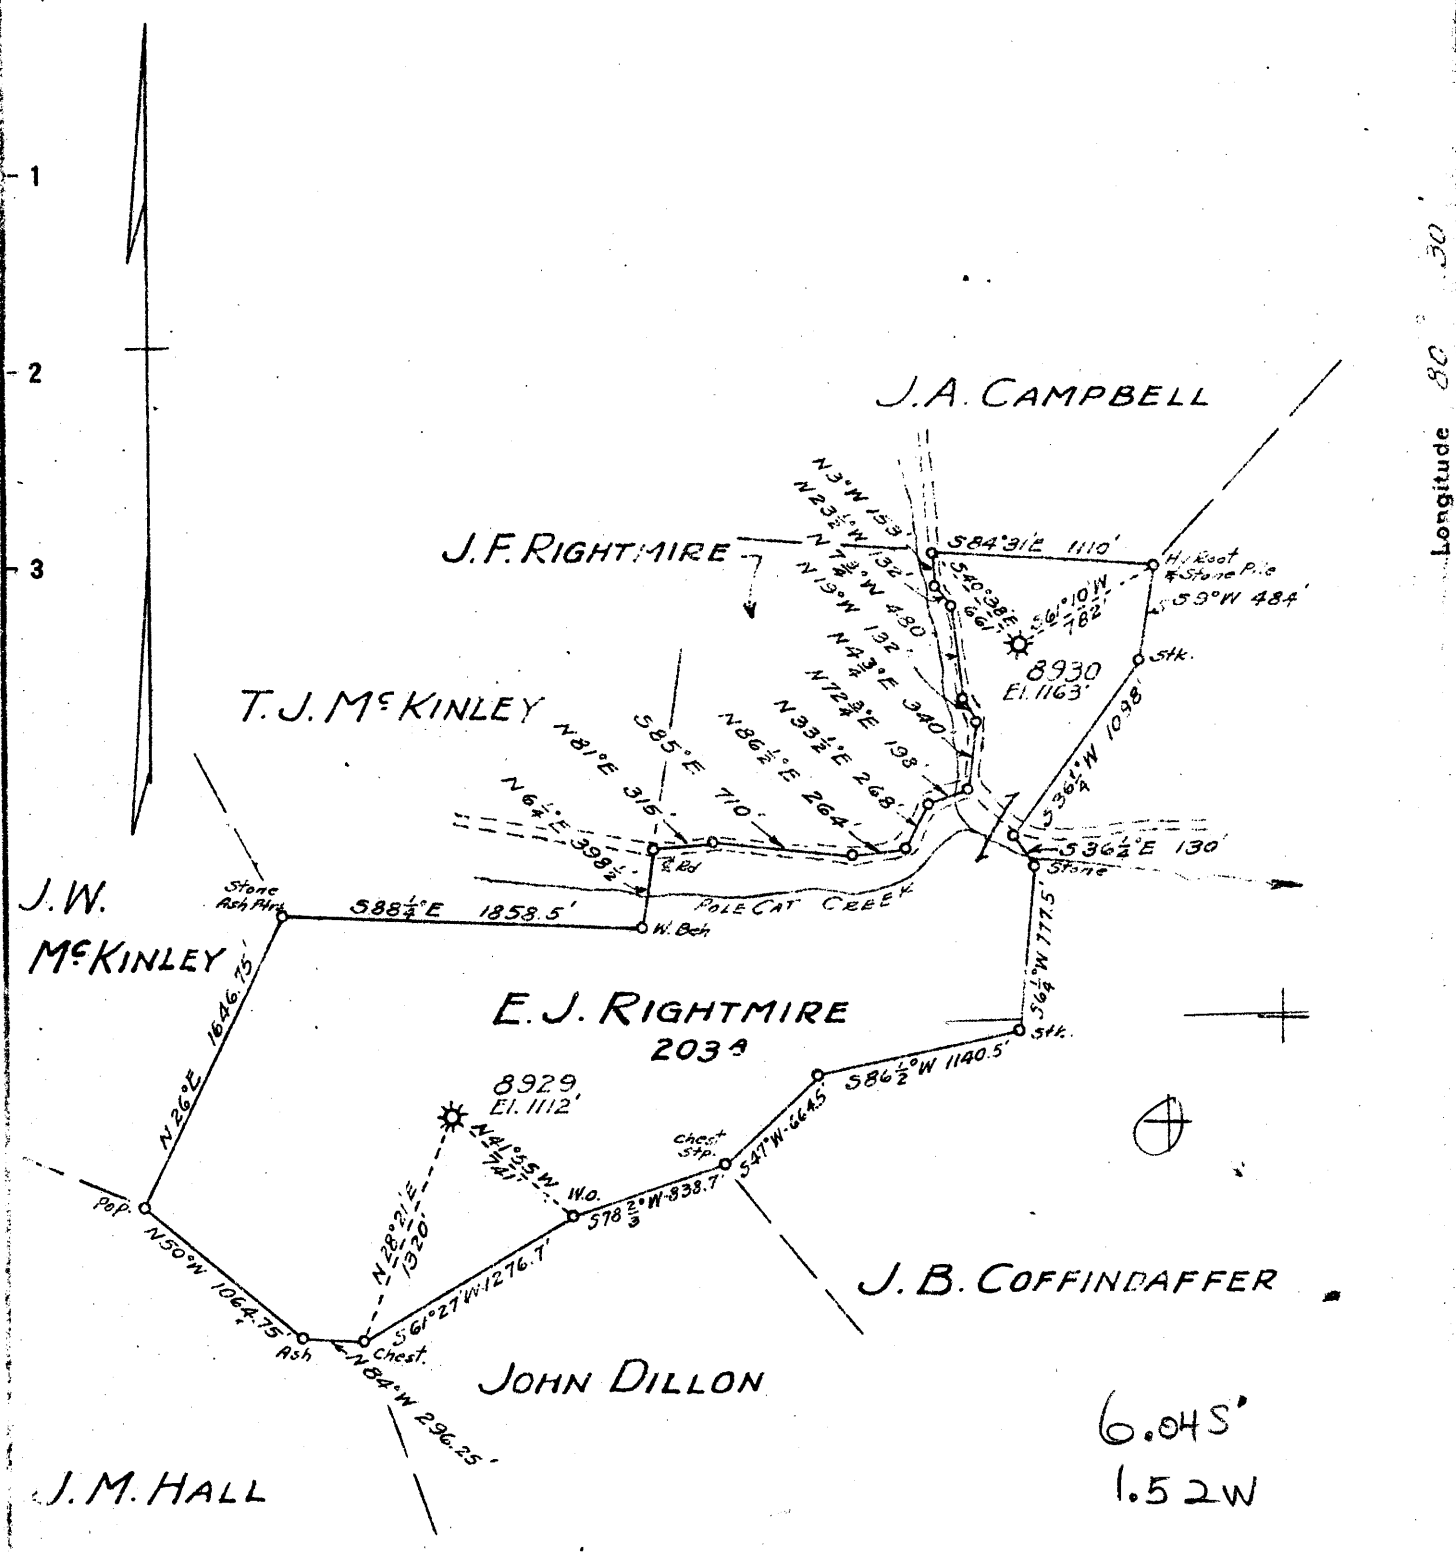

New Location...
 ... Deeper...
 Abandonment 8929

MAP SHEET 58 SQ. 5-20 E-5 FB. 765 P. 8

Company HOPE NATURAL GAS CO.
 Address CLARKSBURG W. VA.
 Farm E. J. RIGHTMIRE
 Tract _____ Acres 203 Lease No. 56563
 Well (Farm) No. _____ Serial No. AS SHOWN
 Elevation (Spirit Level) AS SHOWN
 Quadrangle VADIS
 County HARRISON District UNION
 Engineer W. M. Powers
 Engineer's Registration No. 900
 File No. _____ Drawing No. _____
 Date 9-19-44 Scale 1" = 1000'

STATE OF WEST VIRGINIA
 DEPARTMENT OF MINES
 OIL AND GAS DIVISION
 CHARLESTON

WELL LOCATION MAP
 FILE NO. HAR-826-A

+ Denotes location of well on United States Topographic Maps, scale 1 to 62,500, latitude and longitude lines being represented by border lines as shown.
 - Denotes one inch spaces on border line of original tracing



STATE OF WEST VIRGINIA
DEPARTMENT OF MINES
OIL AND GAS DIVISION

682

WELL RECORD

Permit No. Ab 876 A


Oil or Gas Well (KIND)

Company Hope Natural Gas Company
 Address 445 West Main St. Clarksburg, W.Va.
 Farm E.J. Rightmire Acres 66
 Location (waters) _____
 Well No. 8929 Elev. 1112
 District Union County Harrison
 The surface of tract is owned in fee by _____
 Address _____
 Mineral rights are owned by _____
 Address _____
 Drilling commenced Purchased - , no records
 Drilling completed _____
 Date Shot _____ From _____ To _____
 With _____
 Open Flow _____ /10ths Water in _____ Inch
 _____ /10ths Merc. in _____ Inch
 Volume _____ Cu. Ft.
 Rock Pressure _____ lbs. _____ hrs.
 Oil _____ bbls., 1st 24 hrs.
 Fresh water _____ feet _____ feet
 Salt water _____ feet _____ feet

Casing and Tubing	Used in Drilling	Left in Well	Packers
Size			
16			Kind of Packer
13			
10	315	315	Size of
8 1/4	1220	1220	
6 5/8	1805	1805	Depth set
5 3/16			
3			Perf. top
2			Perf. bottom
Liners Used			Perf. top
			Perf. bottom

Not cemented
 CASING CEMENTED _____ SIZE _____ No. Ft. _____ Date _____
No record
 COAL WAS ENCOUNTERED AT _____ FEET _____ INCHES
 _____ FEET _____ INCHES FEET _____ INCHES
 _____ FEET _____ INCHES FEET _____ INCHES

Formation	Color	Hard or Soft	Top	Bottom	Oil, Gas or Water	Depth Found	Remarks
	Gordon sand		2405	2445	?		
	Fifth		2603	2608	?		
	Total depth			2608			

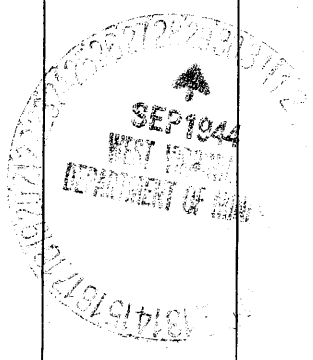

Formation	Color	Hard or Soft	Top	Bottom	Oil, Gas or Water	Depth Found	Remarks

Date September 28, 1944, 194

APPROVED Hope Natural Gas Company, Owner

By [Signature] Ass't. to Gen. Sup't.

