

5.0S
 ~ 0.53W

New Location
 Drill Deeper
 Abandonment X

Map Sh. 56 Sq. 5-19 E-10 F.B. 766 P. 34 & 35

Company Hope Natural Gas Co.
 Address Clarksburg, W. Va.
 Farm Rebecca Vanscoy
 Tract _____ Acres 11 Lease No. 52809
 Well (Farm) No. _____ Serial No. 8001
 Elevation (Spirit Level) 975'
 Quadrangle Weston
 County Harrison District Grant
 Engineer W.M. Bowen
 Engineer's Registration No. 900
 File No. _____ Drawing No. _____
 Date 3-16-45 Scale 1" = 400'

STATE OF WEST VIRGINIA
 DEPARTMENT OF MINES
 OIL AND GAS DIVISION
 CHARLESTON

WELL LOCATION MAP
 FILE NO. HAR-849-A

+ Denotes location of well on United States Topographic Maps, scale 1 to 62,500. Latitude and longitude lines being represented by border lines as shown.

- Denotes one inch spaces on border line of original tracing.



STATE OF WEST VIRGINIA
DEPARTMENT OF MINES
OIL AND GAS DIVISION

692

WELL RECORD

Permit No. 849-A



Oil Gas Well (KIND)

Company Hope Natural Gas Company.
 Address 445 West Main St. Clarksburg, W. Va.
 Farm Rebecca Vanscoy Acres 11
 Location (waters) _____
 Well No. 8001 Elev. 975*
 District Grant County Harrison
 The surface of tract is owned in fee by _____
 Address _____
 Mineral rights are owned by _____
 Address _____
 Drilling commenced July 23, 1909
 Drilling completed September 20, 1909
 Date Shot _____ From _____ To _____
 With _____
 Open Flow _____ /10ths Water in _____ Inch
 _____ /10ths Merc. in _____ Inch
 Volume _____ Cu. Ft.
 Rock Pressure _____ lbs. _____ hrs.
 Oil _____ bbls., 1st 24 hrs.
 Fresh water none recorded feet _____ feet
 Salt water none recorded feet _____ feet

Casing and Tubing	Used in Drilling	Left in Well	Packers
Size			
16			Kind of Packer _____
13			
10	142	142	Size of _____
8 1/4	786	786	
6 5/8	1201	1201	Depth set _____
5 3/16	1823	1823	
3			Perf. top _____
2	2756	2756	Perf. bottom _____
Liners Used			Perf. top _____
			Perf. bottom _____

Not cemented
 CASING CEMENTED _____ SIZE _____ No. Ft. _____ Date _____
none recorded
 COAL WAS ENCOUNTERED AT _____ FEET _____ INCHES
 _____ FEET _____ INCHES FEET _____ INCHES
 _____ FEET _____ INCHES FEET _____ INCHES

Formation	Color	Hard or Soft	Top	Bottom	Oil, Gas or Water	Depth Found	Remarks
Little Dunkard			240	260			
Big Dunkard			340	400			
Gas sand			470	560			
First Salt			570	620	8"		
Second Salt			645	760			
Maxon			775	900	6"		
Little Lime			1080	1113			
Pencil cave			1130	1141			
Big Lime			1141	1205			
Big Injun			1205	1335			
Squaw			1350	1375			
Gantz			1400	1450			
Berea			1565	1665			
Fifty foot			1675	1697			
Thirty Foot			1719	?	gas	1722-1726	
Gordon			1805	1840			
Fourth			1885	1895			
Fifth			2042	2050	gas	2044	
Speechley			2737	2745	gas	2739	
Total depth				2756			

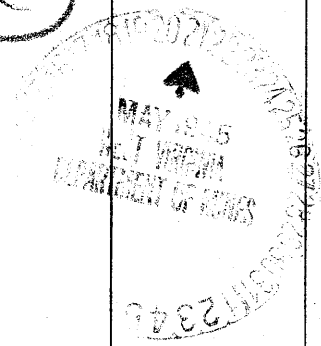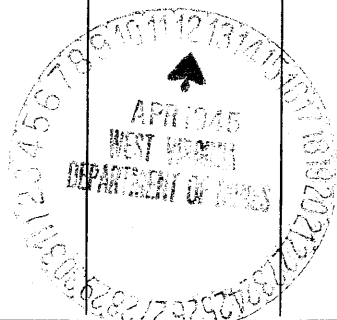

Formation	Color	Hard or Soft	Top	Bottom	Oil, Gas or Water	Depth Found	Remarks

Date April 10, 1945, 194

APPROVED Hope Natural Gas Company., Owner

By I.D. Frantz, Ass't. to Gen. Supt.
(Title)

