

LATITUDE 39° 17' 30"



009A
1.77W

00° 02' 08" LONGITUDE

7.5 OGIS topo location

7.5' loc _____ 15' loc _____
(calc.) _____

Company HNG Co. (7301)

Farm Adamston Coal Co.

Quad _____

County _____

District _____

WELL LOCATION MAP

File No. 033-30869



836

STATE OF WEST VIRGINIA
DEPARTMENT OF MINES
OIL AND GAS DIVISION

WELL RECORD

Permit No. 869-A Oil Gas Well (KIND)


Company Hope Natural Gas Company.
 Address 445 West Main St. Clarksburg, W. Va.
 Farm Adamston Coal Co. Acres 325
 Location (waters) _____
 Well No. 7301 Elev. 1063
 District Coal County Harrison
 The surface of tract is owned in fee by _____
 Address _____
 Mineral rights are owned by _____
 Address _____
 Drilling commenced June 14, 1912
 Drilling completed July 27, 1912
 Date Shot From _____ To _____
 With _____
 Open Flow /10ths Water in _____ Inch
 /10ths Merc. in _____ Inch
 Volume _____ Cu. Ft.
 Rock Pressure _____ lbs. _____ hrs.
 Oil _____ bbls., 1st 24 hrs.
 Fresh water 830 feet _____ feet
 Salt water none recorded feet _____ feet

Casing and Tubing	Used in Drilling	Left in Well	Packers
Size			
16			Kind of Packer
13			
10			Size of
8 1/4	1005	Pulled	
6 5/8	1516	Pulled	Depth set
5 3/16	2400	2400	
3			Perf. top
2	3085	3085	Perf. bottom
Liners Used			Perf. top
			Perf. bottom

Not cemented
 CASING CEMENTED _____ SIZE _____ No. Ft. _____ Date _____
none recorded
 COAL WAS ENCOUNTERED AT _____ FEET _____ INCHES
 _____ FEET _____ INCHES _____ FEET _____ INCHES
 _____ FEET _____ INCHES _____ FEET _____ INCHES

Formation	Color	Hard or Soft	Top	Bottom	Oil, Gas or Water	Depth Found	Remarks
	Little Dunkard		400	450			
	Big Dunkard		500	550			
	First Salt		750	800			
	Second Salt		825	1000	water	830	
	Maxon		1200	1240			
	Big Lime		1370	1435			
	Big Injun		1435	1540			
	Fifty foot		1932	2020	gas	1950	
	Thirty foot		2030	2055			
	Gordon		2213	2238			
	Fourth		2238	2266	gas	2241	
	Fifth		2365	2385	gas	2372	
	Speechley		3063	3074	gas	3065	

TO BE PARTIALLY ABANDONED

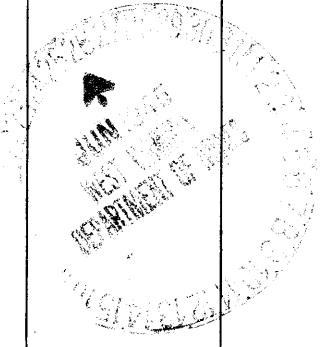

Formation	Color	Hard or Soft	Top	Bottom	Oil, Gas or Water	Depth Found	Remarks

Date June 23, 1945., 194

APPROVED Hope Natural Gas Company., Owner

By *[Signature]*
 Ass't. to Gen. Sup't. (Title)

