

0

1

2

3

1

2

3

- New Location
- Drill Deeper
- Abandonment

Map Sheet 43 Squares 518E19FB49R10-516P1


Company Hope Natural Gas Co.
 Address Clarksburg, W. Va.
 Farm A. B. Talbott
 Tract _____ Acres 50 Lease No. 37685
 Well (Farm) No. _____ Serial No. 6781
 Elevation (Spirit Level) 1235
 Quadrangle Weston
 County Harrison District E1K
 Engineer W. M. Bewers
 Engineer's Registration No. 900
 File No. _____ Drawing No. _____
 Date July 21, 1945 Scale 1" = 200'

STATE OF WEST VIRGINIA
 DEPARTMENT OF MINES
 OIL AND GAS DIVISION
 CHARLESTON

WELL LOCATION MAP
 FILE NO. H.A.R. - 277-A

+ Denotes location of well on United States Topographic Maps, scale 1 to 62,500, latitude and longitude lines being represented by border lines as shown

- Denotes one inch spaces on border line of original section

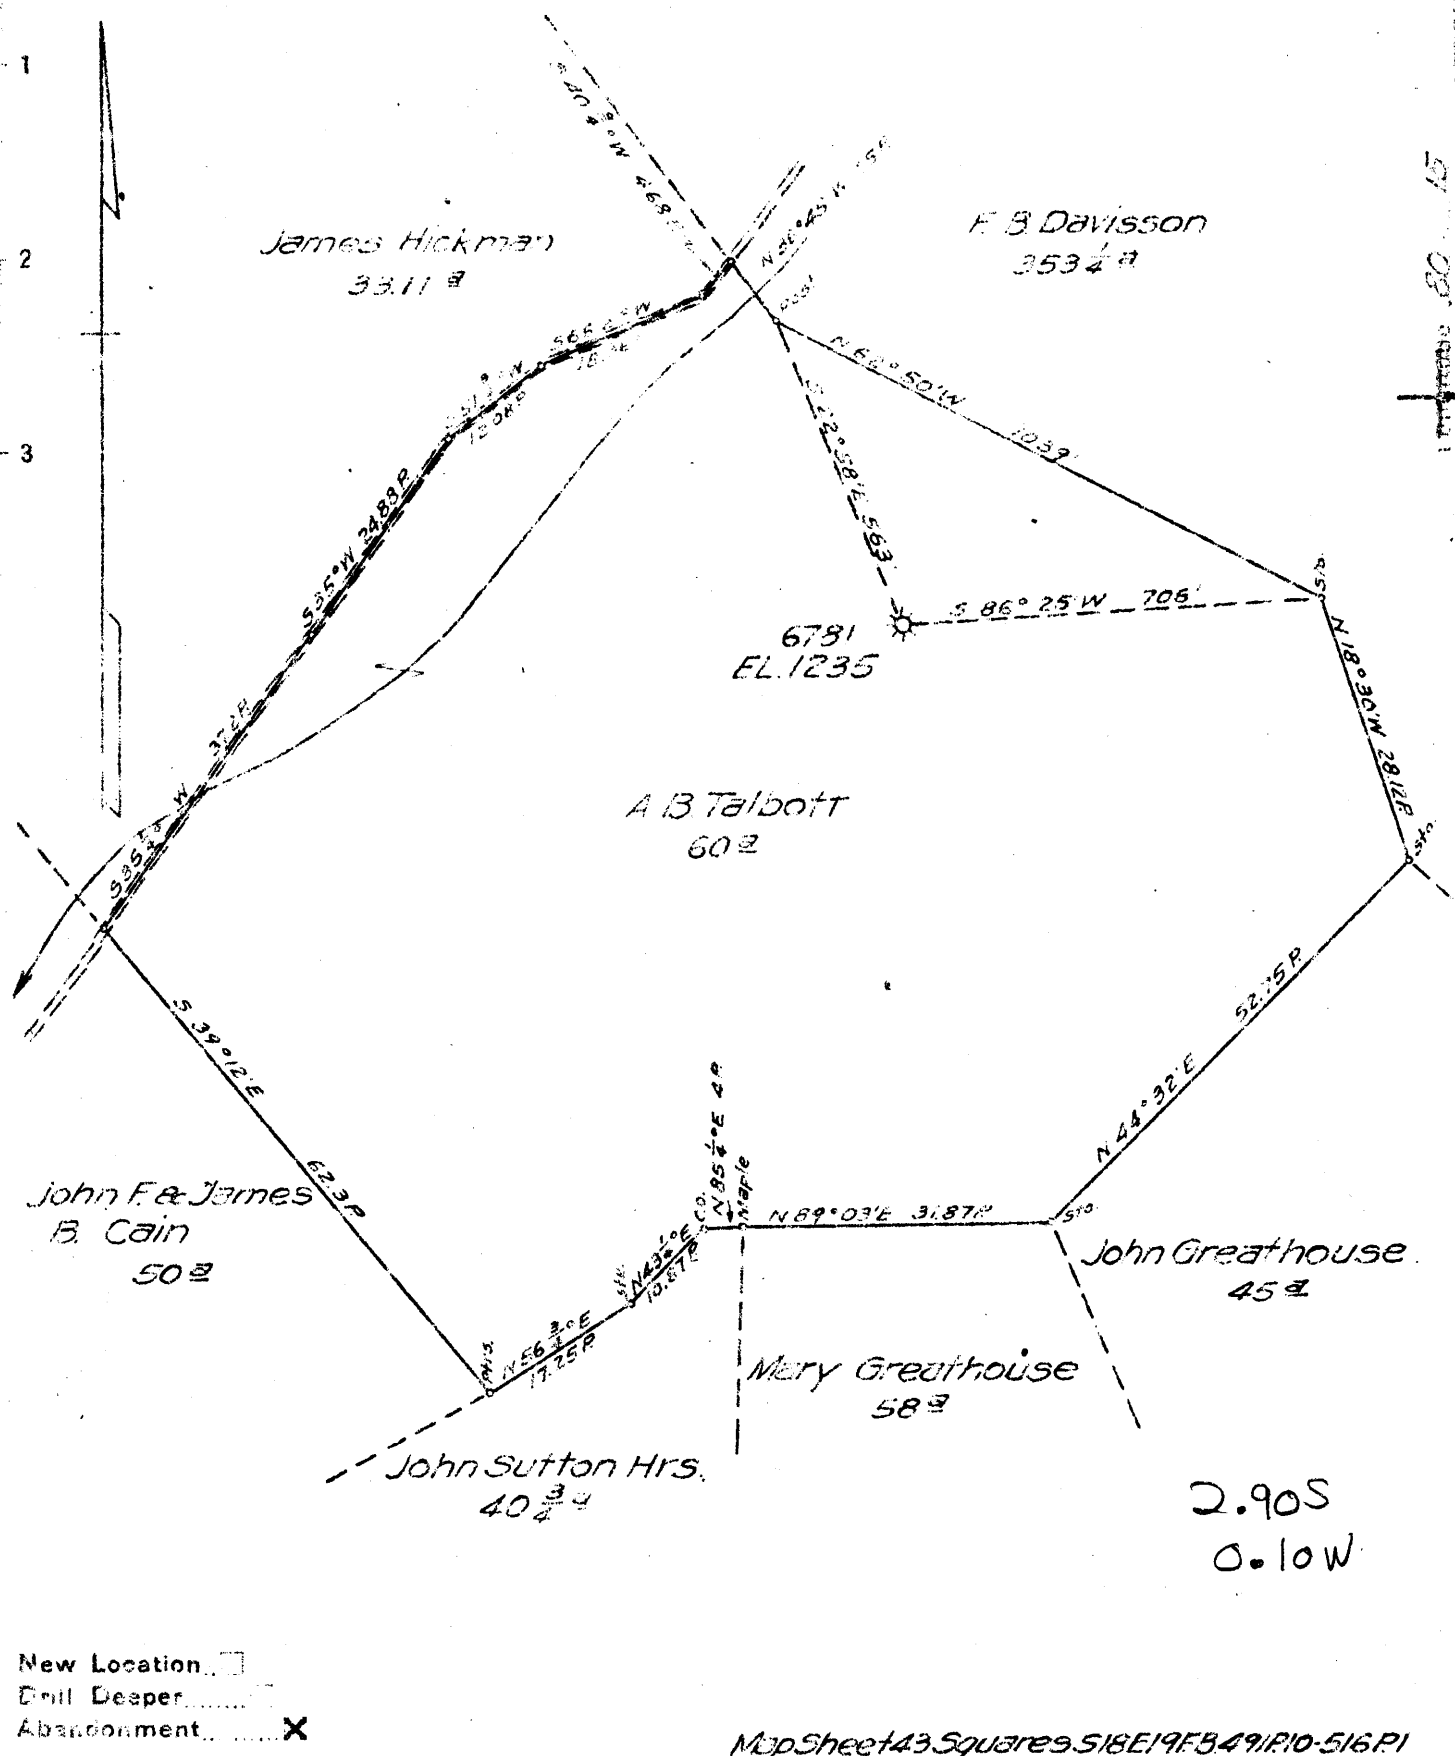

2.90S
0.10W



STATE OF WEST VIRGINIA
DEPARTMENT OF MINES
OIL AND GAS DIVISION

721

WELL RECORD

Permit No. HAR-877 *H*


Oil or Gas Well _____
(KIND)

Company Hope Natural Gas Company.
 Address 445 West Main St. Clerksburg, W. Va.
 Farm A.B. Talbott Acres 60
 Location (waters) _____
 Well No. 6781 Elev. 1235
 District ELK County Harrison
 The surface of tract is owned in fee by _____
 Address _____
 Mineral rights are owned by _____
 Address _____
 Drilling commenced April 1, 1926
 Drilling completed April 26, 1926
 Date Shot _____ From _____ To _____
 With _____
 Open Flow _____ /10ths Water in _____ Inch
 _____ /10ths Merc. in _____ Inch
 Volume _____ Cu. Ft.
 Rock Pressure _____ lbs. _____ hrs.
 Oil 50 bbls., 1st 24 hrs.
 Fresh water _____ feet _____ feet
 Salt water none recorded feet _____ feet

Casing and Tubing	Used in Drilling	Left in Well	Packers
Size			
16			Kind of Packer _____
13			
10	208	208	Size of _____
8 1/4	996	996	
6 5/8	1461	1461	Depth set _____
5 3/16			
3	1605	Pulled	Perf. top _____
2			Perf. bottom _____
Liners Used			Perf. top _____
			Perf. bottom _____

Not cemented
 CASING CEMENTED _____ SIZE _____ No. Ft. _____ Date _____
none recorded
 COAL WAS ENCOUNTERED AT _____ FEET _____ INCHES
 _____ FEET _____ INCHES FEET _____ INCHES
 _____ FEET _____ INCHES FEET _____ INCHES

Formation	Color	Hard or Soft	Top	Bottom	Oil, Gas or Water	Depth Found	Remarks
Little Dunkard			326	356	water	50	
Big Dunkard			390	430			
Gas sand			451	490			
First Salt			649	740			
Second Salt			760	909			
Maxon			1216	1293			
Little Lime			1372	1382			
Pencil cave			1382	1402			
Big Lime			1402	1444			
Big Injun			1444	1602	gas	1490-1605	
Total depth				1605			

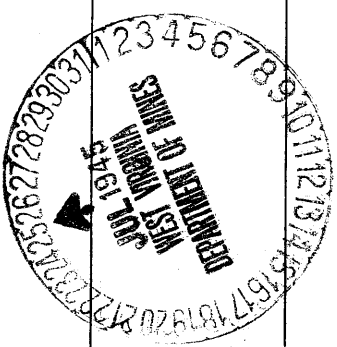

Formation	Color	Hard or Soft	Top	Bottom	Oil, Gas or Water	Depth Found	Remarks

Date July 21, 1945., 194

APPROVED Hope Natural Gas Company., Owner

By *J. J. [Signature]*
 Ass't. to Gen. Sup't. (Title)

