

1.24 S
4.16 W

New Location
 Drill Deeper
 Abandonment

Map Sh. 55 Sq. 5-16 E-G F.B. 775 P.17

Company HOPE NATURAL GAS CO.
 Address CLARKSBURG, W. VA.
 Farm HANNIBAL PERINE
 Tract _____ Acres 332 Lease No. 5781
 Well (Farm) No. _____ Serial No. 958
 Elevation (Spirit Level) 1036'
 Quadrangle WESTON
 County HARRISON District TEN MILE
 Engineer W M Bowers
 Engineer's Registration No. 900
 File No. _____ Drawing No. _____
 Date AUGUST 3, 1945 Scale 1" = 40 P

STATE OF WEST VIRGINIA
 DEPARTMENT OF MINES
 OIL AND GAS DIVISION
 CHARLESTON

WELL LOCATION MAP
 FILE NO. HAR-881-A

+ Denotes location of well on United States Topographic Maps, scale 1 to 62,500, latitude and longitude lines being represented by border lines as shown.

- Denotes one inch spaces on border line of original tracing.



717

STATE OF WEST VIRGINIA
DEPARTMENT OF MINES
OIL AND GAS DIVISION

WELL RECORD

Permit No. 881 A


Oil or Gas Well _____
(KIND)

Company Hope Natural Gas Company.
 Address 445 West Main St. Clarksburg, W. Va.
 Farm Hannibal Perrine Acres 122
 Location (waters) _____
 Well No. 958 Elev. 1036
 District Ten Mile County Harrison
 The surface of tract is owned in fee by _____
 Address _____
 Mineral rights are owned by _____
 Address _____
 Drilling commenced August 31, 1907
 Drilling completed December 19, 1907
 Date Shot _____ From _____ To _____
 With _____
 Open Flow _____ /10ths Water in _____ Inch
 _____ /10ths Merc. in _____ Inch
 Volume _____ Cu. Ft.
 Rock Pressure _____ lbs. _____ hrs.
 Oil _____ bbls., 1st 24 hrs.
 Fresh water none recorded feet _____ feet
 Salt water none recorded feet _____ feet

Casing and Tubing	Used in Drilling	Left in Well	Packers
Size			
16			Kind of Packer _____
13	21	21	
10	225	Pulled	Size of _____
8 1/4	1490	1490	
6 3/8	1771	1771	Depth set _____
5 3/16	1789	1789	
3			Perf. top _____
2			Perf. bottom _____
Liners Used			Perf. top _____
			Perf. bottom _____

Not cemented
 CASING CEMENTED _____ SIZE _____ No. Ft. _____ Date _____
 COAL WAS ENCOUNTERED AT **109** FEET **84** INCHES
 _____ FEET _____ INCHES FEET _____ INCHES
 _____ FEET _____ INCHES FEET _____ INCHES

Formation	Color	Hard or Soft	Top	Bottom	Oil, Gas or Water	Depth Found	Remarks
Pittsburgh Coal			109	116			
Little Dunkard			460	490	show gas	400	
Big Dunkard			600	660			
Gas sand			815	890			
Salt sand			1005	1106			
Maxon			1230	1305			
Little Lime			1440	1460			
Big Lime			1480	1560			
Big Injun			1560	1650			
Squaw			1680	1730			
Gantz			1890	1920			
Fifty foot			2020	2080			
Gordon Stray			2132	2160	show gas	2160	
Gordon			2208	2255	gas	2210	
Fourth			2265	2285			
Fifth			2430	2439	gas	2432	
Originally drilled to				2708			

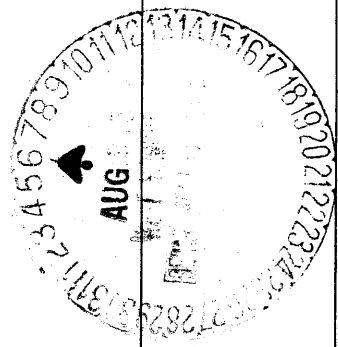

Formation	Color	Hard or Soft	Top	Bottom	Oil, Gas or Water	Depth Found	Remarks

Date August 3, 1945., 194

APPROVED Hope Natural Gas Company., Owner

By [Signature]
Ass't. to Gen. Sup't. (Title)

