

JOHN DOLAN
391 A

SUNNY CROFT
COUNTRY CLUB

ROUTE 19
TO WESTON
M^c CALLEYS RUN 2738
Elev. 1036

HARRISON COUNTY POOR FARM
100 A



2563
Elev. 1180

S 60° E 57 1/2'

S 88° E 60'

N 76° 30' E 65 1/2 P_s

N 4° 30' E 866'

N 37° 59' W 390'

N 73° E 17'

N 11° 41' E 1677'

NATHAN GOFF

NATHAN GOFF

MARY
CORK
7 A
WEST FORK

A. W. FITTRO

C. C. FITTRO
148 A

5.21 S
2.50 W

New Location
Drill Deeper
Appropriation 2563

F. B. # 512 P 30 MAP # 44 - 514 E 13

Company HOPE NATURAL GAS CO.
 Address CLARKSBURG, W. VA.
 Farm HARRISON COUNTY POOR FARM
 Tract 1 Acres 100 Lease No. _____
 Well (Farm) No. 1 Serial No. 2563
 Elevation (Spirit Level) SHOWN ABOVE
 Quadrangle CLARKSBURG
 County HARRISON District CLARK
 Engineer W. M. Bowers
 Engineer's Registration No. 930
 File No. _____ Drawing No. _____
 Date AUG. 6, 1945 Scale 1" = 500'

STATE OF WEST VIRGINIA
DEPARTMENT OF MINES
OIL AND GAS DIVISION
CHARLESTON

WELL LOCATION MAP
FILE NO. HAR-883-A

+ Denotes location of well on United States Topographic Maps, scale 1 to 62,500, latitude and longitude lines being represented by border lines as shown.

- Denotes one inch spaces on border line of original tracing



STATE OF WEST VIRGINIA
DEPARTMENT OF MINES
OIL AND GAS DIVISION

713

WELL RECORD


Permit No. 1883 A ~~Oil~~ or Gas Well (KIND)

Company Hope Natural Gas Company.
 Address 445 West Main St. Clarksburg, W.Va.
 Farm Harrison County Poor Farm Acres 100
 Location (waters) _____
 Well No. 2563 Elev. 1180
 District Clark County Harrison
 The surface of tract is owned in fee by _____
 Address _____
 Mineral rights are owned by _____
 Address _____
 Drilling commenced June 29, 1912
 Drilling completed August 9, 1912
 Date Shot _____ From _____ To _____
 With _____
 Open Flow _____ /10ths Water in _____ Inch
 _____ /10ths Merc. in _____ Inch
 Volume _____ Cu. Ft.
 Rock Pressure _____ lbs. _____ hrs.
 Oil _____ bbls., 1st 24 hrs.
 Fresh water 545 780 feet _____ feet
 Salt water none recorded feet _____ feet

Casing and Tubing	Used in Drilling	Left in Well	Packers
Size			
16			Kind of Packer
13			
10	279	Pulled	Size of
8 1/4	1069	Pulled	
6 1/2	1517	1517	Depth set
5 3/16	2225	2225	
3			Perf. top
2			Perf. bottom
Liners Used			Perf. top
3x 4 1/2	324	Pulled	Perf. bottom

Not cemented
 CASING CEMENTED _____ SIZE _____ No. Ft. _____ Date _____
none recorded
 COAL WAS ENCOUNTERED AT _____ FEET _____ INCHES
 _____ FEET _____ INCHES FEET _____ INCHES
 _____ FEET _____ INCHES FEET _____ INCHES

Formation	Color	Hard or Soft	Top	Bottom	Oil, Gas or Water	Depth Found	Remarks
Little Dunkard			510	578	water	545	
Big Dunkard			625	693			
Gas sand		4	733	806	water	780	
First Salt			848	932			
Second Salt			952	1018			
Maxon			1316	1355			
Little Lime			1400	1416			
Pencil cave			1416	1435			
Big Lime			1435	1511			
Big Injun			1511	1606	gas	1545	
Gantz			1857	1873			
Fifty foot			2027	2066			
Thirty foot			2081	2112			
Gordon Stray			2218	2232			
Gordon			2241	2289			
Fourth			2290	2319	gas	2292- 2300	
Fifth			2425	2443	gas	2428	
Speechley			3060	3080	gas	3065	
Later filled back to				2539			

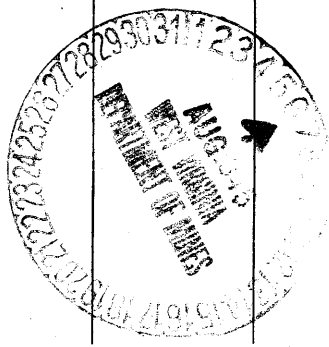

Formation	Color	Hard or Soft	Top	Bottom	Oil, Gas or Water	Depth Found	Remarks

Date August 4, 1945., 194

APPROVED Hope Natural Gas Company., Owner

[Signature]
 Ass't. to Gen. Sup't. (Title)

