

2.85S  
2.63W

WOLF SUMMIT

New Location   
 Drill Deeper   
 Abandonment  - 196

Map Sheet 44 Square S12E8 FB 673 P 27-28

Company	HOPE NATURAL GAS CO.
Address	CLARKSBURG, W. VA.
Farm	W. M. DENNISON
Tract	Acres 177 Leas. No. 777
Well (Farm) No.	Serial No. 195-196
Elevation (Spirit Level)	1210 : 1328
Quadrangle	CLARKSBURG
County	HARRISON District TEN MILE
Engineer	W.M. Bowen
Engineer's Registration No.	920
File No.	Drawing No.
Date	8-8-45 Scale 1" = 40 P

STATE OF WEST VIRGINIA  
 DEPARTMENT OF MINES  
 OIL AND GAS DIVISION  
 CHARLESTON

**WELL LOCATION MAP**  
 FILE NO. HAR-886-A-#196

+ Denotes location of well on United States Topographic Maps, scale 1 to 62,500, latitude and longitude lines being represented by border lines as shown.

- Denotes one inch spaces on border line of original tracing



STATE OF WEST VIRGINIA  
DEPARTMENT OF MINES  
OIL AND GAS DIVISION

779

Permit No. H-886-A

WELL RECORD


Oil or Gas Well \_\_\_\_\_  
(KIND)

Company Hope Natural Gas Company.  
 Address 445 West Main St. Clarksburg, W. Va.  
 Farm W.M. Dennison Acres 177  
 Location (waters) \_\_\_\_\_  
 Well No. 196 Elev. 1328  
 District Ten Mile County Harrison  
 The surface of tract is owned in fee by \_\_\_\_\_  
 Address \_\_\_\_\_  
 Mineral rights are owned by \_\_\_\_\_  
 Address \_\_\_\_\_  
 Drilling commenced July 18, 1900  
 Drilling completed August 26, 1900  
 Date Shot \_\_\_\_\_ From \_\_\_\_\_ To \_\_\_\_\_  
 With \_\_\_\_\_  
 Open Flow \_\_\_\_\_ /10ths Water in \_\_\_\_\_ Inch  
 \_\_\_\_\_ /10ths Merc. in \_\_\_\_\_ Inch  
 Volume \_\_\_\_\_ Cu. Ft.  
 Rock Pressure \_\_\_\_\_ lbs. \_\_\_\_\_ hrs.  
 Oil \_\_\_\_\_ bbls., 1st 24 hrs.  
 Fresh water none recorded feet \_\_\_\_\_ feet  
 Salt water none recorded feet \_\_\_\_\_ feet

Casing and Tubing	Used in Drilling	Left in Well	Packers
Size			
16			Kind of Packer _____
13			
10	<u>451</u>	<u>Pulled</u>	Size of _____
8 1/4	<u>914</u>	<u>914</u>	
6 5/8	<u>1851</u>	<u>1851</u>	Depth set _____
5 3/16	<u>2572</u>	<u>2572</u>	
3			Perf. top _____
2			Perf. bottom _____
Liners Used			Perf. top _____
			Perf. bottom _____

**Not cemented**  
 CASING CEMENTED \_\_\_\_\_ SIZE \_\_\_\_\_ No. Ft. \_\_\_\_\_ Date \_\_\_\_\_  
 COAL WAS ENCOUNTERED AT 400 FEET 72 INCHES  
 \_\_\_\_\_ FEET \_\_\_\_\_ INCHES FEET \_\_\_\_\_ INCHES  
 \_\_\_\_\_ FEET \_\_\_\_\_ INCHES FEET \_\_\_\_\_ INCHES

Formation	Color	Hard or Soft	Top	Bottom	Oil, Gas or Water	Depth Found	Remarks
Pittsburgh	Coal		400	406			
Salt sand			1500	1600			
Big Lime			1720	1820			
Big Injun			1820	1860			
Fifty Foot			2320	2340			
Thirty Foot			2430	2450			
Stray			2455	2515			
Gordon			2516	2571			
Fifth			2766	2772			
Total depth				2812			Gas ?

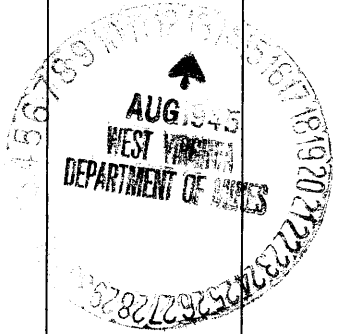

Formation	Color	Hard or Soft	Top	Bottom	Oil, Gas or Water	Depth Found	Remarks

Date August 10, 1945., 194

APPROVED Hope Natural Gas Company., Owner

By [Signature]  
Ass't. to Gen. Supt. (Title)

