

+ New Location
 * Well Deeper
 X Abandonment

X (Partial) 7935

Company	Hope Natural Gas Co.		
Address	Clarksburg, W. Va.		
Farm	Lee Maxwell		
Tract	Acres	Lease No.	
	385	258	
Well (Farm) No.	2-3	Serial No.	See Above
Elevation (Spirit Level)	See Above		
Quadrangle	Weston		
County	Harrison	District	Union
Engineer	W.M. Powers		
Engineer's Registration No.	900		
File No.	Drawing No.		
Date	June 11, 1945	Scale	1" = 40 P.

STATE OF WEST VIRGINIA
 DEPARTMENT OF MINES
 OIL AND GAS DIVISION
 CHARLESTON

WELL LOCATION MAP
 FILE NO. HAR-892-A # 79

+ Denotes location of well on United States Topographic Maps, scale 1 to 62,500, latitude and longitude lines being represented by border lines as shown.

- Denotes one inch spaces on border line of original tracing.

FB 659 P 15
 " 756 P 11
 " 775 P 12



STATE OF WEST VIRGINIA
DEPARTMENT OF MINES
OIL AND GAS DIVISION

733

WELL RECORD

Permit No. 8924 Oil or Gas Well (KIND)


Company Hope Natural Gas Company.
 Address 445 West Main St. Clarksburg, W. Va.
 Farm Lee Maxwell Acres 385
 Location (waters) _____
 Well No. 7935 Elev. 1145
 District Union County Harrison
 The surface of tract is owned in fee by _____
 Address _____
 Mineral rights are owned by _____
 Address _____
 Drilling commenced June 28, 1915
 Drilling completed August 4, 1915
 Date Shot _____ From _____ To _____
 With _____
 Open Flow _____ /10ths Water in _____ Inch
 _____ /10ths Merc. in _____ Inch
 Volume _____ Cu. Ft.
 Rock Pressure _____ lbs. _____ hrs.
 Oil _____ bbls., 1st 24 hrs.
 Fresh water _____ feet _____ feet
 Salt water 960 feet _____ feet

Casing and Tubing	Used in Drilling	Left in Well	Packers
Size			
16			Kind of Packer
13			
10	185	185	Size of
8 1/4	1048	1048	
6 5/8	1463	1463	Depth set
5 3/16	2132	2132	
3			Perf. top
2	3056	3056	Perf. bottom
Liners Used			Perf. top
			Perf. bottom

Not cemented
 CASING CEMENTED _____ SIZE _____ No. Ft. _____ Date _____
None recorded
 COAL WAS ENCOUNTERED AT _____ FEET _____ INCHES
 _____ FEET _____ INCHES FEET _____ INCHES
 _____ FEET _____ INCHES FEET _____ INCHES

Formation	Color	Hard or Soft	Top	Bottom	Oil, Gas or Water	Depth Found	Remarks
Little Dunkard			430	450			
Big Dunkard			476	555			
Gas sand			632	654			
First Salt			696	790			
Second Salt			820	1033	water	960	
Maxon			1270	1304			
Little Lime			1360	1379			
Pencil cave			1379	1389			
Big Lime			1389	1446			
Big Injun			1446	1550			
Berea			1640	1670			
Gayz			1837	1854			
Fifty foot			1902	1983	gas	1958	
Thirty Foot			2005	2023	gas	2006	
Gordon stray			2130	2187			
Gordon			2192	2248			
Fourth			2260	2275			
Fifth			2351	2351	gas	2335	
Speechley			3031	3040	gas	3033	
Total depth				3056			

TO BE PARTIALLY ABANDONED

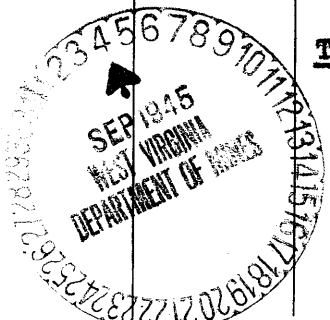

Formation	Color	Hard or Soft	Top	Bottom	Oil, Gas or Water	Depth Found	Remarks

Date August 31, 1945, 194

APPROVED Hope Natural Gas Company., Owner

By *[Signature]*
 Ass't. to Gen. Sup't. (Title)

