

New Location   
 Drill Deeper   
 Abandonment  7337

MAP SH. 43 SIZE 17 F.B. 512 P.3

Company HOPE NATURAL GAS CO.  
 Address CLARKSBURG, W.VA.  
 Farm BLOUNT & PARKER  
 Tract \_\_\_\_\_ Acres 212 Lease No. 4-547  
 Well (Farm) No. \_\_\_\_\_ Serial No. 7334-37  
 Elevation (Spirit Level) AS SHOWN  
 Quadrangle CLARKSBURG  
 County HARRISON District COAL  
 Engineer W.M. Powers  
 Engineer's Registration No. 900  
 File No. \_\_\_\_\_ Drawing No. 1" = 800'  
 Date 8-8-45 Scale \_\_\_\_\_

STATE OF WEST VIRGINIA  
 DEPARTMENT OF MINES  
 OIL AND GAS DIVISION  
 CHARLESTON

WELL LOCATION MAP  
 FILE NO. HAR-893-A - # 7337

+ Denotes location of well on United States Topographic Maps, scale 1 to 62,500, latitude and longitude lines being represented by border lines as shown.

- Denotes one inch spaces on border line of original tracing.



STATE OF WEST VIRGINIA  
DEPARTMENT OF MINES  
OIL AND GAS DIVISION

726

Ab 843-A

WELL RECORD


Permit No. \_\_\_\_\_ For Gas Well \_\_\_\_\_ (KIND)

Company Hope Natural Gas Company.  
 Address 445 West Main St. Clarksburg, W. Va.  
 Farm Blount & Parker Acres 212  
 Location (waters) \_\_\_\_\_  
 Well No. 7337 Elev. 1191  
 District Coal County Harrison  
 The surface of tract is owned in fee by \_\_\_\_\_  
 Address \_\_\_\_\_  
 Mineral rights are owned by \_\_\_\_\_  
 Address \_\_\_\_\_  
 Drilling commenced September 4, 1916  
 Drilling completed November 21, 1916  
 Date Shot \_\_\_\_\_ From \_\_\_\_\_ To \_\_\_\_\_  
 With \_\_\_\_\_  
 Open Flow \_\_\_\_\_ /10ths Water in \_\_\_\_\_ Inch  
 \_\_\_\_\_ /10ths Merc. in \_\_\_\_\_ Inch  
 Volume \_\_\_\_\_ Cu. Ft.  
 Rock Pressure \_\_\_\_\_ lbs. \_\_\_\_\_ hrs.  
 Oil \_\_\_\_\_ bbls., 1st 24 hrs.  
 Fresh water none recorded feet \_\_\_\_\_ feet  
 Salt water none recorded feet \_\_\_\_\_ feet

Casing and Tubing	Used in Drilling	Left in Well	Packers
Size			
16			Kind of Packer
13			
10	200	200	Size of
8 1/4	1230	1230	
6 5/8	1666	1666	Depth set
5 3/16	2222	2222	
3			Perf. top
2	2667	Pulled	Perf. bottom
Liners Used			Perf. top
			Perf. bottom

CASING CEMENTED 10 SIZE 200 No. Ft. 1916 Date \_\_\_\_\_  
 COAL WAS ENCOUNTERED AT 140 FEET 96 INCHES  
 \_\_\_\_\_ FEET \_\_\_\_\_ INCHES FEET \_\_\_\_\_ INCHES  
 \_\_\_\_\_ FEET \_\_\_\_\_ INCHES FEET \_\_\_\_\_ INCHES

Formation	Color	Hard or Soft	Top	Bottom	Oil, Gas or Water	Depth Found	Remarks
Pittsburgh Coal			140	148			
Little Dunkard			540	580			
Big Dunkard			690	750			
First Salt			1000	1050			
Second Salt			1055	1160			
Maxon			1470	1500			
Big Lime			1595	1658			
Big Injun			1658	1768			
Fifty foot			2205	2240			
Thirty Foot			2293	2340			
Gordon Stray			2370	2395			
Gordon			2475	2540	gas	2512	
Fourth			2555	2590			
Fifth			2620	2667	gas	2637 2646	
Total depth				2667			

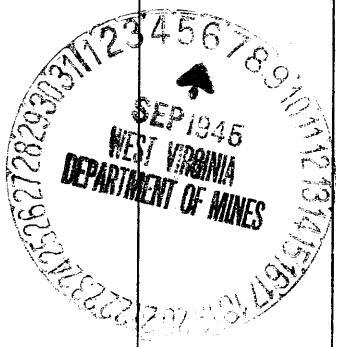

Formation	Color	Hard or Soft	Top	Bottom	Oil, Gas or Water	Depth Found	Remarks

September 4, 1945.

Date \_\_\_\_\_, 194

Hope Natural Gas Company.

APPROVED \_\_\_\_\_, Owner

By W. J. [Signature]  
Ass't. to Gen. Supt.  
(Title)

