

New Location
 Drill Deeper
 Abandonment **X**

Map Sheet 55.514E11FB472P32 & FB491P18

Company Hope Natural Gas Co.
 Address Clarksburg, W.Va
 Farm Romine Hrs.
 Tract Acres 60 Lease No. 52945
 Well (Farm) No. Serial No. 7294
 Elevation (Spirit Level) 1198
 Quadrangle Clarksburg
 County Harrison District Union
 Engineer W.M. Powers
 Engineer's Registration No. 900
 File No. Drawing No.
 Date Sept. 12, 1945 Scale 1" = 40 P

STATE OF WEST VIRGINIA
 DEPARTMENT OF MINES
 OIL AND GAS DIVISION
 CHARLESTON

WELL LOCATION MAP
 FILE NO. HAR-894-A

+ Denotes location of well on United States Topographic Maps, scale 1 to 62,500. latitude and longitude lines being represented by border lines as shown.

- Denotes one inch spaces on border line of original tracing



747

STATE OF WEST VIRGINIA
DEPARTMENT OF MINES
OIL AND GAS DIVISION

WELL RECORD

Permit No. 894-A


Oil or Gas Well (KIND)

Company Hope Natural Gas Company.
 Address 445 West Main St. Clarksburg, W. Va.
 Farm Romine Hrs. Acres 60
 Location (waters) _____
 Well No. 7294 Elev. 1198
 District Union County Harrison
 The surface of tract is owned in fee by _____
 Address _____
 Mineral rights are owned by _____
 Address _____
 Drilling commenced May 15, 1911
 Drilling completed July 11, 1911
 Date Shot _____ From _____ To _____
 With _____
 Open Flow _____ /10ths Water in _____ Inch
 _____ /10ths Merc. in _____ Inch
 Volume _____ Cu. Ft.
 Rock Pressure _____ lbs. _____ hrs.
 Oil _____ bbls., 1st 24 hrs.
 Fresh water none recorded feet _____ feet
 Salt water none recorded feet _____ feet

Casing and Tubing	Used in Drilling	Left in Well	Packers
Size			
16			Kind of Packer
13			
10	192	192	Size of
8 1/4			
6 5/8	1545	1545	Depth set
5 3/16	2383	Pulled	
3	3082	Pulled	Perf. top
2			Perf. bottom
Liners Used			Perf. top
			Perf. bottom

~~not cemented~~
 CASING CEMENTED _____ SIZE _____ No. Ft. _____ Date _____
~~none recorded~~
 COAL WAS ENCOUNTERED AT _____ FEET _____ INCHES
 _____ FEET _____ INCHES FEET _____ INCHES
 _____ FEET _____ INCHES FEET _____ INCHES

Formation	Color	Hard or Soft	Top	Bottom	Oil, Gas or Water	Depth Found	Remarks
Little Dunkard			460	498			
Big Dunkard			510	638			
First Salt			842	885			
Second Salt			910	1025			
Maxon			1230	1300			
Big Lime			1375	1445			
Big Injun			1455	1575			
Gantz			1780	1810			
Fifty foot			1925	1985			
Thirty Foot			2090	2110			
Stray			2150	2190			
Gordon			2260	2265			
Fourth			2285	2295			
Fifth			2343	2365	gas	2350	
Speechley			3043	3049	gas	3045	
Total depth				3068			
Filled back to				2130			

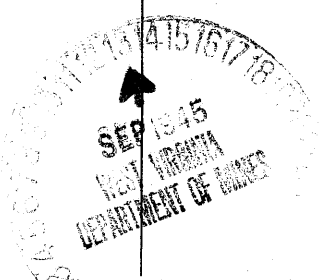

Formation	Color	Hard or Soft	Top	Bottom	Oil, Gas or Water	Depth Found	Remarks

Date September 11, 1945., 194

APPROVED Hope Natural Gas Company., Owner

By *A. J. [Signature]*
 Ass't. to Gen. Sup't. (Title)

