

0.738
0.69W

- New Location
- Drill Deeper
- Abandonment

Map 5h.55 Sq. 5-15 E-10 F.B. 777 P. 14

Company HOPE NATURAL GAS CO.
 Address CLARKSBURG, W. VA.
 Farm F. M. DAVIS
 Tract _____ Acres 18 Lease No. 52843
 Well (Farm) No. _____ Serial No. 8047
 Elevation (Spirit Level) 1097'
 Quadrangle WESTON
 County HARRISON District UNION
 Engineer W. M. Bowers
 Engineer's Registration No. 900
 File No. _____ Drawing No. _____
 Date 9-20-45 Scale 1" = 200'

STATE OF WEST VIRGINIA
 DEPARTMENT OF MINES
 OIL AND GAS DIVISION
 CHARLESTON

WELL LOCATION MAP
 FILE NO. HAR-895-A

+ Denotes location of well on United States Topographic Maps, scale 1 to 62,500, latitude and longitude lines being represented by border lines as shown.

- Denotes one inch spaces on border, line of original location.



727

STATE OF WEST VIRGINIA
DEPARTMENT OF MINES
OIL AND GAS DIVISION

WELL RECORD

Permit No. 895A Oil or Gas Well _____ (KIND)


Company Hops Natural Gas Company.
 Address 445 West Main St. Clarksburg, W. Va.
 Farm F.M. Davis Acres 18
 Location (waters) _____
 Well No. 8047 Elev. 1097
 District Union County Harrison
 The surface of tract is owned in fee by _____
 Address _____
 Mineral rights are owned by _____
 Address _____
 Drilling commenced April 14, 1910
 Drilling completed May 14, 1910
 Date Shot _____ From _____ To _____
 With _____
 Open Flow _____ /10ths Water in _____ Inch
 _____ /10ths Merc. in _____ Inch
 Volume _____ Cu. Ft.
 Rock Pressure _____ lbs. _____ hrs.
 Oil _____ bbls., 1st 24 hrs.
 Fresh water none recorded feet _____ feet
 Salt water none recorded feet _____ feet

Casing and Tubing	Used in Drilling	Left in Well	Packers
Size			
16			Kind of Packer _____
13			
10			Size of _____
8 1/4	915	Pulled	
6 5/8	1325	1325	Depth set _____
5 3/16	2020	2020	
3			Perf. top _____
2			Perf. bottom _____
Liners Used			Perf. top _____
			Perf. bottom _____

Not cemented
 CASING CEMENTED _____ SIZE _____ No. Ft. _____ Date _____

none recorded
 COAL WAS ENCOUNTERED AT _____ FEET _____ INCHES
 _____ FEET _____ INCHES FEET _____ INCHES
 _____ FEET _____ INCHES FEET _____ INCHES

Formation	Color	Hard or Soft	Top	Bottom	Oil, Gas or Water	Depth Found	Remarks
Little Dunkard			258	278			
Big Dunkard			355	395			
Gas sand			540	593			
First Salt			700	749			
Second Salt			780	896			
Maxon			1127	1164			
Little Line			1252	1263			
Pencil cave	4		1263	1266			
Big Line			1266	1323			
Big Injun			1323	1418			
Squaw			1452	1484			
Fifty foot			1762	1875	gas	1870	
Thirty Foot			1916	1935			
Gordon Stray			2016	2046			
Gordon			2048	2076			
Fourth			2110	2130			
Fifth			2193	2206	gas	2198	
Speechley			2273	2284	gas	2376	
Total depth				2922			

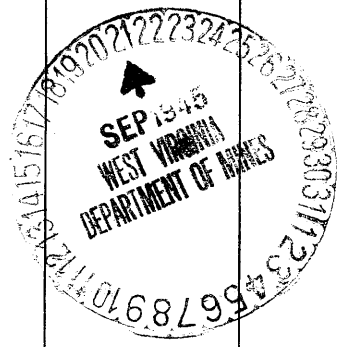

Formation	Color	Hard or Soft	Top	Bottom	Oil, Gas or Water	Depth Found	Remarks

Date September 20, 1945, 194

APPROVED Hope Natural Gas Company., Owner

By *[Signature]*
Ass't. to Gen. Sup^(Title)