

LATITUDE 39° 17' 30"

80° 15' 00"

LONGITUDE

7'5 OGIS topo location

7.5' loc, <u>1.315</u>	15' loc _____
<u>.020</u>	(calc.) _____

Company _____

Farm _____


Quad Clarksburg 7 1/2

County Harr

District Simpson

WELL LOCATION MAP

File No. 967A Harr

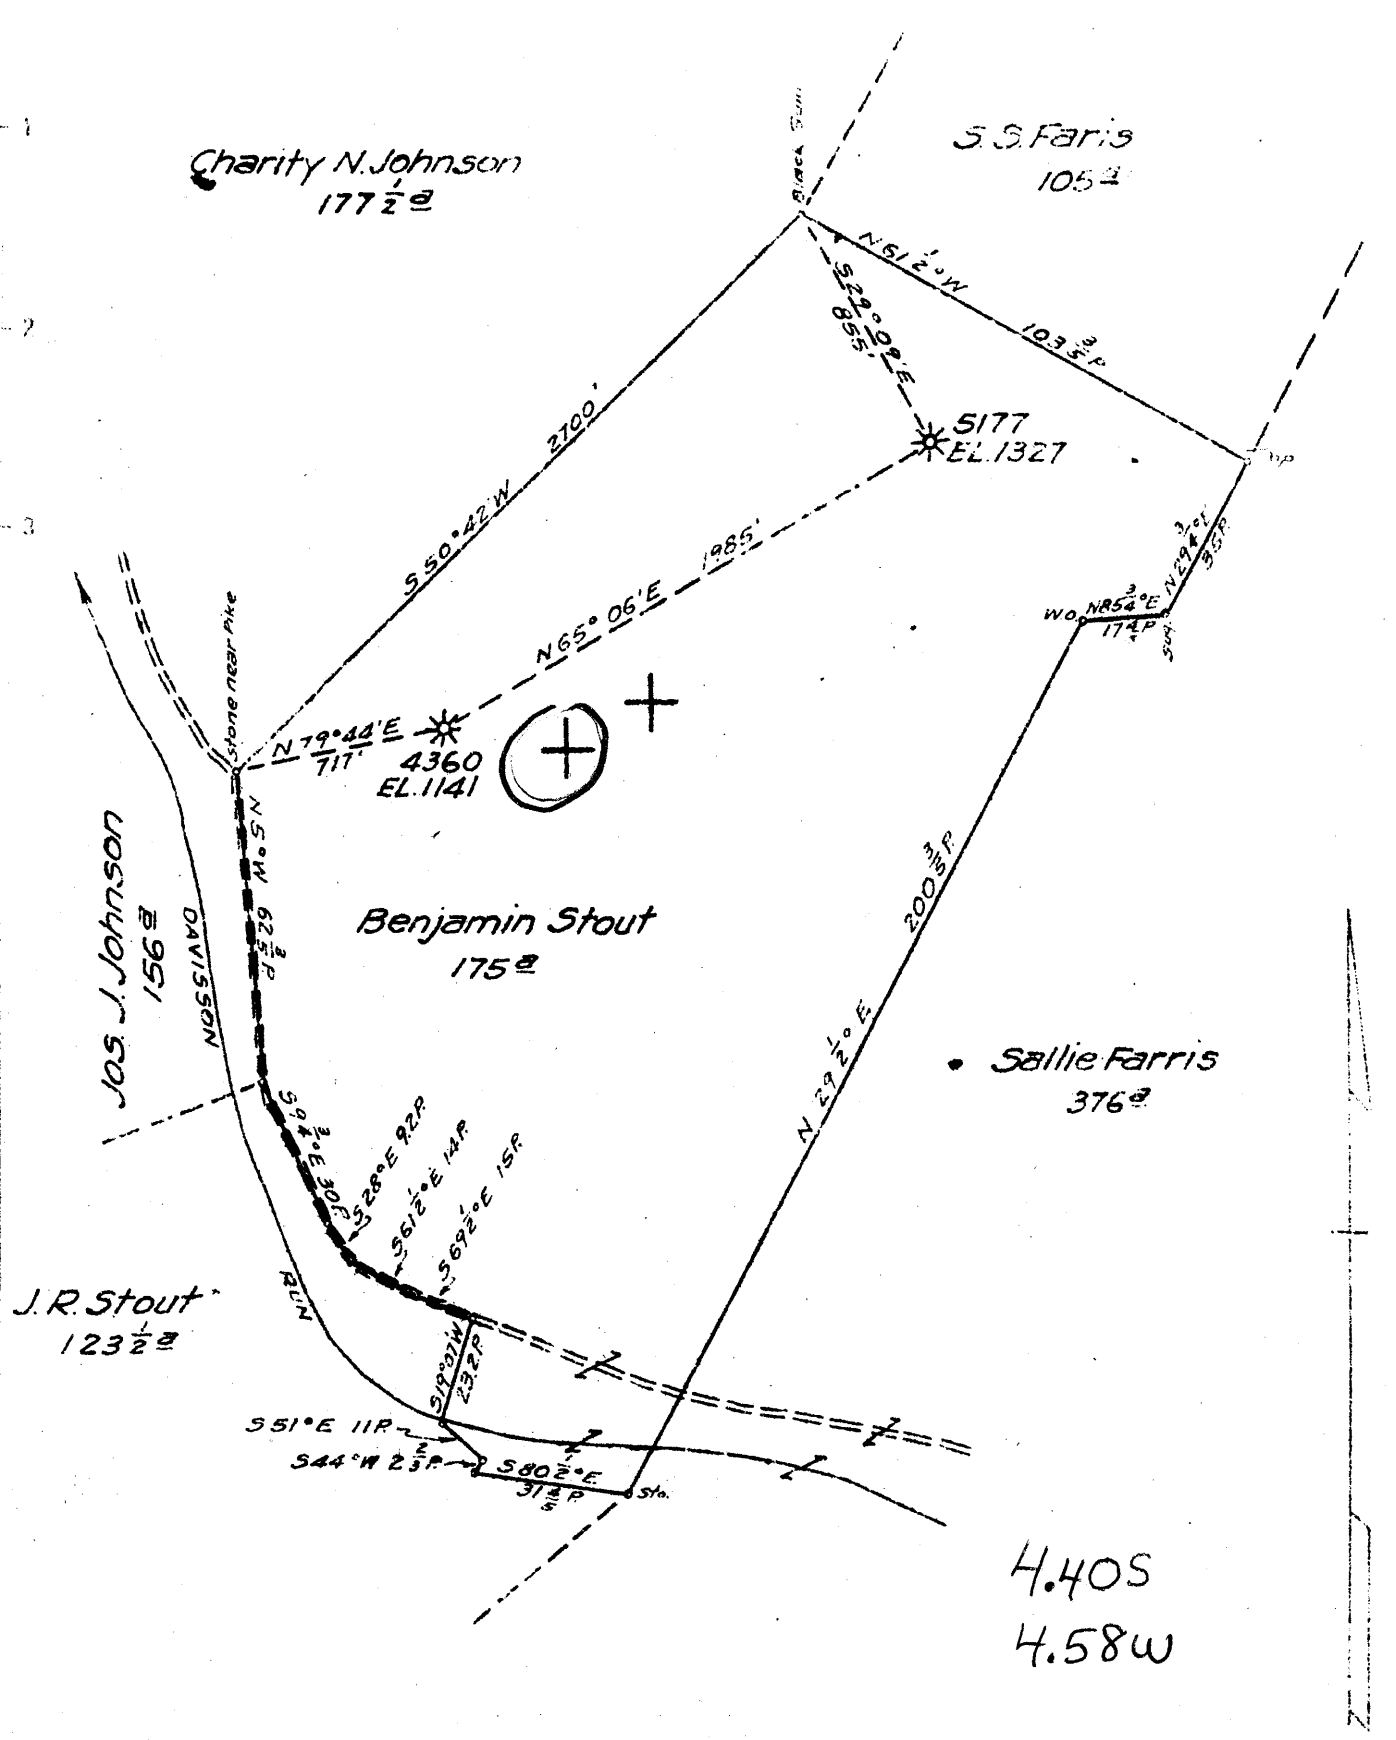

H.40S
H.58W

New Location
 Drill Deeper
 Abandonment (5177)

Map Sheet 43 Squares S13E20FB S14R31-32

Company Hope Natural Gas Co.
 Address Clarksburg, W. Va.
 Farm Benjamin Stout
 Tract _____ Acres 175 Lease No. 15638
 Well (Farm) No. _____ Serial No. See Above
 Elevation (Spirit Level) See Above
 Quadrangle Fairmont & Clarksburg
 County Harrison District Simpson
 Engineer W. M. Powers
 Engineer's Registration No. 900
 File No. _____ Drawing No. _____
 Date July 5, 1945 Scale 1" = 40 P.

STATE OF WEST VIRGINIA
 DEPARTMENT OF MINES
 OIL AND GAS DIVISION
 CHARLESTON


WELL LOCATION MAP
 FILE NO. H.A.R. - 878-A-5177
11AR-907^A No-4360

+ Denotes location of well on United States Topographic Maps, scale 1 to 62,500, latitude and longitude lines being represented by border lines as shown.
 - Denotes one inch spaces on border line of original tracing.

600'

Latitude 39° 20'

Longitude 80° 15'

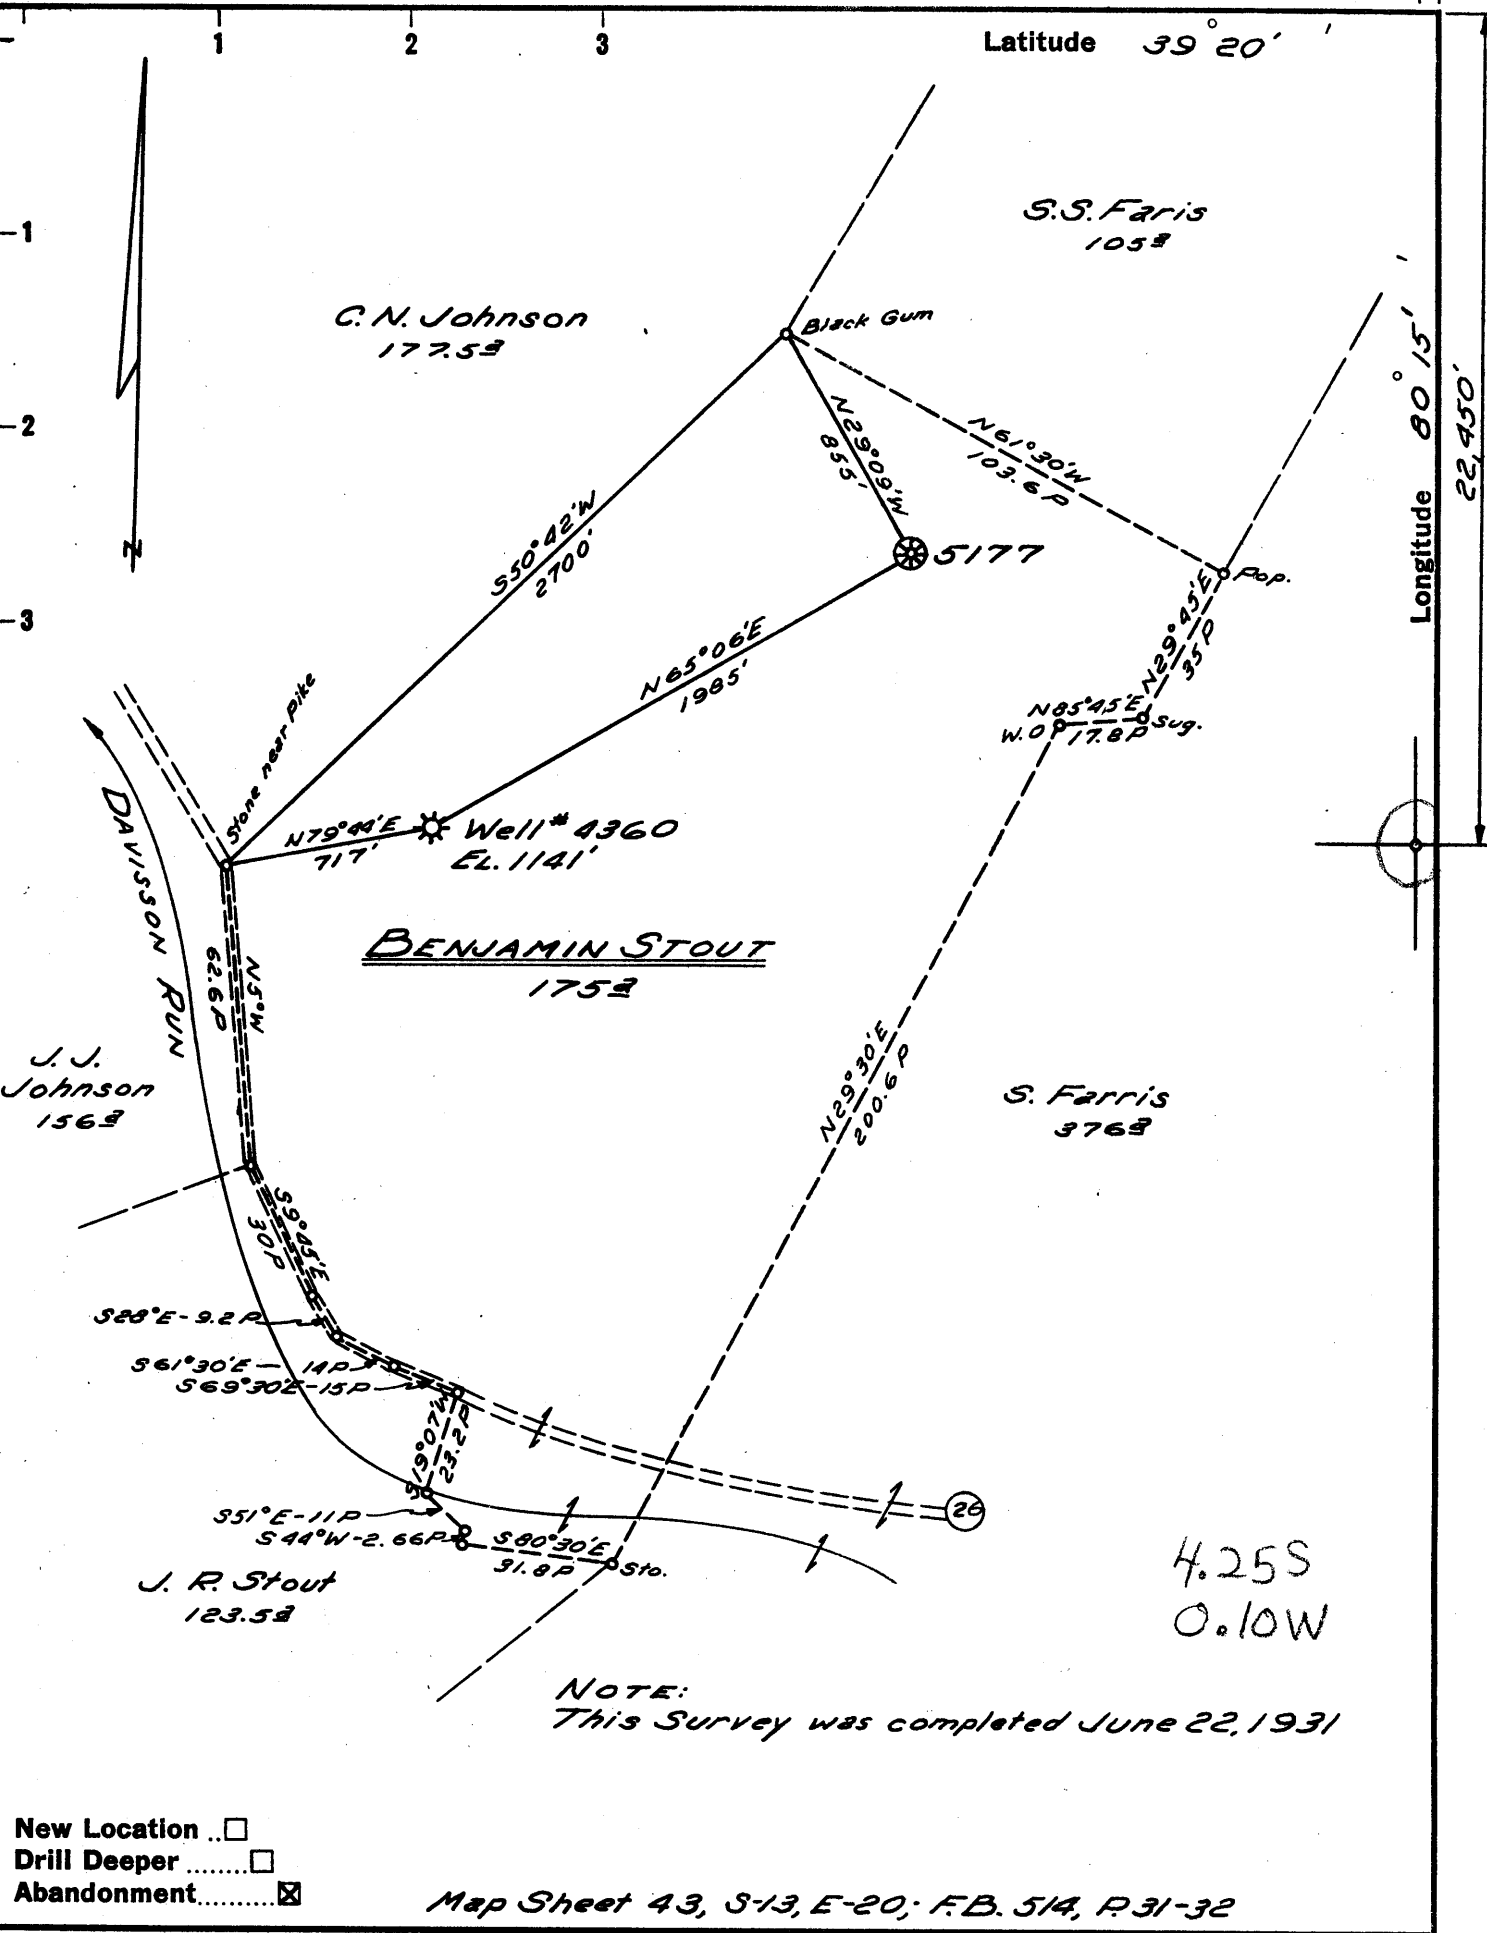

New Location ..
 Drill Deeper
 Abandonment.....

Map Sheet 43, S-13, E-20; F.B. 514, P.31-32

Company HOPE NATURAL GAS CO
 Address CLARKSBURG, W. VA.
 Farm BENJAMIN STOUT
 Tract _____ Acres 175 Lease No. 15638
 Well (Farm) No. _____ Serial No. 4360
 Elevation (Spirit Level) 1141'
 Quadrangle CLARKSBURG S. E.
 County HARRISON District SIMPSON
 Engineer Jackson M. Jarvis.
 Engineer's Registration No. 2397
 File No. _____ Drawing No. _____
 Date 10-18-63 Scale 1" = 40 FEET

STATE OF WEST VIRGINIA
 DEPARTMENT OF MINES
 OIL AND GAS DIVISION
 CHARLESTON

WELL LOCATION MAP
 FILE NO. HAR-1810-A

+ Denotes location of well on United States Topographic Maps, scale 1 to 62,500, latitude and longitude lines being represented by border lines as shown.
 - Denotes one inch spaces on border line of original tracing.