

3.76 S
0.52 W

New Location
Drill Deeper
Abandonment

X # 7575

F.B. # 527 P 4-5 MAP 43 - 513 E 19

Company **HOPE NATURAL GAS CO.**
 Address **CLARKSBURG, W. VA.**
 Farm **JESSIE C. BARNES**
 Tract **1** Acres **45** No. **45497**
 Well (Farm) No. **1-2-3-7** S. No. **7573-7575**
 Elevation Spirit Level **#1 - El. 1154** **#3 - El. 1066**
#2 - El. 1019 **#7 - El. 7581**
 Quadrangle **CLARKSBURG**
 County **HARRISON** District **SIMMONS**
 Engineer **J. H. Clark**
 Engineer's Registration No. **744**
 File No. _____ Drawing No. _____
 Date **JAN. 14 - 38** Scale **1" = 400'**

STATE OF WEST VIRGINIA
 DEPARTMENT OF MINES
 OIL AND GAS DIVISION
 CHARLESTON

WELL LOCATION MAP
 FILE NO. **HARR. 418-A-7575**
HAR-909-A; No. 7574

+ Denotes location of well on United States Topographic Maps, scale 1 to 62,500, latitude and longitude lines being represented by border lines as shown.

- Denotes one inch spaces on border line of original tracing.



STATE OF WEST VIRGINIA
DEPARTMENT OF MINES
OIL AND GAS DIVISION

750

WELL RECORD

Permit No. HAR 909-A


Oil or Gas Well (KIND)

Company Hope Natural Gas Company.
 Address 445 West Main St. Clarksburg, W. Va.
 Farm Jesse C. Barnes Acres 45
 Location (waters) _____
 Well No. 7574 Elev. 1019
 District Simpson County Harrison
 The surface of tract is owned in fee by _____
 Address _____
 Mineral rights are owned by _____
 Address _____
 Drilling commenced Purchased
 Drilling completed About May, 1918
 Date Shot _____ From _____ To _____
 With _____
 Open Flow _____ /10ths Water in _____ Inch
 _____ /10ths Merc. in _____ Inch
 Volume _____ Cu. Ft.
 Rock Pressure _____ lbs. _____ hrs.
 Oil _____ bbls., 1st 24 hrs.
 Fresh water none recorded feet _____ feet
 Salt water none recorded feet _____ feet

Casing and Tubing	Used in Drilling	Left in Well	Packers
Size			
16			Kind of Packer _____
13			
10	?		Size of _____
8 1/4	?		
6 5/8	675	675	Depth set _____
5 3/16			
3			Perf. top _____
2	2195	2195	Perf. bottom _____
Liners Used			Perf. top _____
			Perf. bottom _____

Annular space between tbg. & 6" casg. filled
 CASING CEMENTED SIZE No. Ft. Date
 none recorded
 COAL WAS ENCOUNTERED AT FEET INCHES
 FEET INCHES FEET INCHES
 FEET INCHES FEET INCHES

Formation	Color	Hard or Soft	Top	Bottom	Oil, Gas or Water	Depth Found	Remarks
	Big Injun		1212		gas	1225	
	Fifth		2183		gas	2212	
	Total depth			2234			

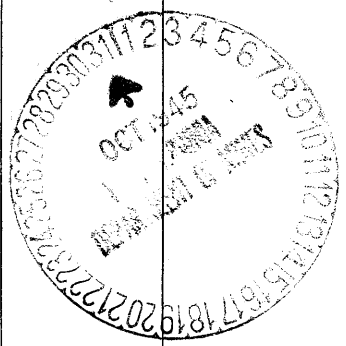

Formation	Color	Hard or Soft	Top	Bottom	Oil, Gas or Water	Depth Found	Remarks

Date October 29, 1945., 194

APPROVED Hope Natural Gas Company., Owner

By *[Signature]*
Ass't. to Gen. Sup'(title)

