

3.50S  
1.28W

New Location  
Drill Deeper  
Abandonment X 7545

F. 527 P. 10

Company Hope Natural Gas Co  
 Address Clarksburg, W. Va.  
 Farm Hannah C. Drummond  
 Tract Acres 20 Lease No. 45449  
 Well (Farm) No. \_\_\_\_\_ Serial No. 7544 7545  
 Elevation (Spirit Level) 1237 1212  
 Quadrangle Clarksburg  
 County Harrison District Simpson  
 Engineer W. M. Bowers  
 Engineer's Registration No. 400  
 File No. \_\_\_\_\_ Drawing No. \_\_\_\_\_  
 Date Nov. 6, 1 Scale 1" = 400'

STATE OF WEST VIRGINIA  
 DEPARTMENT OF MINES  
 OIL AND GAS DIVISION  
 CHARLESTON

WELL LOCATION MAP  
 FILE NO. HAR-541-A-N<sup>o</sup>754  
HAR-910-A-No. 7544

+ Denotes location of well on United States Topographic Maps, scale 1 to 62,500. latitude and longitude lines being represented by border lines as shown.  
 - Denotes one inch spaces on line of original tracing



STATE OF WEST VIRGINIA  
DEPARTMENT OF MINES  
OIL AND GAS DIVISION

754

WELL RECORD


Permit No. HAR-910-A Oil or Gas Well \_\_\_\_\_ (KIND)

Company Hope Natural Gas Company.  
 Address 445 West Main St. Clarksburg, W. Va.  
 Farm Hannah C. Drummond. Acres 20  
 Location (waters) \_\_\_\_\_  
 Well No. 7544 Elev. 1237  
 District Simpson County Harrison  
 The surface of tract is owned in fee by \_\_\_\_\_  
 Address \_\_\_\_\_  
 Mineral rights are owned by \_\_\_\_\_  
 Address \_\_\_\_\_  
 Drilling commenced \_\_\_\_\_  
 Drilling completed June 19, 1917  
 Date Shot \_\_\_\_\_ From \_\_\_\_\_ To \_\_\_\_\_  
 With Purchased  
 Open Flow \_\_\_\_\_ /10ths Water in \_\_\_\_\_ Inch  
 \_\_\_\_\_ /10ths Merc. in \_\_\_\_\_ Inch  
 Volume \_\_\_\_\_ Cu. Ft.  
 Rock Pressure \_\_\_\_\_ lbs. \_\_\_\_\_ hrs.  
 Oil \_\_\_\_\_ bbls., 1st 24 hrs.  
 Fresh water none recorded feet \_\_\_\_\_ feet  
 Salt water none recorded feet \_\_\_\_\_ feet

Casing and Tubing	Used in Drilling	Left in Well	Packers
Size			
16			Kind of Packer _____
13			
10	?		Size of _____
8 1/4	?		
6 5/8	1417'	1417	Depth set _____
5 3/16			
3			Perf. top _____
2	2547	2547	Perf. bottom _____
Liners Used _____			Perf. top _____
			Perf. bottom _____

Space between 6" casing & tubing filled with CASING CEMENTED SIZE No. Ft. cement. Date  
 None recorded  
 COAL WAS ENCOUNTERED AT \_\_\_\_\_ FEET \_\_\_\_\_ INCHES  
 \_\_\_\_\_ FEET \_\_\_\_\_ INCHES FEET \_\_\_\_\_ INCHES  
 \_\_\_\_\_ FEET \_\_\_\_\_ INCHES FEET \_\_\_\_\_ INCHES

Formation	Color	Hard or Soft	Top	Bottom	Oil, Gas or Water	Depth Found	Remarks
Little Dunkard			420	435			
Big Dunkard			540	560			
Gas Sand			625	680			
First Salt			775	910			
Second Salt			990	1060			
Little Lime			1425	1447			
Big Injun			1503	1635			
Fifty foot			1869	1915			
Thirty foot			2060	2135			
Stray			2205	2225			
Gordon			2290	2310			
Fourth			2370	2385	gas	2508- 2517	
Fifth			2467	2518			
Total depth				2547			

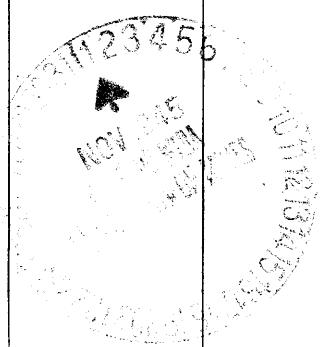

Formation	Color	Hard or Soft	Top	Bottom	Oil, Gas or Water	Depth Found	Remarks

Date October 30, 1945, 194

APPROVED Hope Natural Gas Company, Owner

By *[Signature]*  
 Ass't. to Gen. Sup't. (Title)

