

Map 5h. 43, Sq. 5-13E-20 F.B. 527 P 7

Company HOPE NATURAL GAS CO.  
 Address CLARKSBURG, W. VA.  
 Farm CHARITY N. JOHNSON  
 Tract \_\_\_\_\_ Acres 132 7/12 Lease No. 45445  
 Well (Farm) No. \_\_\_\_\_ Serial No. AS SHOWN  
 Elevation (Spirit Level) AS SHOWN  
 Quadrangle FAIRMONT & CLARKSBURG  
 County HARRISON District SIMPSON  
 Engineer W.M. Bowers  
 Engineer's Registration No. 900  
 File No. \_\_\_\_\_ Drawing No. \_\_\_\_\_  
 Date 10-29-45 Scale 1" = 600'

STATE OF WEST VIRGINIA  
 DEPARTMENT OF MINES  
 OIL AND GAS DIVISION  
 CHARLESTON

**WELL LOCATION MAP**  
 FILE NO. HAR-912-A  
 # 7539

+ Denotes location of well on United States Topographic Maps, scale 1 to 62,500, latitude and longitude lines being represented by border lines as shown.

- Denotes one inch spaces on border line of original tracing.



STATE OF WEST VIRGINIA  
DEPARTMENT OF MINES  
OIL AND GAS DIVISION

755

WELL RECORD


Permit No. 9100A ~~Oil~~ or Gas Well \_\_\_\_\_ (KIND)

Company Hope Natural Gas Company.  
 Address 445 West Main St. Clarksburg, W. Va.  
 Farm Charity N. Johnson Acres 132  
 Location (waters) \_\_\_\_\_  
 Well No. 7539 Elev. 1261  
 District Simpson County Harrison  
 The surface of tract is owned in fee by \_\_\_\_\_  
 Address \_\_\_\_\_  
 Mineral rights are owned by \_\_\_\_\_  
 Address \_\_\_\_\_  
 Drilling commenced \_\_\_\_\_  
 Drilling completed November, 1919  
 Date Shot \_\_\_\_\_ From \_\_\_\_\_ To \_\_\_\_\_  
 With Purchased well  
 Open Flow /10ths Water in \_\_\_\_\_ Inch  
 /10ths Merc. in \_\_\_\_\_ Inch  
 Volume \_\_\_\_\_ Cu. Ft.  
 Rock Pressure \_\_\_\_\_ lbs. \_\_\_\_\_ hrs.  
 Oil \_\_\_\_\_ bbls., 1st 24 hrs.  
 Fresh water \_\_\_\_\_ feet \_\_\_\_\_ feet  
 Salt water \_\_\_\_\_ feet \_\_\_\_\_ feet

Casing and Tubing	Used in Drilling	Left in Well	Packers
Size			
16			Kind of Packer _____
13			
10	?		Size of _____
8 1/4	?		
6 5/8	1392	1392	Depth set _____
5 3/16			
3			Perf. top _____
2	1450	1450	Perf. bottom _____
Liners Used			Perf. top _____
			Perf. bottom _____

~~Space between tbg. & 6" casing filled with~~  
 CASING CEMENTED \_\_\_\_\_ SIZE cement to surface. Date \_\_\_\_\_  
 \_\_\_\_\_ none recorded \_\_\_\_\_  
 COAL WAS ENCOUNTERED AT \_\_\_\_\_ FEET \_\_\_\_\_ INCHES  
 \_\_\_\_\_ FEET \_\_\_\_\_ INCHES FEET \_\_\_\_\_ INCHES  
 \_\_\_\_\_ FEET \_\_\_\_\_ INCHES FEET \_\_\_\_\_ INCHES

Formation	Color	Hard or Soft	Top	Bottom	Oil, Gas or Water	Depth Found	Remarks
	Big Lime		1330	1410			
	Big Injun		1410	1508	gas	1417	
	Fifty foot		1850	1900			
	Thirty foot		1908	1958			
	Fourth		2308	2330			
	Fifth		2381	2420			
	Total depth			2483			

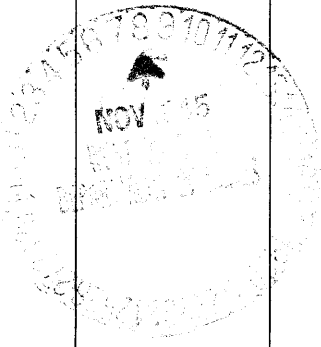

Formation	Color	Hard or Soft	Top	Bottom	Oil, Gas or Water	Depth Found	Remarks

Date October 30, 1945., 194

APPROVED Hope Natural Gas Company., Owner

By *[Signature]*  
Ass't. to Gen. Sup't.

