

5.35 S
• 40 W

5.30 S
0.41 W

New Location
 Drill Deeper
 Abandonment X-2975

F.B. # 537 P31-33 MAP 58-21966

Company HOPE NATURAL GAS Co.
 Address CLARKSBURG, W. VA
 Farm M. S. BELL
 Tract 1 Acres 97 Lease No. 2334
 Well (Farm) No. 1 Serial No. 2975
 Elevation (Spirit Level) SHOWN ABOVE
 Quadrangle VADIS
 County HARRISON District UNION
 Engineer W.M. Dowers
 Engineer's Registration No. 900
 File No. _____ Drawing No. _____
 Date AUG. 6, 1945 Scale 1" = 40 P

STATE OF WEST VIRGINIA
 DEPARTMENT OF MINES
 OIL AND GAS DIVISION
 CHARLESTON

WELL LOCATION MAP
 FILE NO. HAR-915-A
#2975

+ Denotes location of well on United States Topographic Maps, scale 1 to 62,500, latitude and longitude lines being represented by border lines as shown.

- Denotes one inch spaces on border line of original tracing.



751

STATE OF WEST VIRGINIA
DEPARTMENT OF MINES
OIL AND GAS DIVISION

WELL RECORD

Permit No. 40 40-915-A


~~Oil~~ Oil or Gas Well _____ (KIND)

Company Hope Natural Gas Company.
 Address 445 West Main St. Clarksburg, W. Va.
 Farm M.S. Bell Acres 97
 Location (waters) 2978 (1)
 Well No. _____ Elev. 1206
 District Union County Harrison
 The surface of tract is owned in fee by _____
 Address _____
 Mineral rights are owned by _____
 Address _____
 Drilling commenced May 23, 1913
 Drilling completed June 25, 1913
 Date Shot _____ From _____ To _____
 With _____
 Open Flow _____ /10ths Water in _____ Inch
 _____ /10ths Merc. in _____ Inch
 Volume _____ Cu. Ft.
 Rock Pressure _____ lbs. _____ hrs.
 Oil _____ bbls., 1st 24 hrs.
 Fresh water _____ feet _____ feet
 Salt water none recorded feet _____ feet

Casing and Tubing	Used in Drilling	Left in Well	Packers
Size			Kind of Packer
16			
13			
10	350	Pulled	Size of
8 1/4	1370	Pulled	
6 5/8	1903	1903	Depth set
5 3/16			
3			Perf. top
2	2361	2361	Perf. bottom
Liners Used			Perf. top
			Perf. bottom

Not cemented
 CASING CEMENTED _____ SIZE _____ No. Ft. _____ Date _____
None
 COAL WAS ENCOUNTERED AT 307 FEET 24 INCHES
612 FEET 36 INCHES FEET INCHES
 FEET INCHES FEET INCHES


Formation	Color	Hard or Soft	Top	Bottom	Oil, Gas or Water	Depth Found	Remarks
Native coal			307	309			
Pittsburgh Coal			612	615			
Little Dunkard			795	845			
Big Dunkard			934	970			
Sand			998	1078			
Gas sand			1130	1180			
First Salt			1273	1406			
Second Salt			1446	1479			
Maxon			1645	1729			
Big Lime			1765	1829			
Big Injun			1829	1920			
Berea			2091	2107			
Gambz			2200	2211	gas	2204- 2209	
Fifty foot			2294	2314			
Thirty Foot			2319	2331	gas	2327	
Gordon stray			2386	2409			
Gordon			2435	2458			
Total depth				2846 1/2			
Filled back to				2361 1/2			

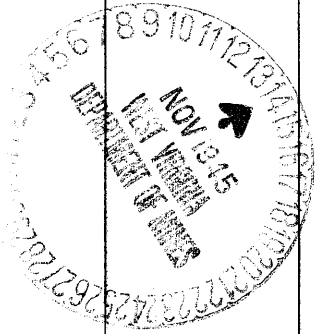

Formation	Color	Hard or Soft	Top	Bottom	Oil, Gas or Water	Depth Found	Remarks

Date **November 12, 1945.** _____, 194

APPROVED **Hope Natural Gas Company.** _____, Owner

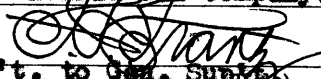By  _____
 Ass't. to Gen. Supp't.

