

3.42 S
3.53 W

J. H. Morrison

Beuna W. Brown

Garrett - Payne
143^a

Hattie Goff Porter

Johnson
Fleming

Mary Goff Lowndes

3.40 S
3.50 W

- New Location
- Drill Deeper
- Abandonment X 7969

Map Sheet 44 Squares S12E12 FB 777 P 35

Company HOPE NATURAL GAS CO.
 Address CLARKSBURG, W. VA.
 Farm Garrett - Payne
 Tract _____ Acres 143 Lease No. 52706
 Well (Farm) No. 1 Serial No. 7969
 Elevation (Spirit Level) 992
 Quadrangle CLARKSBURG
 County HARRISON District CLARK
 Engineer W. M. Brewer
 Engineer's Registration No. 900
 File No. _____ Drawing No. _____
 Date Nov. 26, 1945 Scale. 1" = 40P

STATE OF WEST VIRGINIA
 DEPARTMENT OF MINES
 OIL AND GAS DIVISION
 CHARLESTON

WELL LOCATION MAP
 FILE NO. HAR-930-A

7969

+ Denotes location of well on United States Topographic Maps, scale 1 to 62,500, latitude and longitude lines being represented by border lines as shown.

- Denotes one inch spaces on border line of original tracing

Longitude 80 20



STATE OF WEST VIRGINIA
DEPARTMENT OF MINES
OIL AND GAS DIVISION

776

WELL RECORD


Permit No. 930 A ~~Oil~~ or Gas Well _____ (KIND)

Company Hops Natural Gas Company.
 Address 445 west Main St. Clarksburg, W. Va.
 Farm Garrett-Payne Acres 145
 Location (waters) (D)
 Well No. 7969 Elev. 992
 District Clark County Harrison
 The surface of tract is owned in fee by _____
 Address _____
 Mineral rights are owned by _____
 Address _____
 Drilling commenced December 2, 1908
 Drilling completed January 12, 1909
 Date Shot _____ From _____ To _____
 With _____
 Open Flow _____ /10ths Water in _____ Inch
 _____ /10ths Merc. in _____ Inch
 Volume _____ Cu. Ft.
 Rock Pressure _____ lbs. _____ hrs.
 Oil _____ bbls., 1st 24 hrs.
 Fresh water _____ feet _____ feet
 Salt water 684 760 feet _____ feet

Casing and Tubing	Used in Drilling	Left in Well	Packers
Size			
16			Kind of Packer _____
13			
10	202	Pulled	Size of _____
8 1/4	845	Pulled	
6 5/8	1454	1454	Depth set _____
5 3/16	2046	2046	
3			Perf. top _____
2	2911	2911	Perf. bottom _____
Liners Used			Perf. top _____
			Perf. bottom _____

Not cemented
 CASING CEMENTED _____ SIZE _____ No. Ft. _____ Date _____
none recorded
 COAL WAS ENCOUNTERED AT _____ FEET _____ INCHES
 _____ FEET _____ INCHES FEET _____ INCHES
 _____ FEET _____ INCHES FEET _____ INCHES

Formation	Color	Hard or Soft	Top	Bottom	Oil, Gas or Water	Depth Found	Remarks
Little Dunkard			330	410			
Big Dunkard			455	560			
Gas sand			565	600			
First Salt			676	830	water	684- 760	
Second Salt			840	960			
Big Lime			1217	1312			
Big Injun			1312	1392			
Squaw			1470	1490			
Gantz			1700	1740			
Berea			1700	1740			
Fifty foot			1765	1874			
Gordon stray			2030	2058	gas	2047	
Fourth			2119	2132			
Fifth			2190	2211	gas	2192	
Speechley			2890	2900	gas	2892	
Total depth				2911			

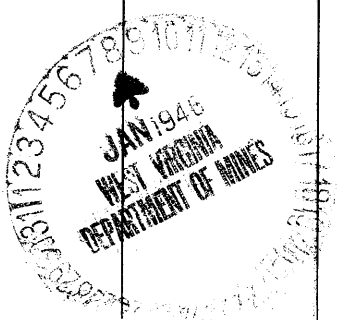

Formation	Color	Hard or Soft	Top	Bottom	Oil, Gas or Water	Depth Found	Remarks

Date January 4, 1946, 194

APPROVED Hope Natural Gas Company., Owner

By [Signature] General Superintendent.

