

New Location
 Drill Deeper
 Abandonment

MAP SHT. #68 S14 E14 F.B. 510 PT

Company HOPE NATURAL GAS CO.
 Address CLARKSBURG W.VA.
 Farm BEN. B. STOUT
 Tract _____ Acres 375 Lease No. 44567
 Well (Farm) No. _____ Serial No. 7320
 Elevation (Spirit Level) 1114
 Quadrangle CLARKSBURG
 County HARRISON District CLARK
 Engineer W.M. Bowers
 Engineer's Registration No. 900
 File No. _____ Drawing No. _____
 Date 1-11-46 Scale 1 IN = 500'

STATE OF WEST VIRGINIA
 DEPARTMENT OF MINES
 OIL AND GAS DIVISION
 CHARLESTON

WELL LOCATION MAP
 FILE NO. HAR-933-A

+ Denotes location of well on United States Topographic Maps, scale 1 to 62,500, latitude and longitude lines being represented by border lines as shown.

- Denotes one inch spaces on border line of original tracing.

JAE



STATE OF WEST VIRGINIA
DEPARTMENT OF MINES
OIL AND GAS DIVISION

778

WELL RECORD


Permit No. 933-A Oil or Gas Well _____ (KIND)

Company Hope Natural Gas Company.
Address 445 West Main St. Clarksburg, W. Va.
Farm B.B. Stout Acres 375
Location (waters) _____
Well No. 7320 Elev. 1114
District Clark County Harrison
The surface of tract is owned in fee by _____
Address _____
Mineral rights are owned by _____
Address _____
Drilling commenced September 17, 1914
Drilling completed November 2, 1914
Date Shot _____ From _____ To _____
With _____
Open Flow _____ /10ths Water in _____ Inch
_____ /10ths Merc. in _____ Inch
Volume _____ Cu. Ft.
Rock Pressure _____ lbs. _____ hrs.
Oil _____ bbls., 1st 24 hrs.
Fresh water none recorded feet _____ feet
Salt water none recorded feet _____ feet

Casing and Tubing	Used in Drilling	Left in Well	Packers
Size			
16			Kind of Packer _____
13			
10	205	205	Size of _____
8 1/4	1018	1018	
6 5/8	1652	1652	Depth set _____
5 3/16			
3			Perf. top _____
2	2464	Pulled	Perf. bottom _____
Liners Used			Perf. top _____
			Perf. bottom _____

Not cemented
CASING CEMENTED _____ SIZE _____ No. Ft. _____ Date _____
none recorded
COAL WAS ENCOUNTERED AT _____ FEET _____ INCHES
_____ FEET _____ INCHES FEET _____ INCHES
_____ FEET _____ INCHES FEET _____ INCHES

Formation	Color	Hard or Soft	Top	Bottom	Oil, Gas or Water	Depth Found	Remarks
Little Dunkard			280	305			
Big Dunkard			365	395			
First Salt			720	795			
Second Salt			815	1000			
Maxon			1180	1205			
Big Lime			1445	1510			
Big Injun			1510	1592			
Gantz			1900	1920			
Fifty foot			1940	2075	show gas	2005	
Thirty foot			2080	2135			
Gordon stray			2205	2230			
Gordon			2280	2310			
Fourth			2347	2368			
Fifth			2421	2447	gas	2429- 2442	
Total depth				2466			

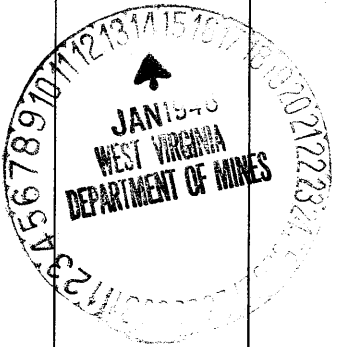

Formation	Color	Hard or Soft	Top	Bottom	Oil, Gas or Water	Depth Found	Remarks

Date **January 11, 1946**, 194

APPROVED **Hope Natural Gas Company.**, Owner

By **J. A. Clark**
General Superintendent.